

CLEARING AND GRUBBING, INCLUDING INDIVIDUAL TREES AND STUMPS  
200+42.0 LT-RT - 206+50.0 LT-RT

STONE FILL, TYPE 11  
201+55.0 LT - 203+50.0 LT  
201+60.0 RT - 204+50.0 RT




GRUBBING MATERIAL  
201+55.0 LT - 203+50.0 LT  
201+60.0 RT - 204+50.0 RT

SPECIAL PROVISION (STONE FILL, SLOPE ARMORING)  
200+75.0 LT-RT - 206+50.0 LT-RT

SPECIAL PROVISION (STONE FILL, CHANNEL ARMORING)  
200+75.0 LT-RT - 206+50.0 LT-RT

EXISTING DRAINAGE  
5 200+52.2 - 200+72.8 RT  
24" CPEP - RELAYING PIPE CULVERTS, AND EXTEND

NEW DRAINAGE  
200+52.0 - 200+72.0  
~~200+52.4 - 200+75.0~~  
24" CPEP - RELAYING PIPE CULVERTS, AND EXTEND 24" CPEP 1.6'  
INVERT IN: 1328.14, INVERT OUT: 1327.60  
NOTE: OLD PIPE LOCATION AND THE NEW PIPE SHALL BE BACKFILLED WITH SUITABLE FILL.

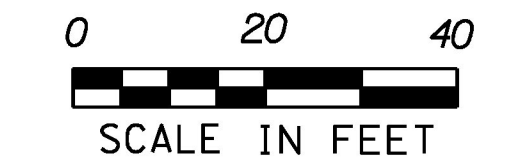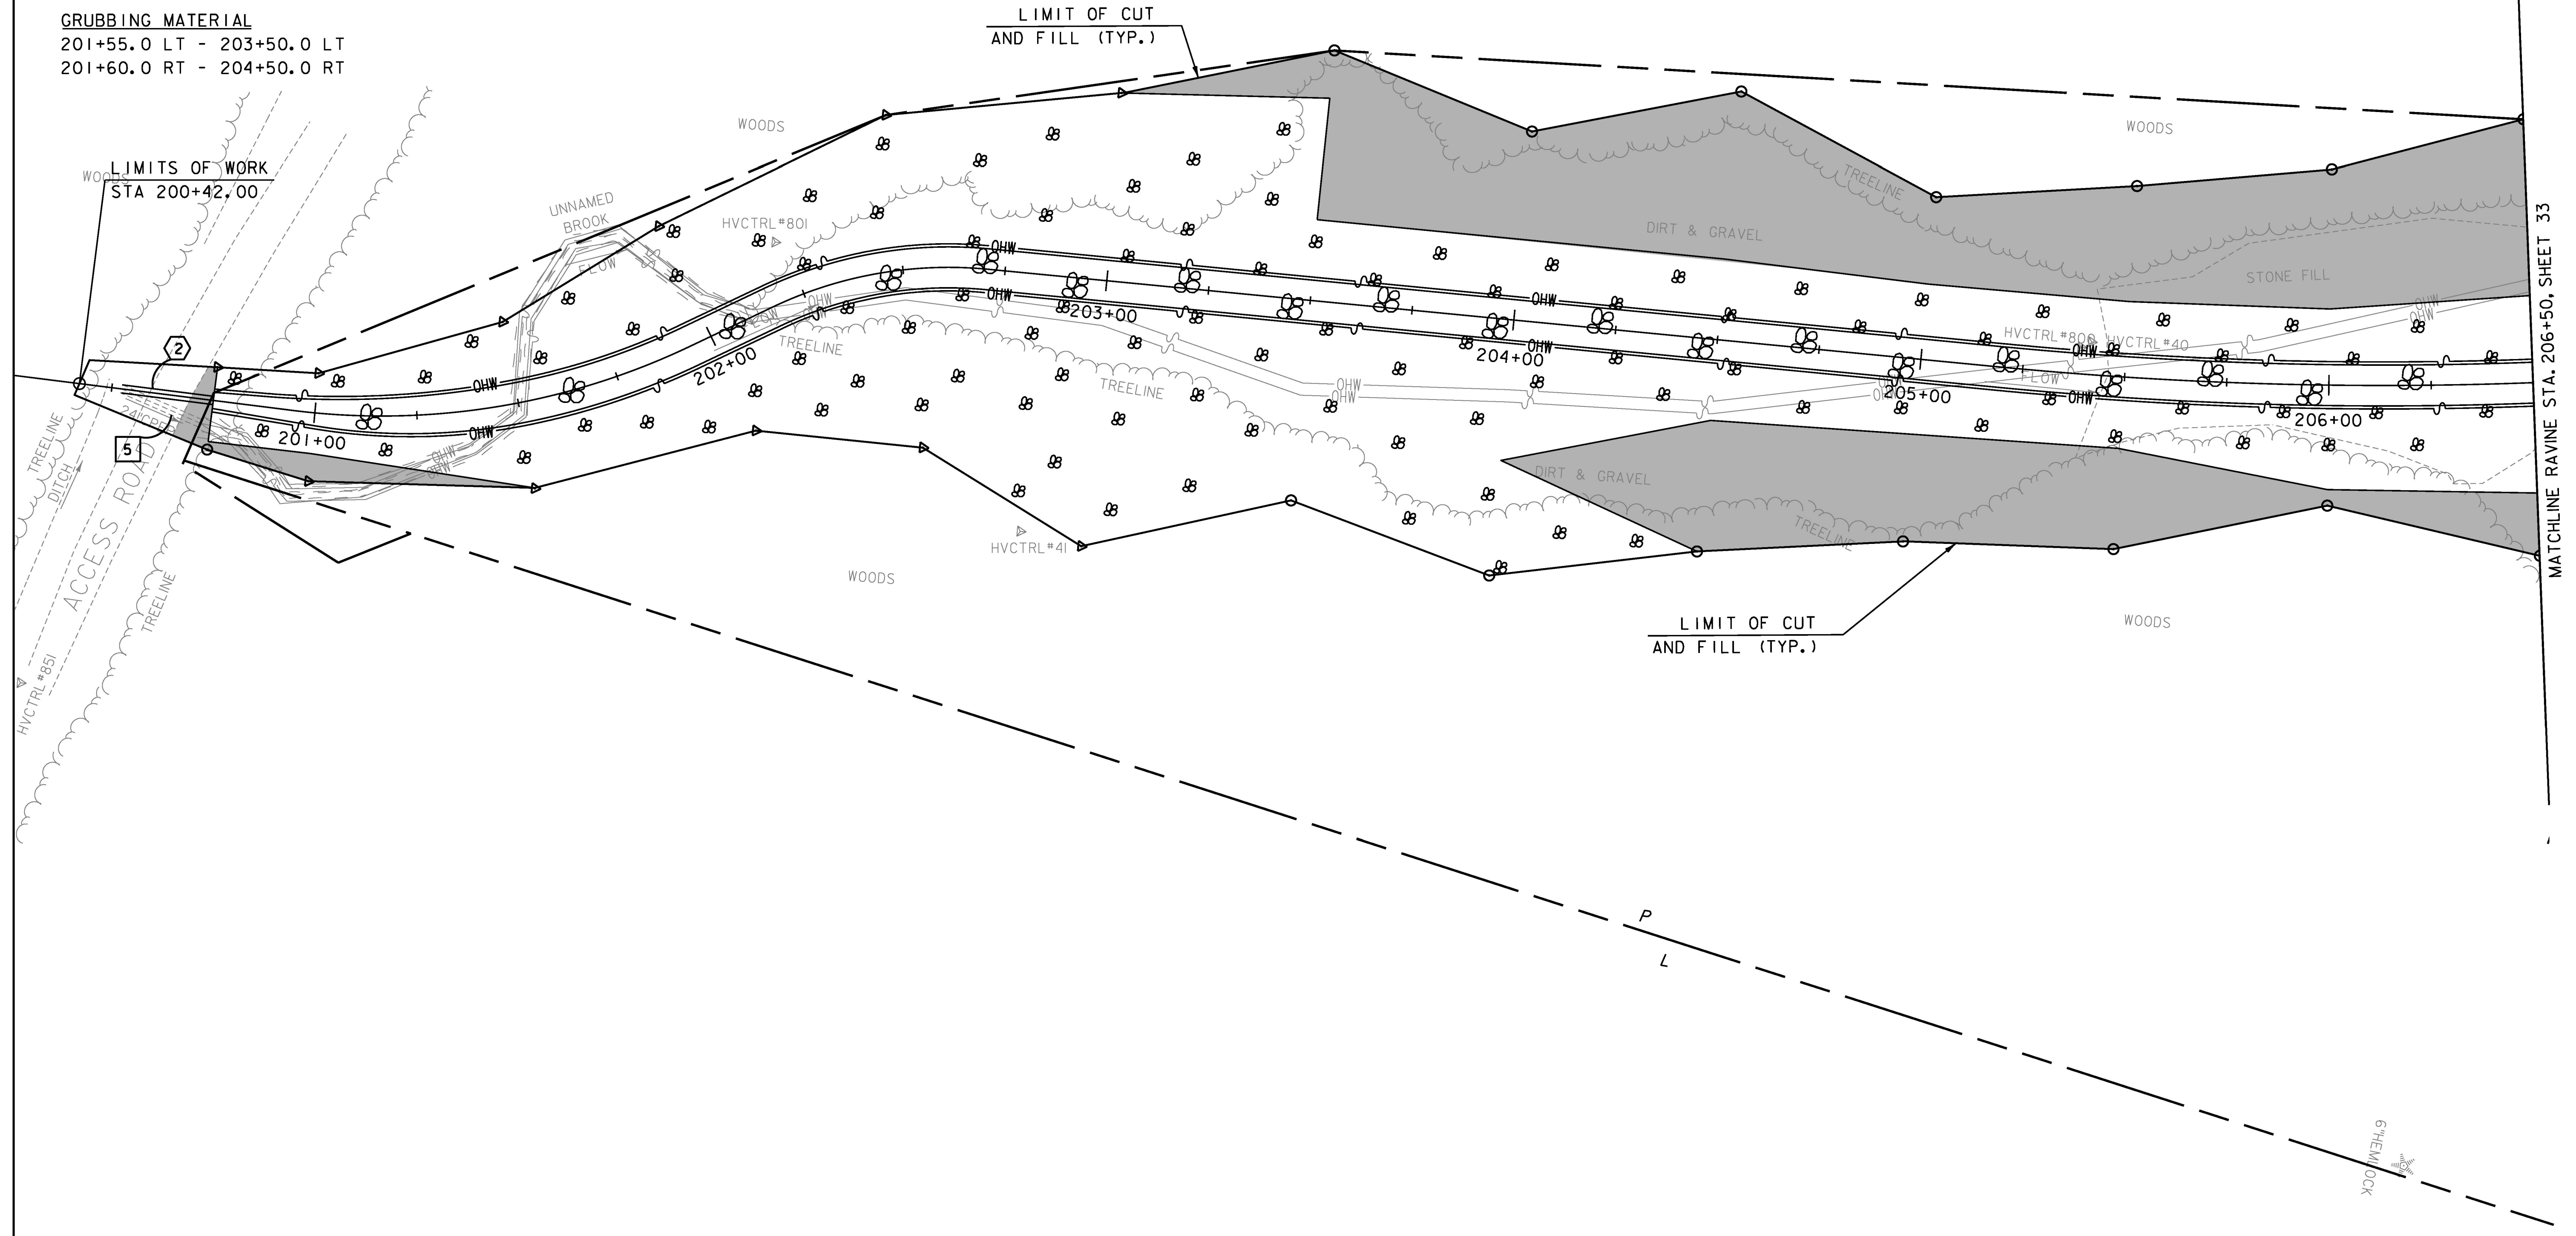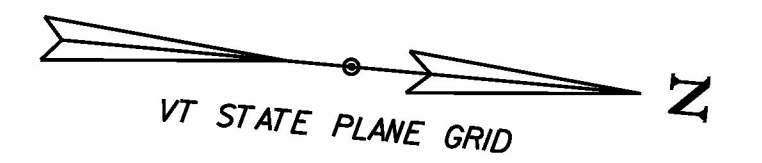

GREEN INTERNATIONAL AFFILIATES, INC.  
CIVIL AND STRUCTURAL ENGINEERS

PROJECT NAME: MENDON	PLOT DATE: 11/24/2015
PROJECT NUMBER: ER 020-2(39)	DRAWN BY: S. SOLLA
FILE NAME: z13bi88bdr.dgn	CHECKED BY: E. ATKINS
PROJECT LEADER: E. ATKINS	SHEET 35 OF 72
DESIGNED BY: M. BRADLEY	
PLAN SHEET 3	