


REFER TO DETAIL SHEET I FOR TRENCH REQUIREMENTS

MATERIAL TRANSITION DETAIL
NOT TO SCALE

US ROUTE 4

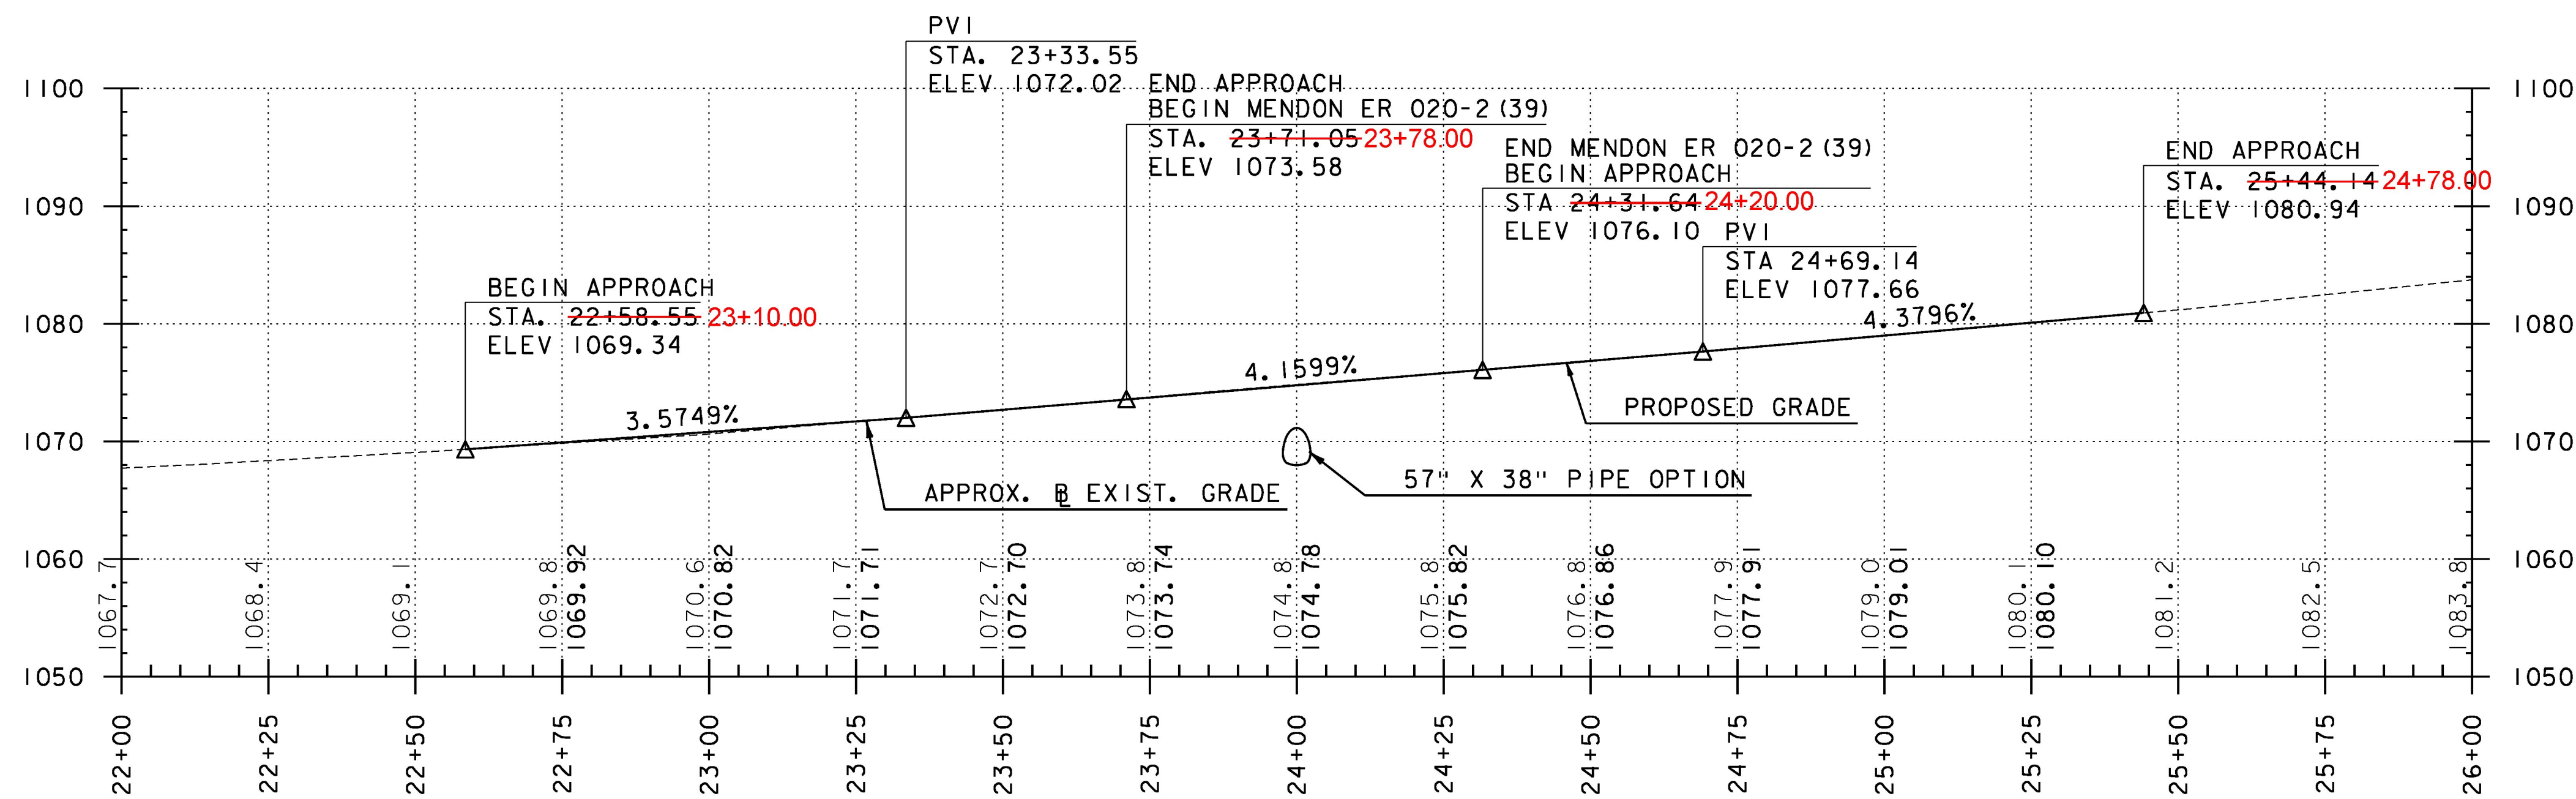

THE GRADES SHOWN TO THE NEAREST TENTH ARE THE ORIGINAL GROUND APPROXIMATE ELEVATIONS ALONG THE PROPOSED ALIGNMENT. THE GRADES SHOWN TO THE NEAREST HUNDREDTH ARE THE PROPOSED PROFILE GRADES FOR THE NEW ALIGNMENT.

- NOTES:
1. ALL STATIONS AND ELEVATIONS ARE SHOWN IN FEET.
 2. THE PROFILE IS PROVIDED FOR INFORMATION ONLY, THE CONTRACTOR SHALL MATCH TO EXISTING PROFILES GRADES

PROJECT NAME: MENDON
PROJECT NUMBER: ER 020-2(39)

FILE NAME: z13bi88xsl.dgn
PROJECT LEADER: E. ATKINS
DESIGNED BY: M. BRADLEY
US ROUTE 4 PROFILE SHEET 1

PLOT DATE: 11/13/2015
DRAWN BY: M. BRADLEY
CHECKED BY: E. ATKINS
SHEET 36 OF 72

