


# RAVINE

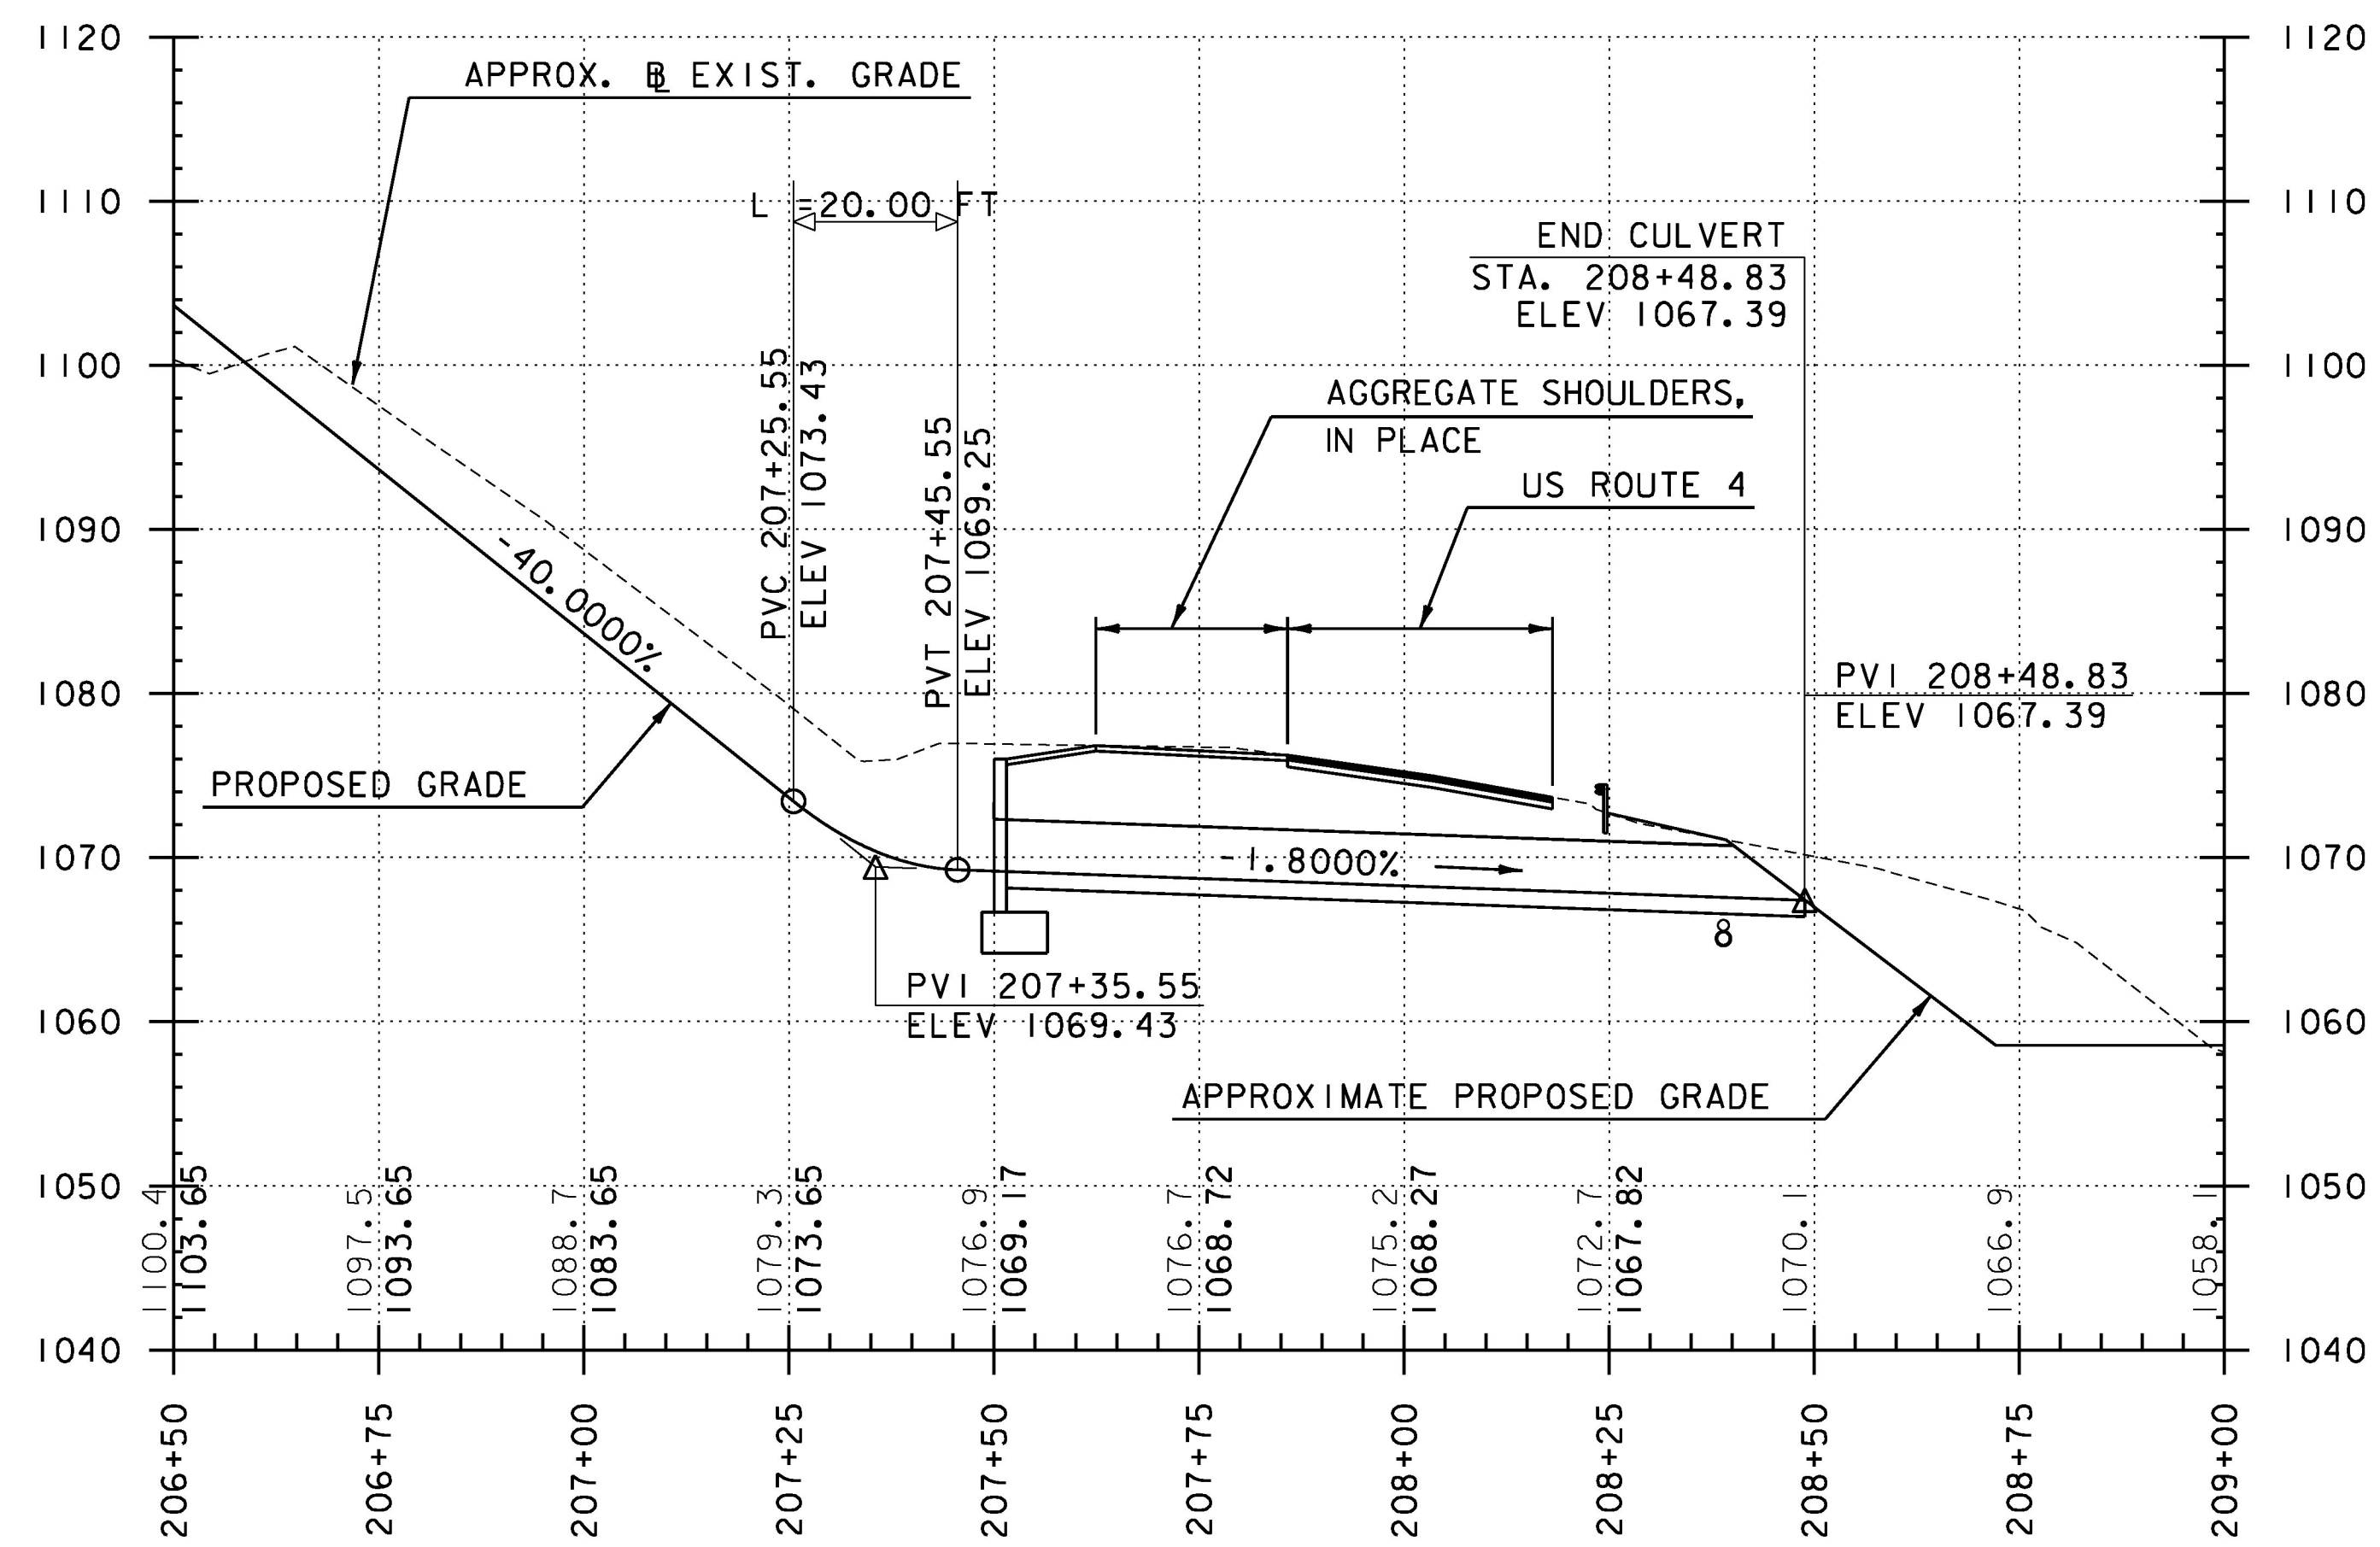

THE GRADES SHOWN TO THE TENTH HUNDREDTH ARE THE EXISTING GROUND ELEVATIONS ALONG THE NEW ALIGNMENT. THE GRADES SHOWN TO THE NEAREST HUNDREDTH ARE THE PROPOSED GRADES FOR THE NEW ALIGNMENT.

NOTE:  
1. ALL STATIONS AND ELEVATIONS ARE SHOWN IN FEET.



PROJECT NAME: MENDON  
PROJECT NUMBER: ER 020-2(39)

FILE NAME: z13bi88xsl.dgn  
PROJECT LEADER: E. ATKINS  
DESIGNED BY: M. BRADLEY  
RAVINE PROFILE SHEET 2

PLOT DATE: 11/13/2015  
DRAWN BY: S. SOLLA  
CHECKED BY: E. ATKINS  
SHEET 38 OF 72