

SEED, WINTER RYE
 200+66.2 RT - 201+50.0 RT
 203+00.0 LT - 206+50.0 LT
 204+00.0 RT - 206+50.0 RT

HAY MULCH
 200+66.2 RT - 201+50.0 RT
 203+00.0 LT - 206+50.0 LT
 204+00.0 RT - 206+50.0 RT

PROJECT DEMARCATION FENCE
 200+31.6 LT - 206+50.0 LT
 200+31.6 RT - 206+50.0 RT

SPECIAL PROVISION
 (TEMPORARY RELOCATION OF STREAM)
 200+50.0 LT - 206+50.0 LT


FERTILIZER
 200+66.2 RT - 201+50.0 RT
 203+00.0 LT - 206+50.0 LT
 204+00.0 RT - 206+50.0 RT

TOP SOIL
 200+66.2 RT - 201+50.0 RT
 203+00.0 LT - 206+50.0 LT
 204+00.0 RT - 206+50.0 RT

SPECIAL PROVISION
 (NATIVE STEEP SLOPE SEED MIX)
 200+66.2 RT - 201+50.0 RT
 203+00.0 LT - 206+50.0 LT
 204+00.0 RT - 206+50.0 RT

AGRICULTURAL LIMESTONE
 200+66.2 RT - 201+50.0 RT
 203+00.0 LT - 206+50.0 LT
 204+00.0 RT - 206+50.0 RT

TEMPORARY EROSION MATTING
 200+66.2 RT - 206+50.0 RT
 201+50.0 LT - 206+50.0 LT

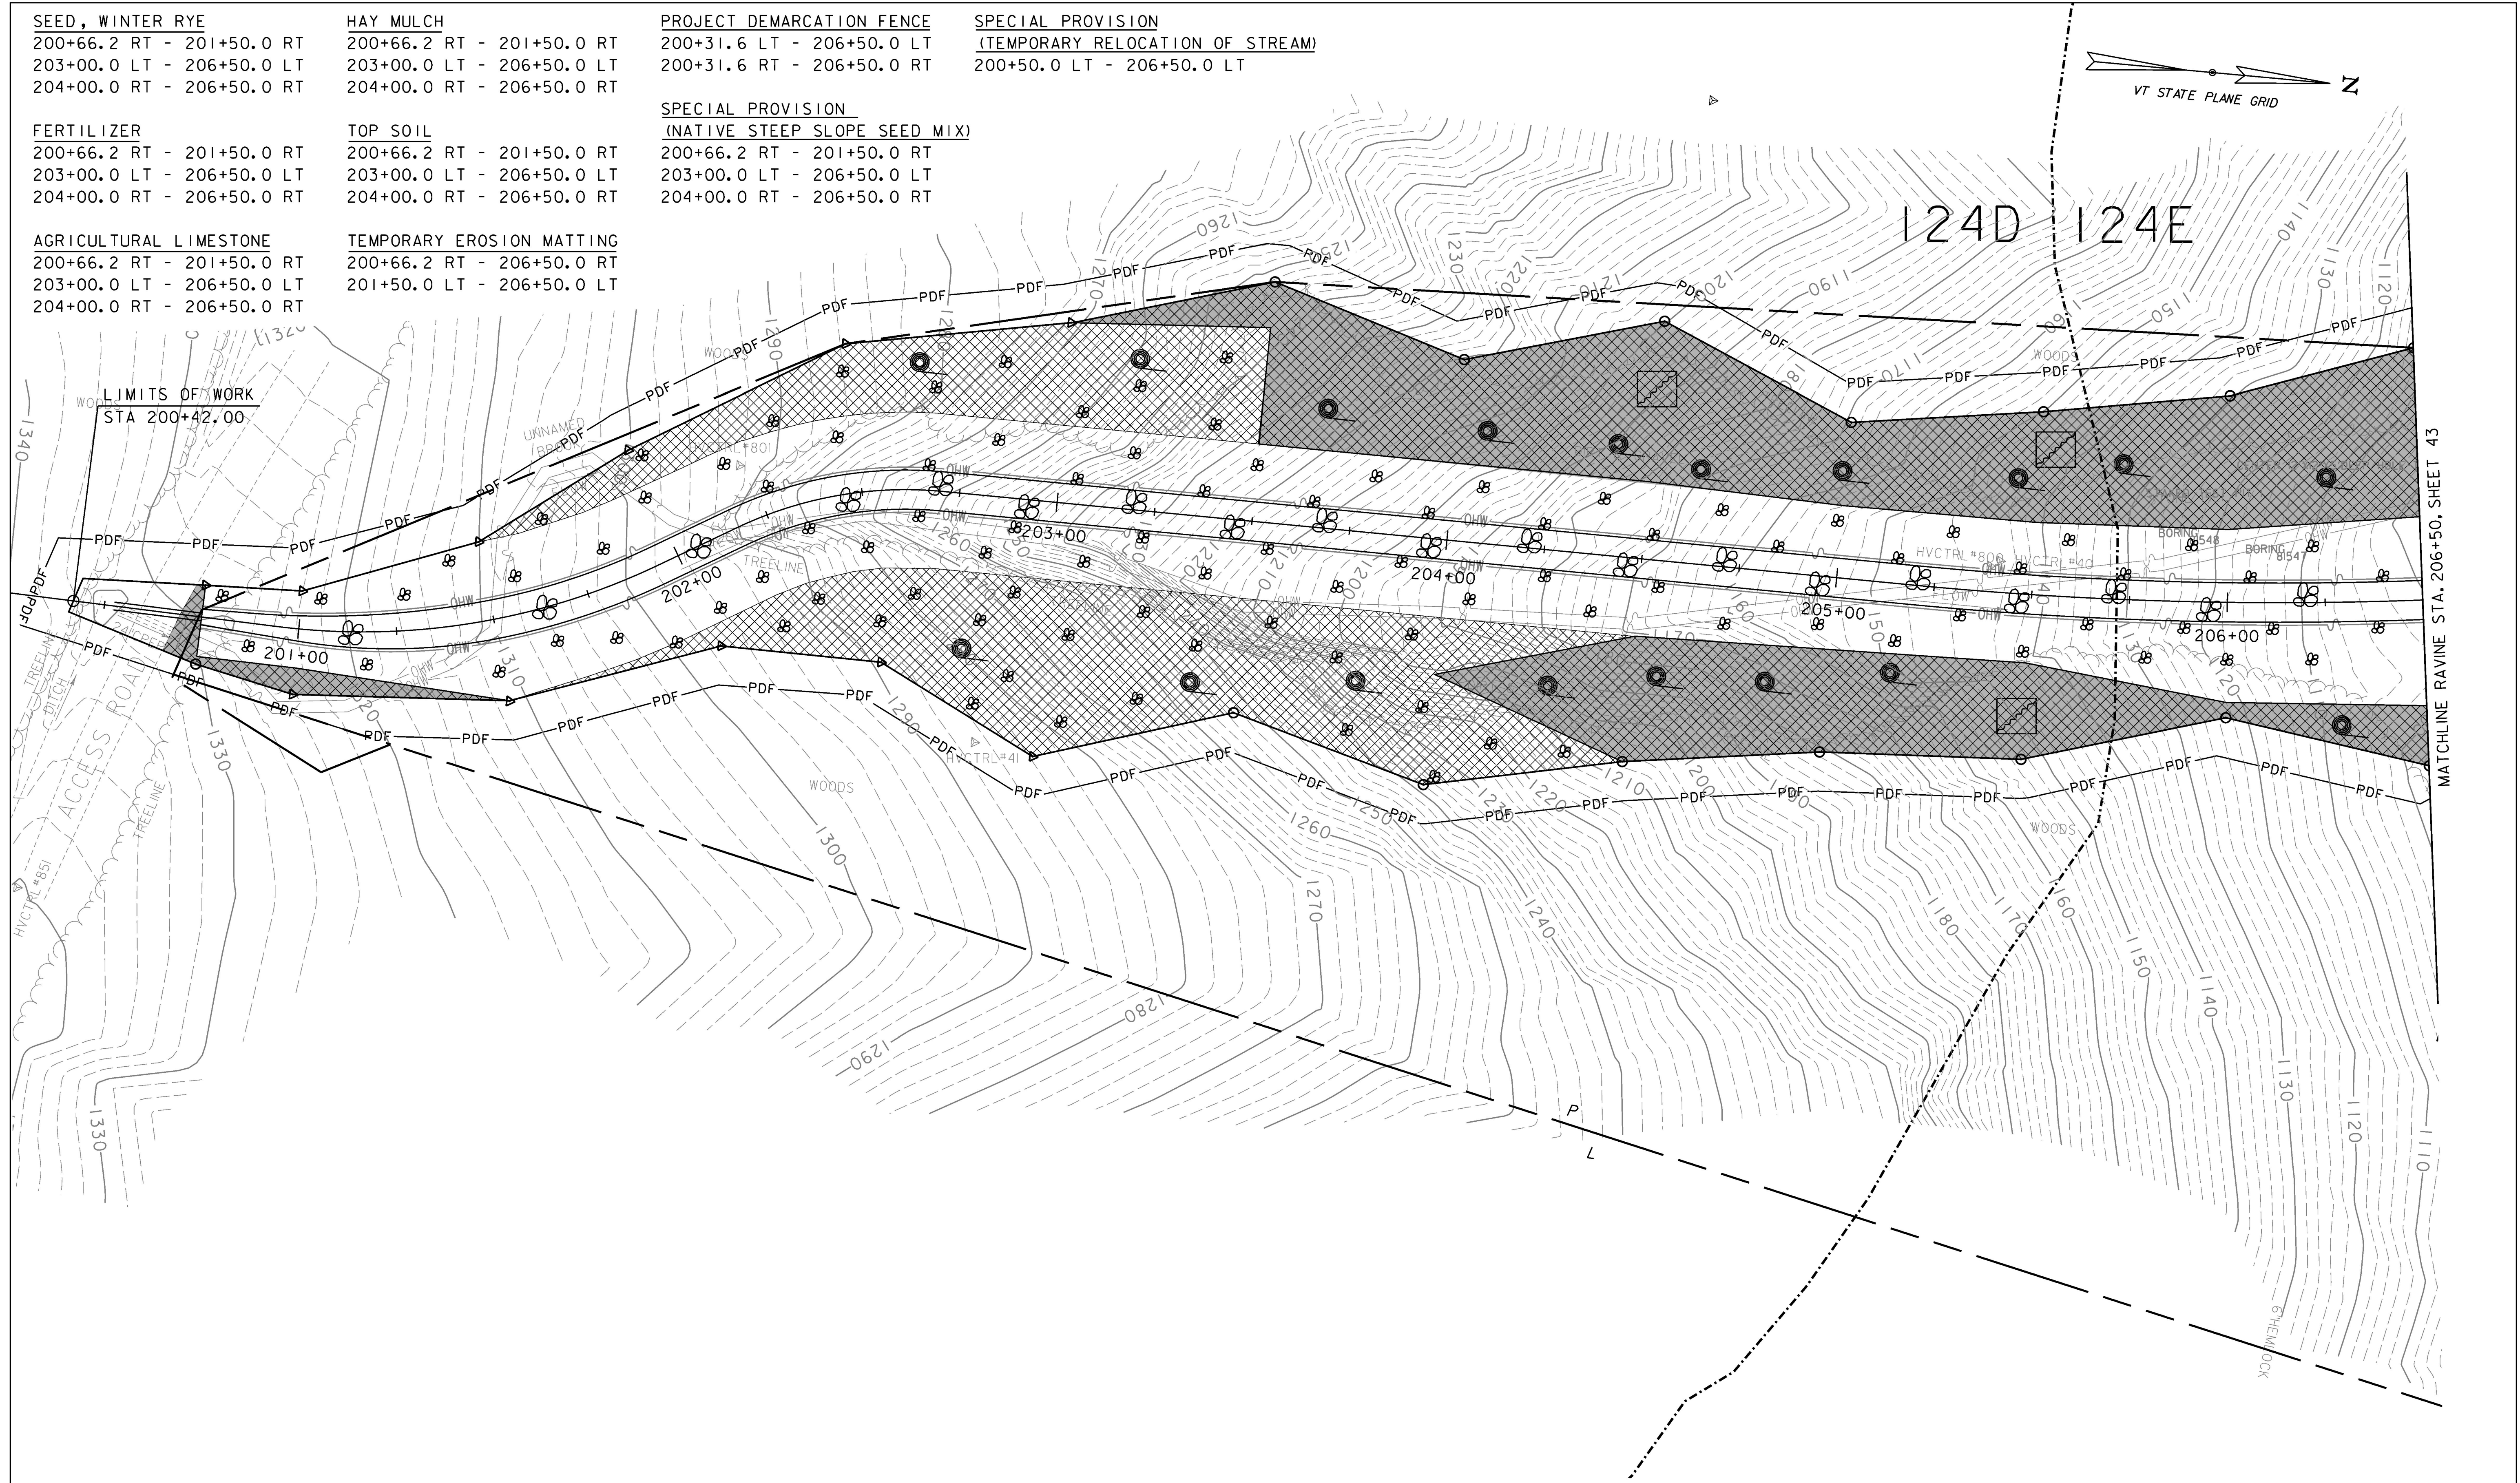

PROJECT NAME: MENDON
 PROJECT NUMBER: ER 020-2(39)
 FILE NAME: z13b188erobdrconstruction.dgn PLOT DATE: 11/13/2015
 PROJECT LEADER: E. ATKINS DRAWN BY: M. BRADLEY
 DESIGNED BY: M. BRADLEY CHECKED BY: E. ATKINS
 EPSC CONSTRUCTION PLAN SHEET 3 SHEET 45 OF 72

GREEN INTERNATIONAL AFFILIATES, INC.
 CIVIL AND STRUCTURAL ENGINEERS