


NOTE: SEE CROSS SECTIONS FOR PROPOSED GRADING

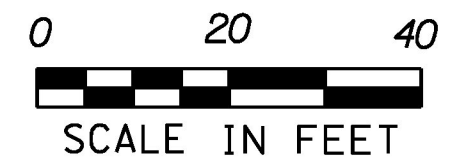

GREEN INTERNATIONAL AFFILIATES, INC.
CIVIL AND STRUCTURAL ENGINEERS

PROJECT NAME:	MENDON	PLOT DATE:	11/13/2015
PROJECT NUMBER:	ER 020-2(39)	DRAWN BY:	M. BRADLEY
FILE NAME:	z13bi88erobdrfinal.dgn	CHECKED BY:	E. ATKINS
DESIGNED BY:	M. BRADLEY	EPSC FINAL CONDITIONS PLAN SHEET 3	SHEET 48 OF 72

MATCHLINE RAVINE STA. 206+50, SHEET 46