



NOTE:
 * CONTRACTOR SHALL DESIGN AND PROVIDE TEMPORARY SUPPORT OF EXCAVATION UNLESS OTHERWISE DIRECTED BY THE ENGINEER. COST ASSOCIATED WITH TEMPORARY SUPPORT WILL BE CONSIDERED INCIDENTAL TO ITEM 203.17 UNCLASSIFIED EXCAVATION.

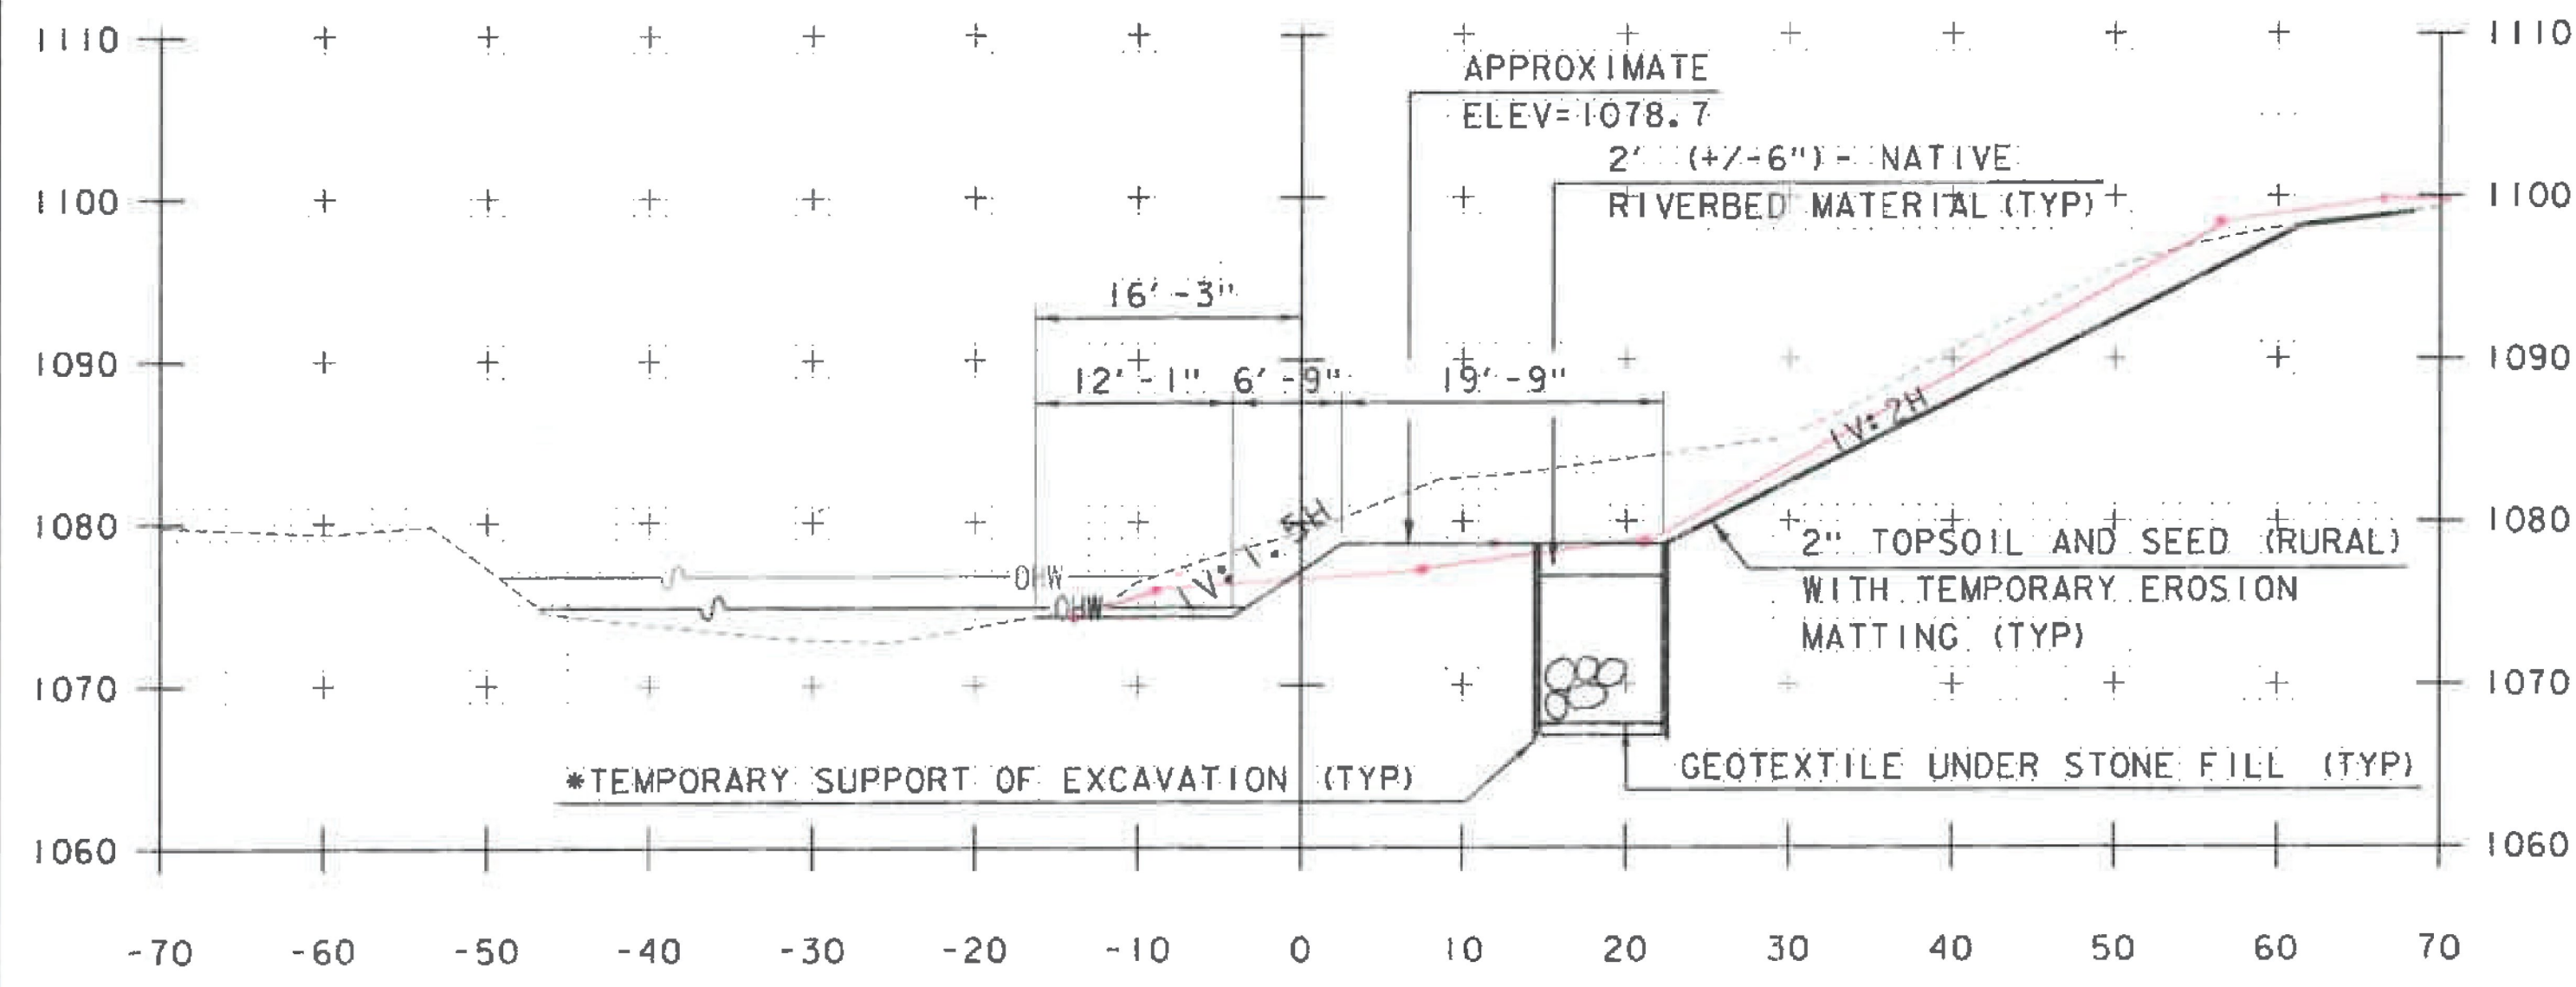

9+00.00

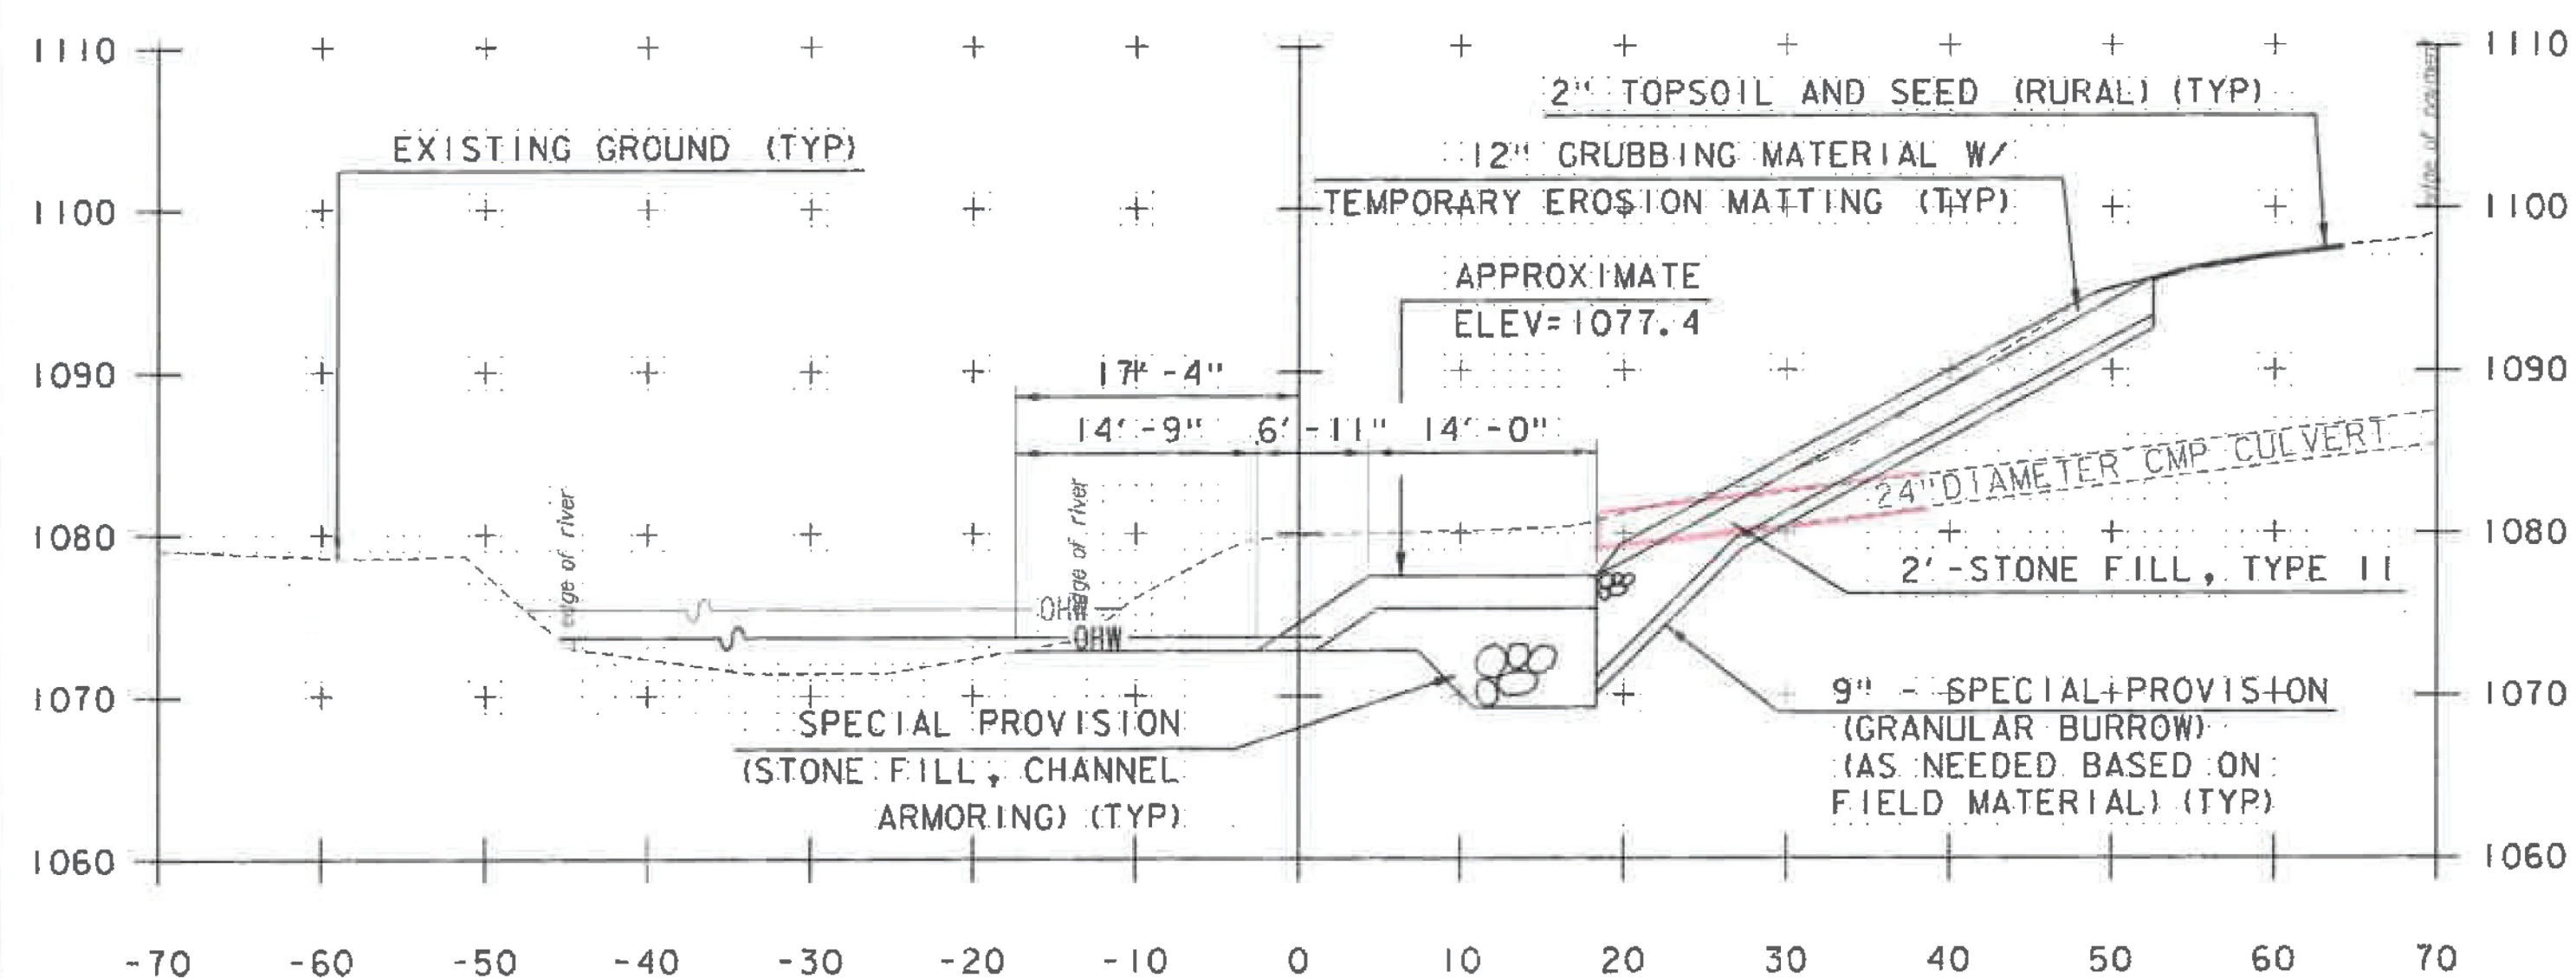

8+65.65, 24" DIA. CMP CULVERT
 82° 06' 33.48"

RECEIVED
 JUL 12 2016

BY:

STA. 8+65.65 TO STA. 9+00

NOTE: STATIONS AND ELEVATIONS ARE IN FEET

GREEN INTERNATIONAL AFFILIATES, INC.
 CIVIL AND STRUCTURAL ENGINEERS

PROJECT NAME: MENDON	PLOT DATE: 11/24/2015
PROJECT NUMBER: ER 020-2(39)	DRAWN BY: S. SOLLA
FILE NAME: z13b188xsl.dgn	CHECKED BY: E. ATKINS
PROJECT LEADER: E. ATKINS	SHEET 57A OF 72
DESIGNED BY: M. BRADLEY	CROSS SECTION SHEET 5