



NOTE:
 * CONTRACTOR SHALL DESIGN AND PROVIDE TEMPORARY SUPPORT OF EXCAVATION UNLESS OTHERWISE DIRECTED BY THE ENGINEER. COST ASSOCIATED WITH TEMPORARY SUPPORT WILL BE CONSIDERED INCIDENTAL TO ITEM 203.17 UNCLASSIFIED EXCAVATION.

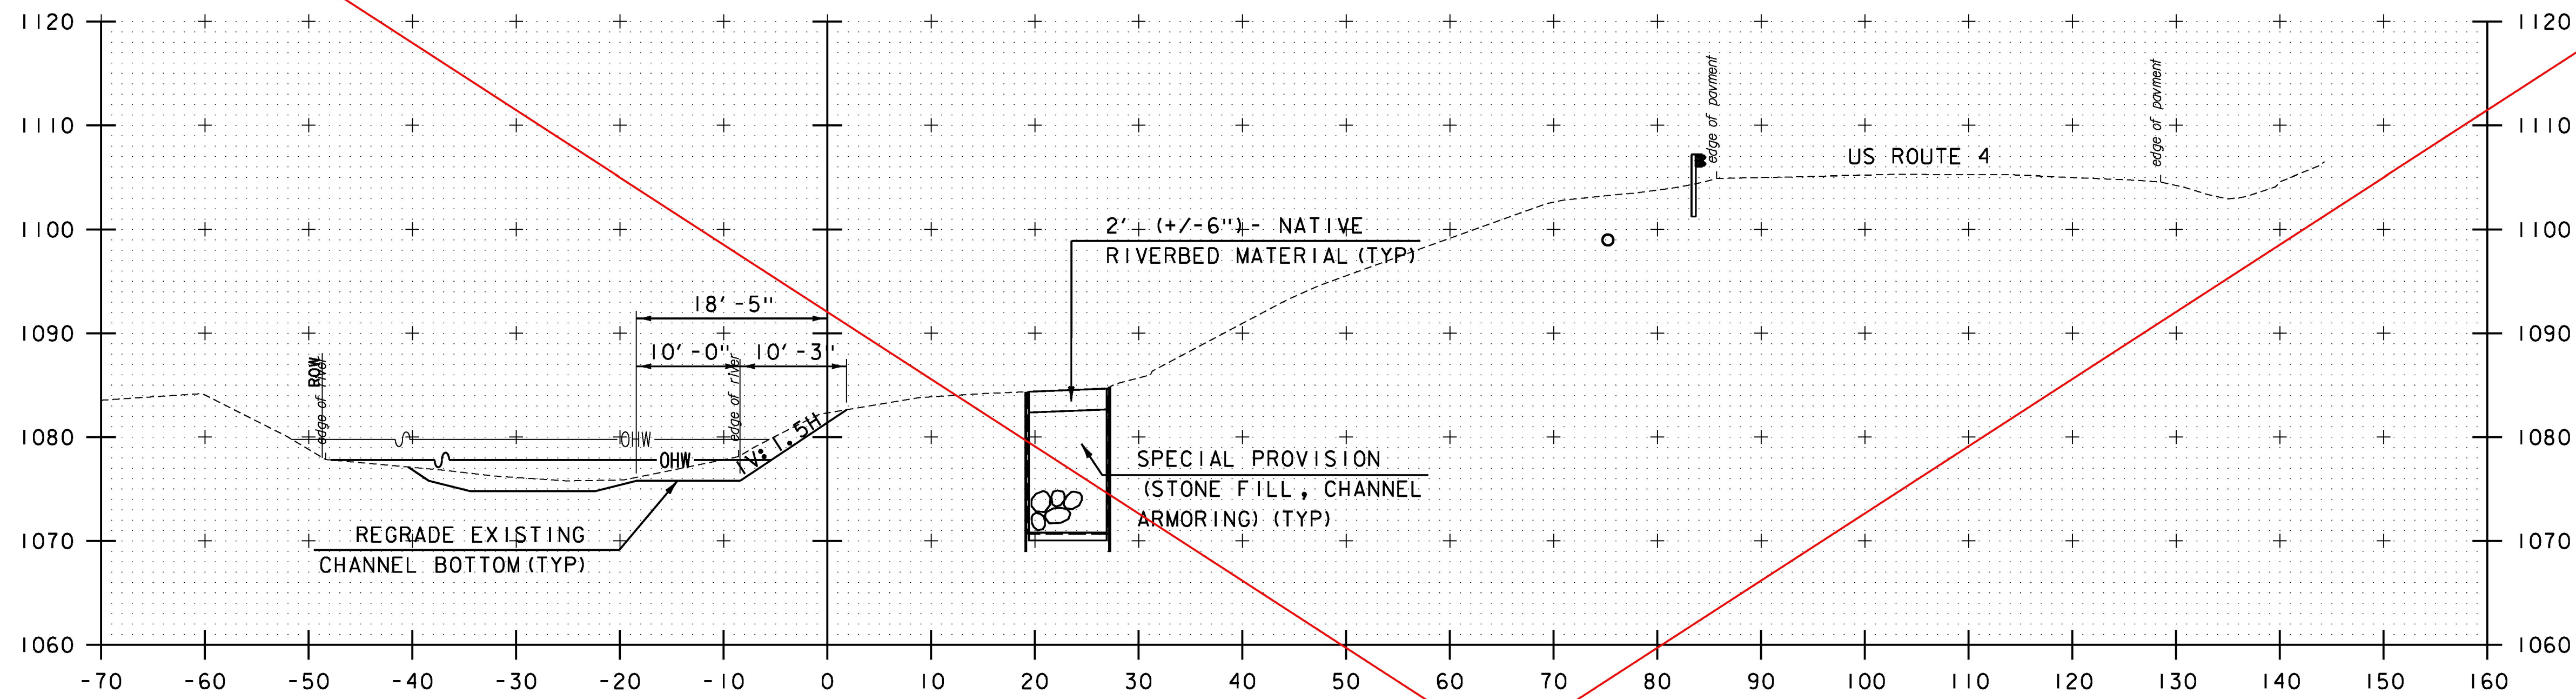

10+00.00

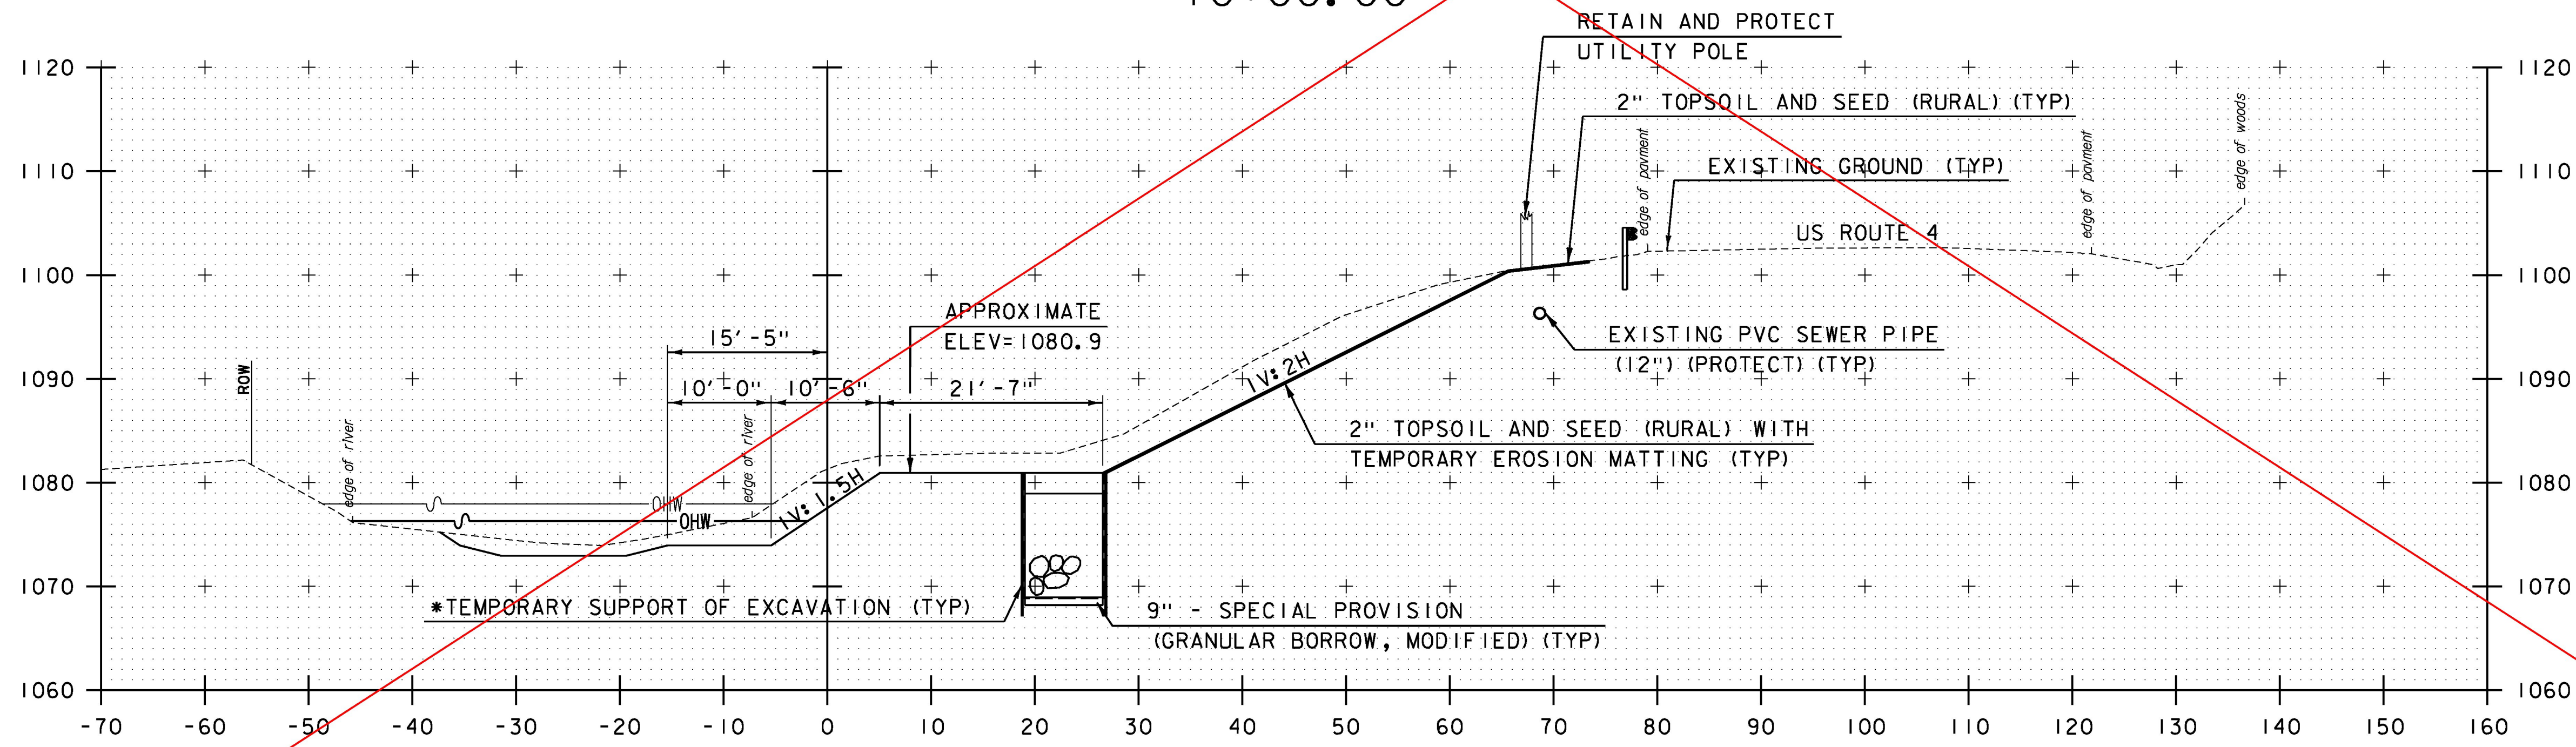

9+50.00

STA. 9+50 TO STA. 10+00

SEE REVISED SECTIONS (SHEETS 53A - 60A)

NOTE: STATIONS AND ELEVATIONS ARE IN FEET



PROJECT NAME:	MENDON
PROJECT NUMBER:	ER 020-2(39)
FILE NAME:	z13bi88xsl.dgn
PROJECT LEADER:	E. ATKINS
DESIGNED BY:	M. BRADLEY
CROSS SECTION SHEET	6
PLOT DATE:	11/13/2015
DRAWN BY:	S. SALLA
CHECKED BY:	E. ATKINS
SHEET	58 OF 72