



NOTE:
 * CONTRACTOR SHALL DESIGN AND PROVIDE TEMPORARY SUPPORT OF EXCAVATION UNLESS OTHERWISE DIRECTED BY THE ENGINEER. COST ASSOCIATED WITH TEMPORARY SUPPORT WILL BE CONSIDERED INCIDENTAL TO ITEM 203.17 UNCLASSIFIED EXCAVATION.

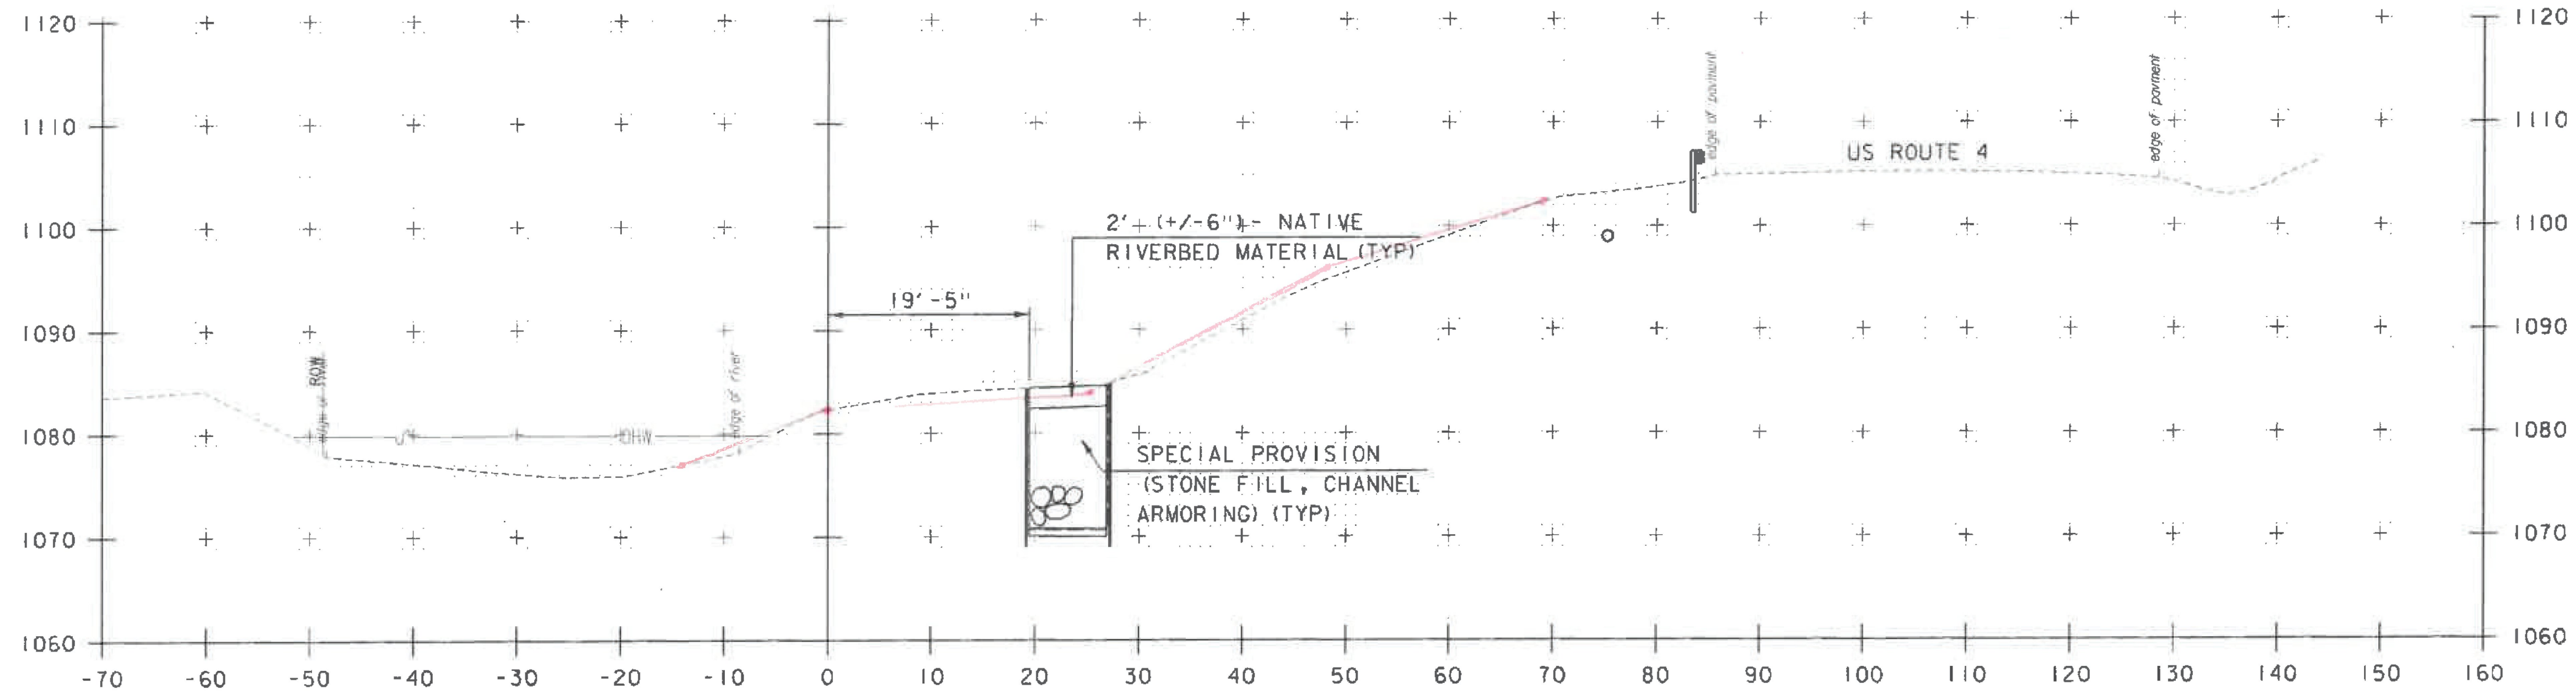

10+00.00

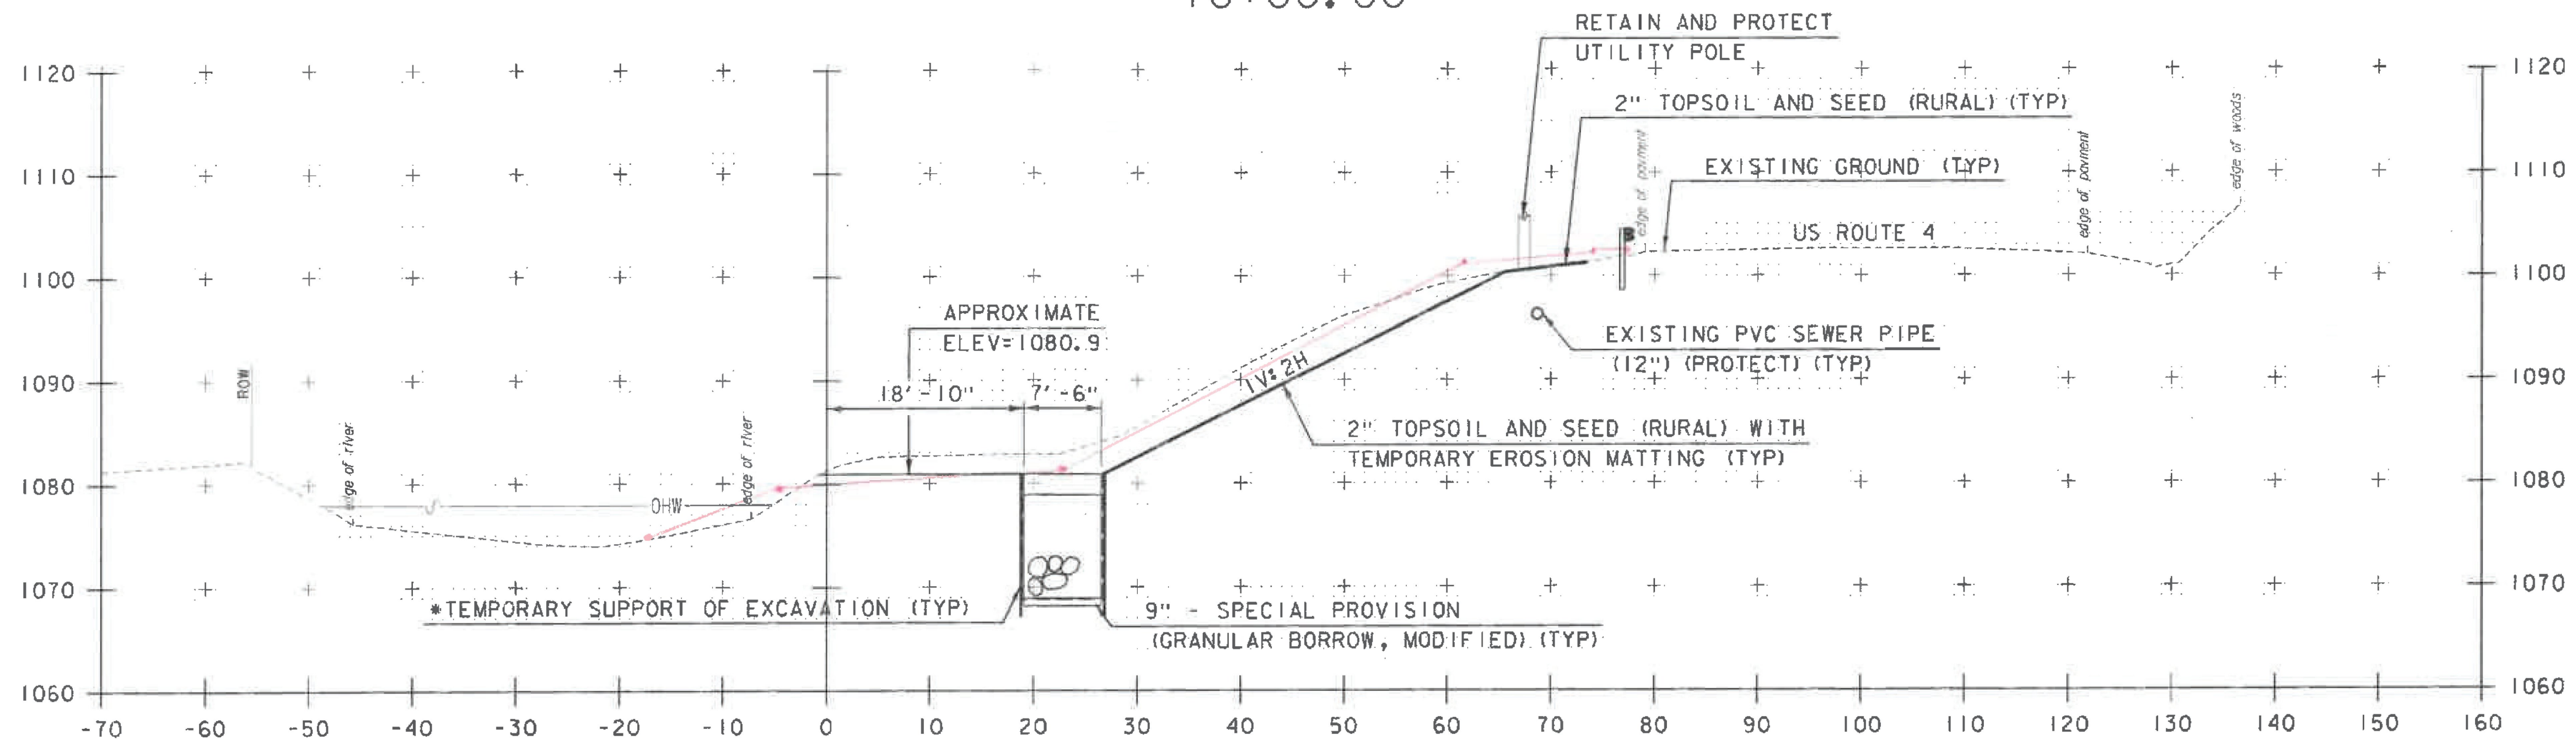

9+50.00

RECEIVED
 JUL 26 2015

BY:

STA. 9+50 TO STA. 10+00

PROJECT NAME: MENDON	PLOT DATE: 11/24/2015
PROJECT NUMBER: ER 020-2(39)	DRAWN BY: S. SOLLA
FILE NAME: z13b188xsl.dgn	CHECKED BY: E. ATKINS
PROJECT LEADER: E. ATKINS	SHEET 58A OF 72
DESIGNED BY: M. BRADLEY	
CROSS SECTION SHEET 6	

NOTE: STATIONS AND ELEVATIONS ARE IN FEET

GREEN INTERNATIONAL AFFILIATES, INC.
 CIVIL AND STRUCTURAL ENGINEERS