



NOTE:  
 \* CONTRACTOR SHALL DESIGN AND PROVIDE TEMPORARY SUPPORT OF EXCAVATION UNLESS OTHERWISE DIRECTED BY THE ENGINEER. COST ASSOCIATED WITH TEMPORARY SUPPORT WILL BE CONSIDERED INCIDENTAL TO ITEM 203.17 UNCLASSIFIED EXCAVATION.

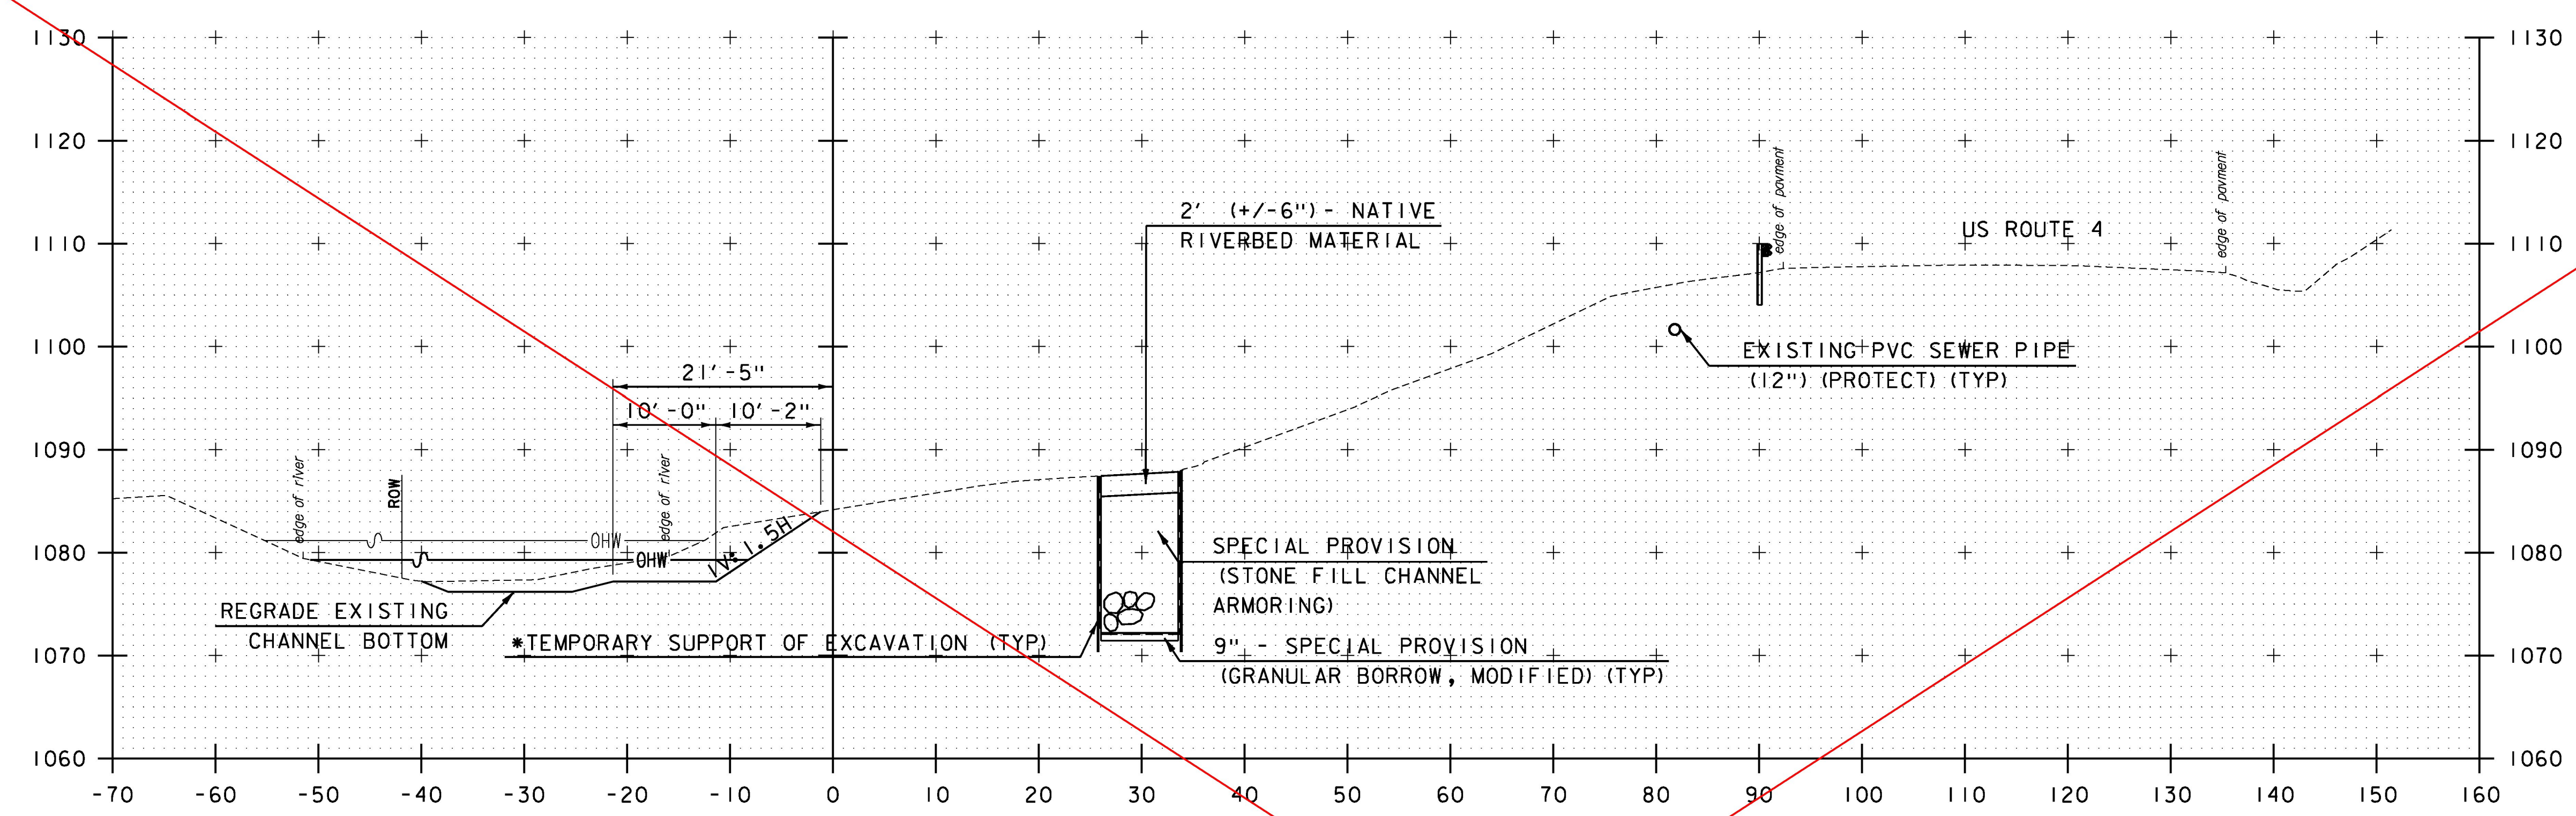

10+50.00

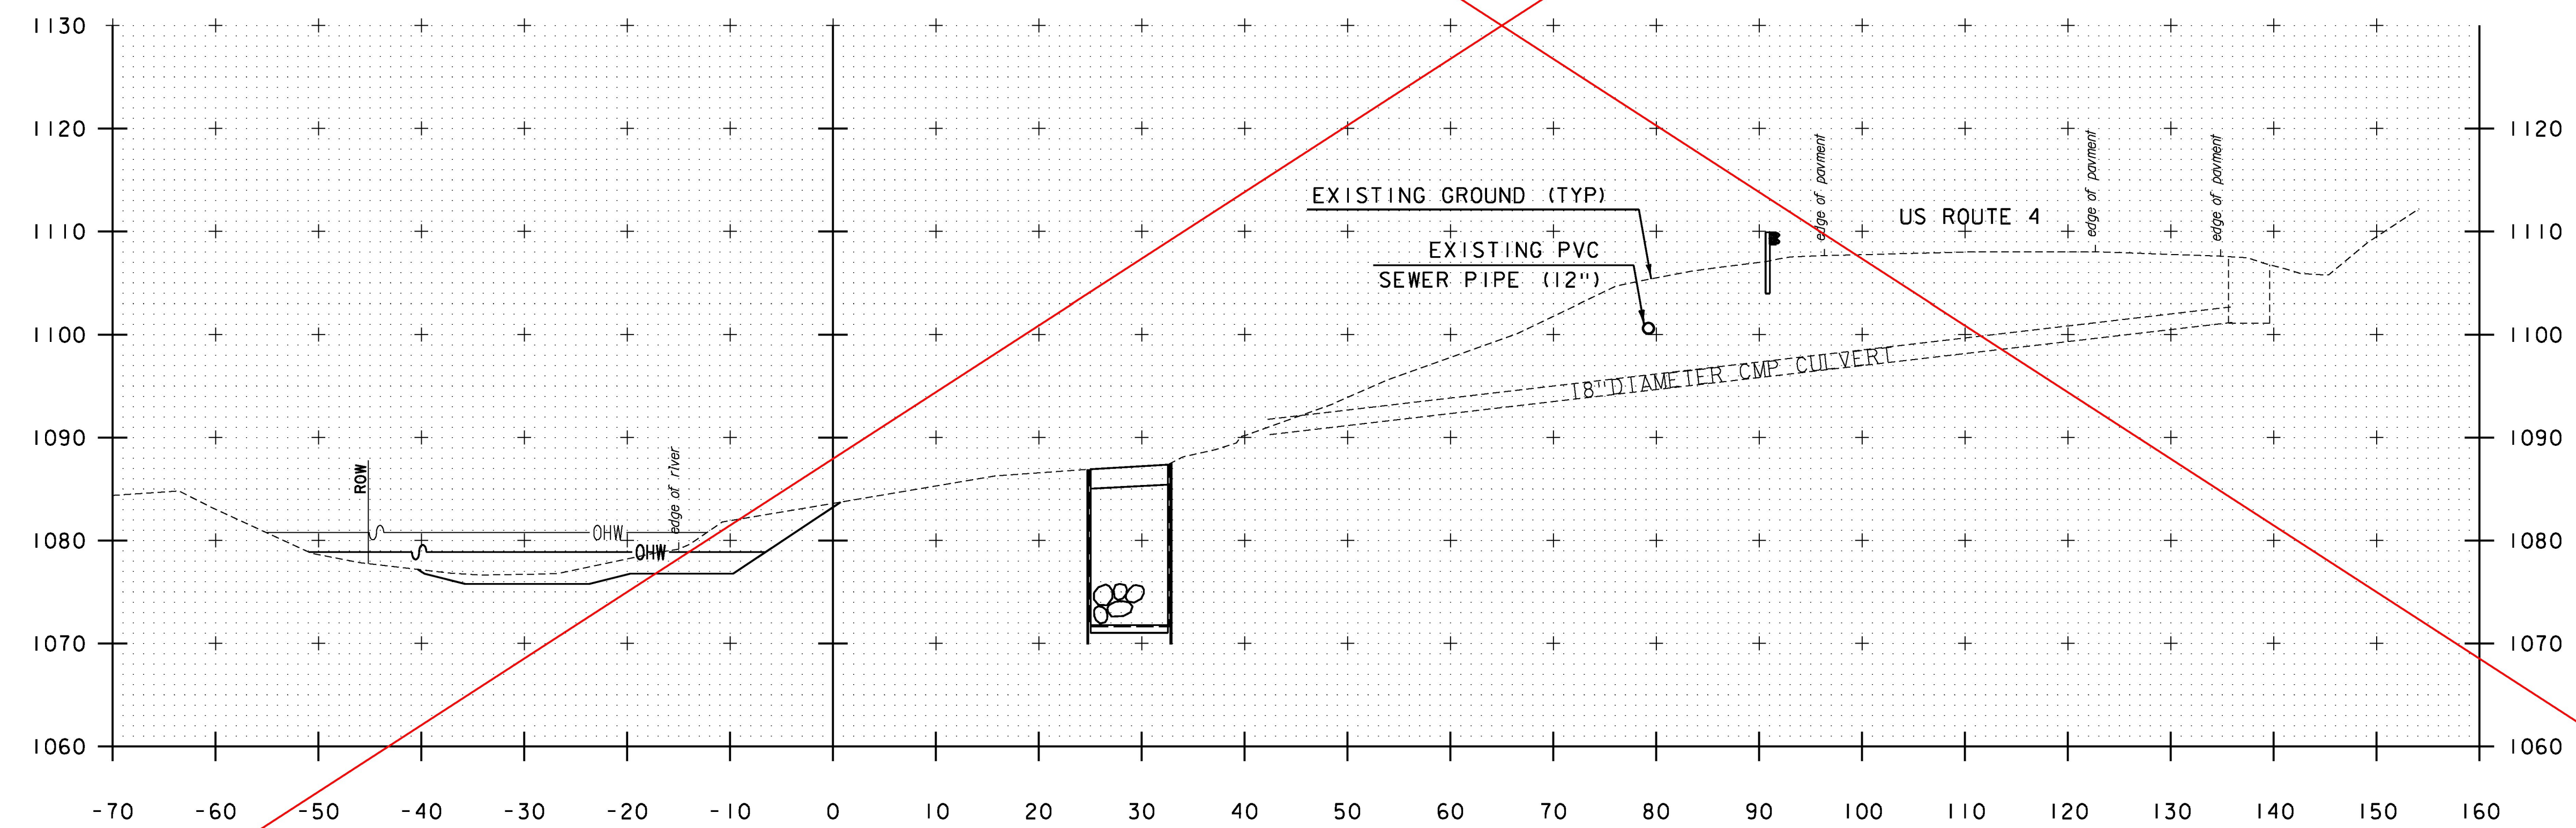

10+35.68, 18" DIA. 18" CMP CULVERT  
 SKEWED AT 81° 49' 14.88"

STA. 10+35.68 TO STA. 10+50

SEE REVISED SECTIONS (SHEETS 53A - 60A)

NOTE: STATIONS AND ELEVATIONS ARE IN FEET

GREEN INTERNATIONAL AFFILIATES, INC.  
 CIVIL AND STRUCTURAL ENGINEERS

PROJECT NAME: MENDON	PLOT DATE: 11/13/2015
PROJECT NUMBER: ER 020-2(39)	DRAWN BY: S. SALLA
FILE NAME: z13bi88xsl.dgn	DESIGNED BY: M. BRADLEY
PROJECT LEADER: E. ATKINS	CHECKED BY: E. ATKINS
CROSS SECTION SHEET 7	SHEET 59 OF 72