




24+31.64 END MENDON ER 020-2 (39)
BEGIN APPROACH

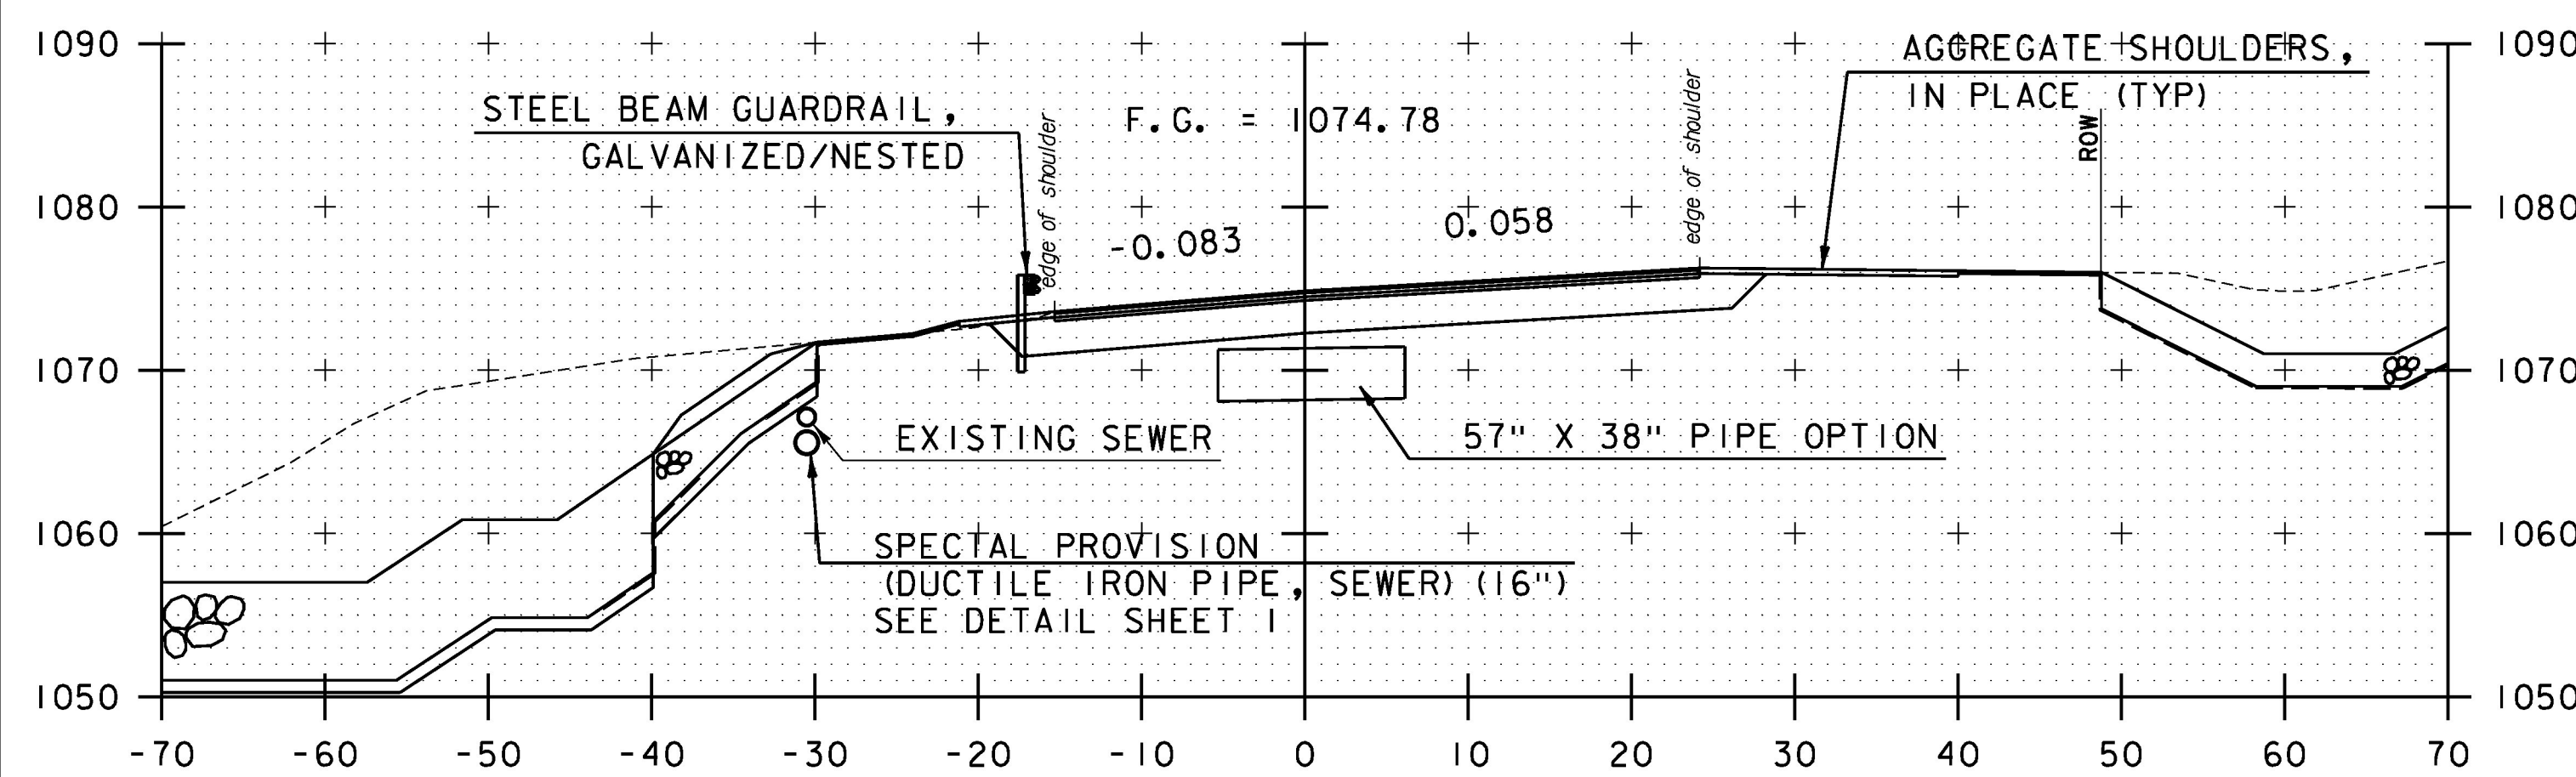

24+00.00

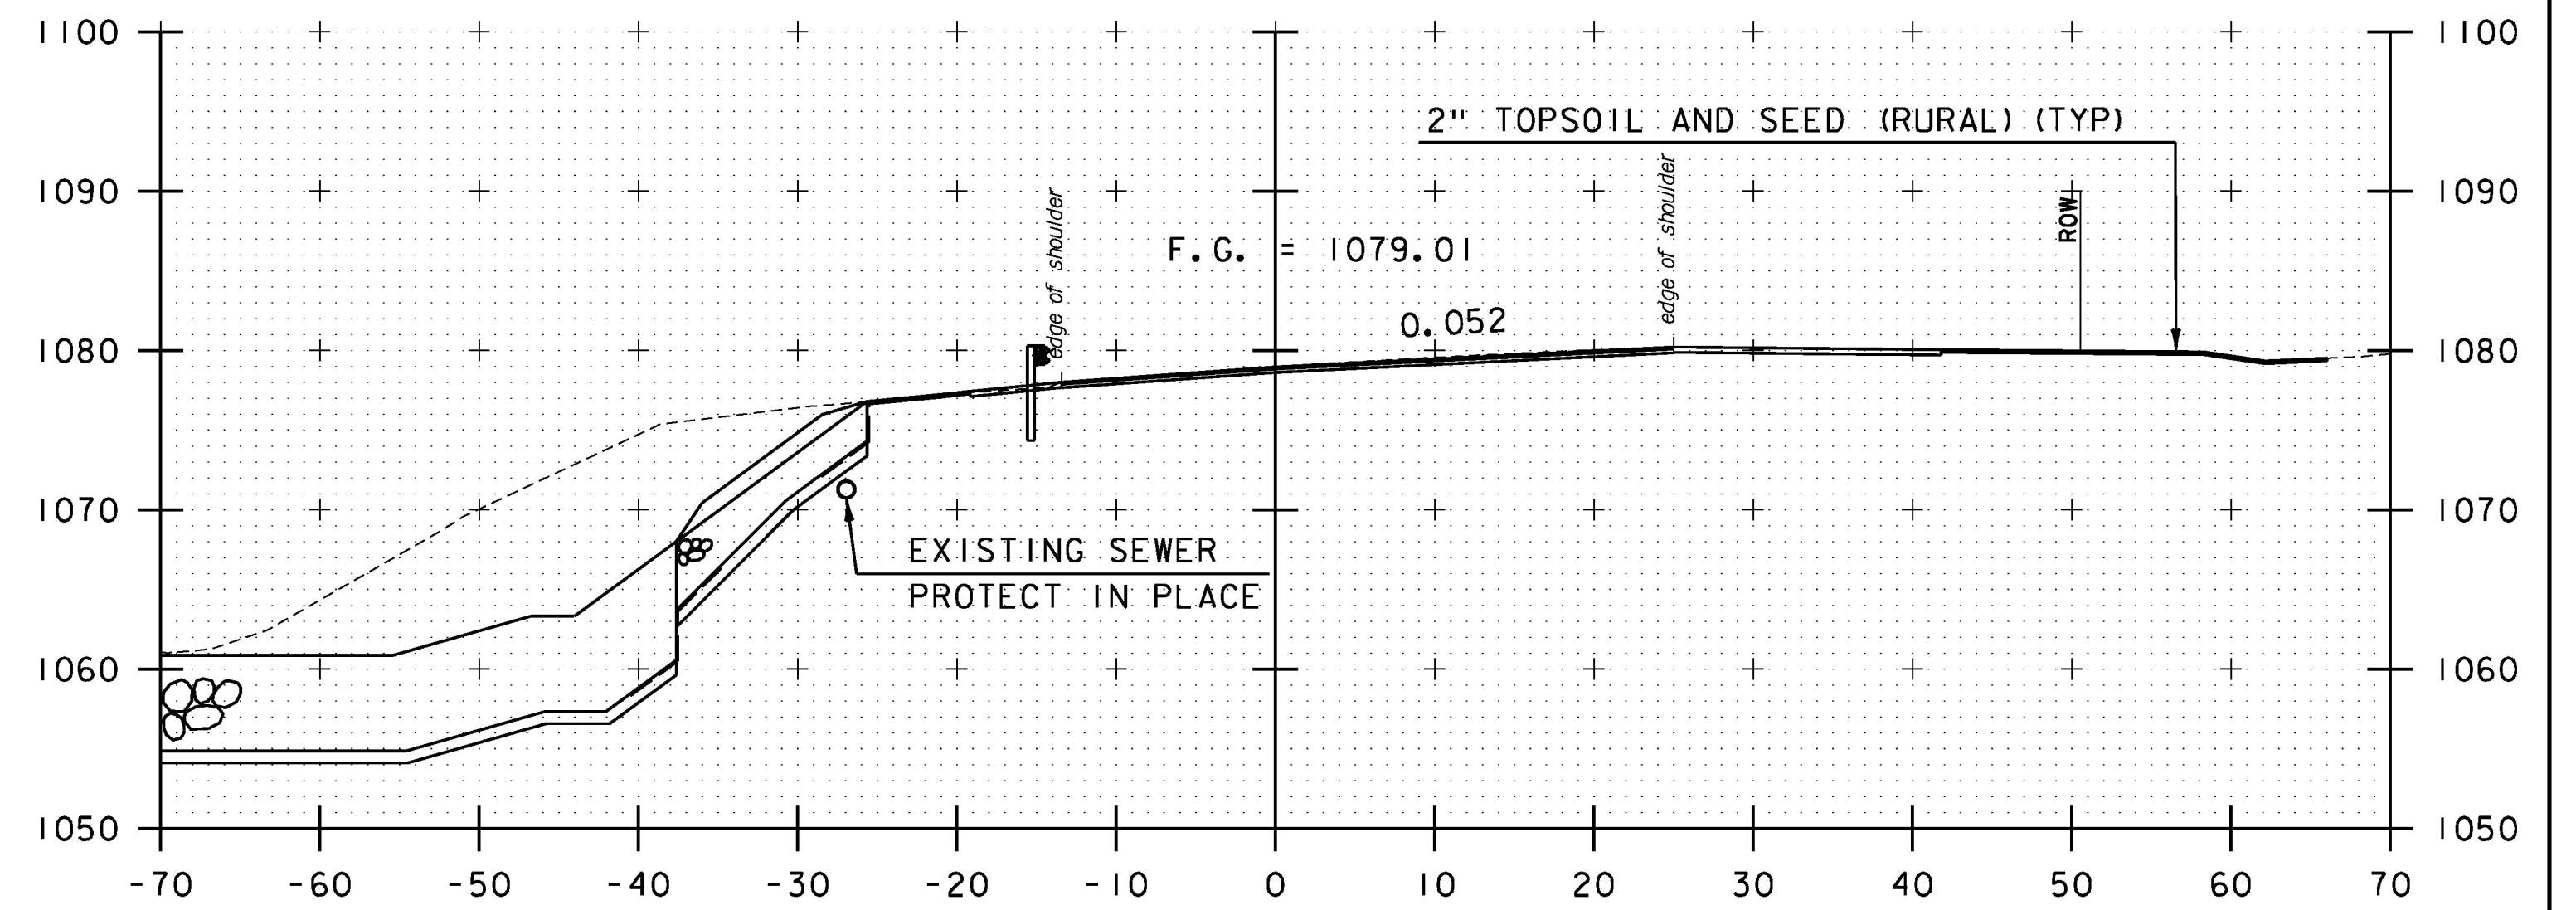

25+00.00

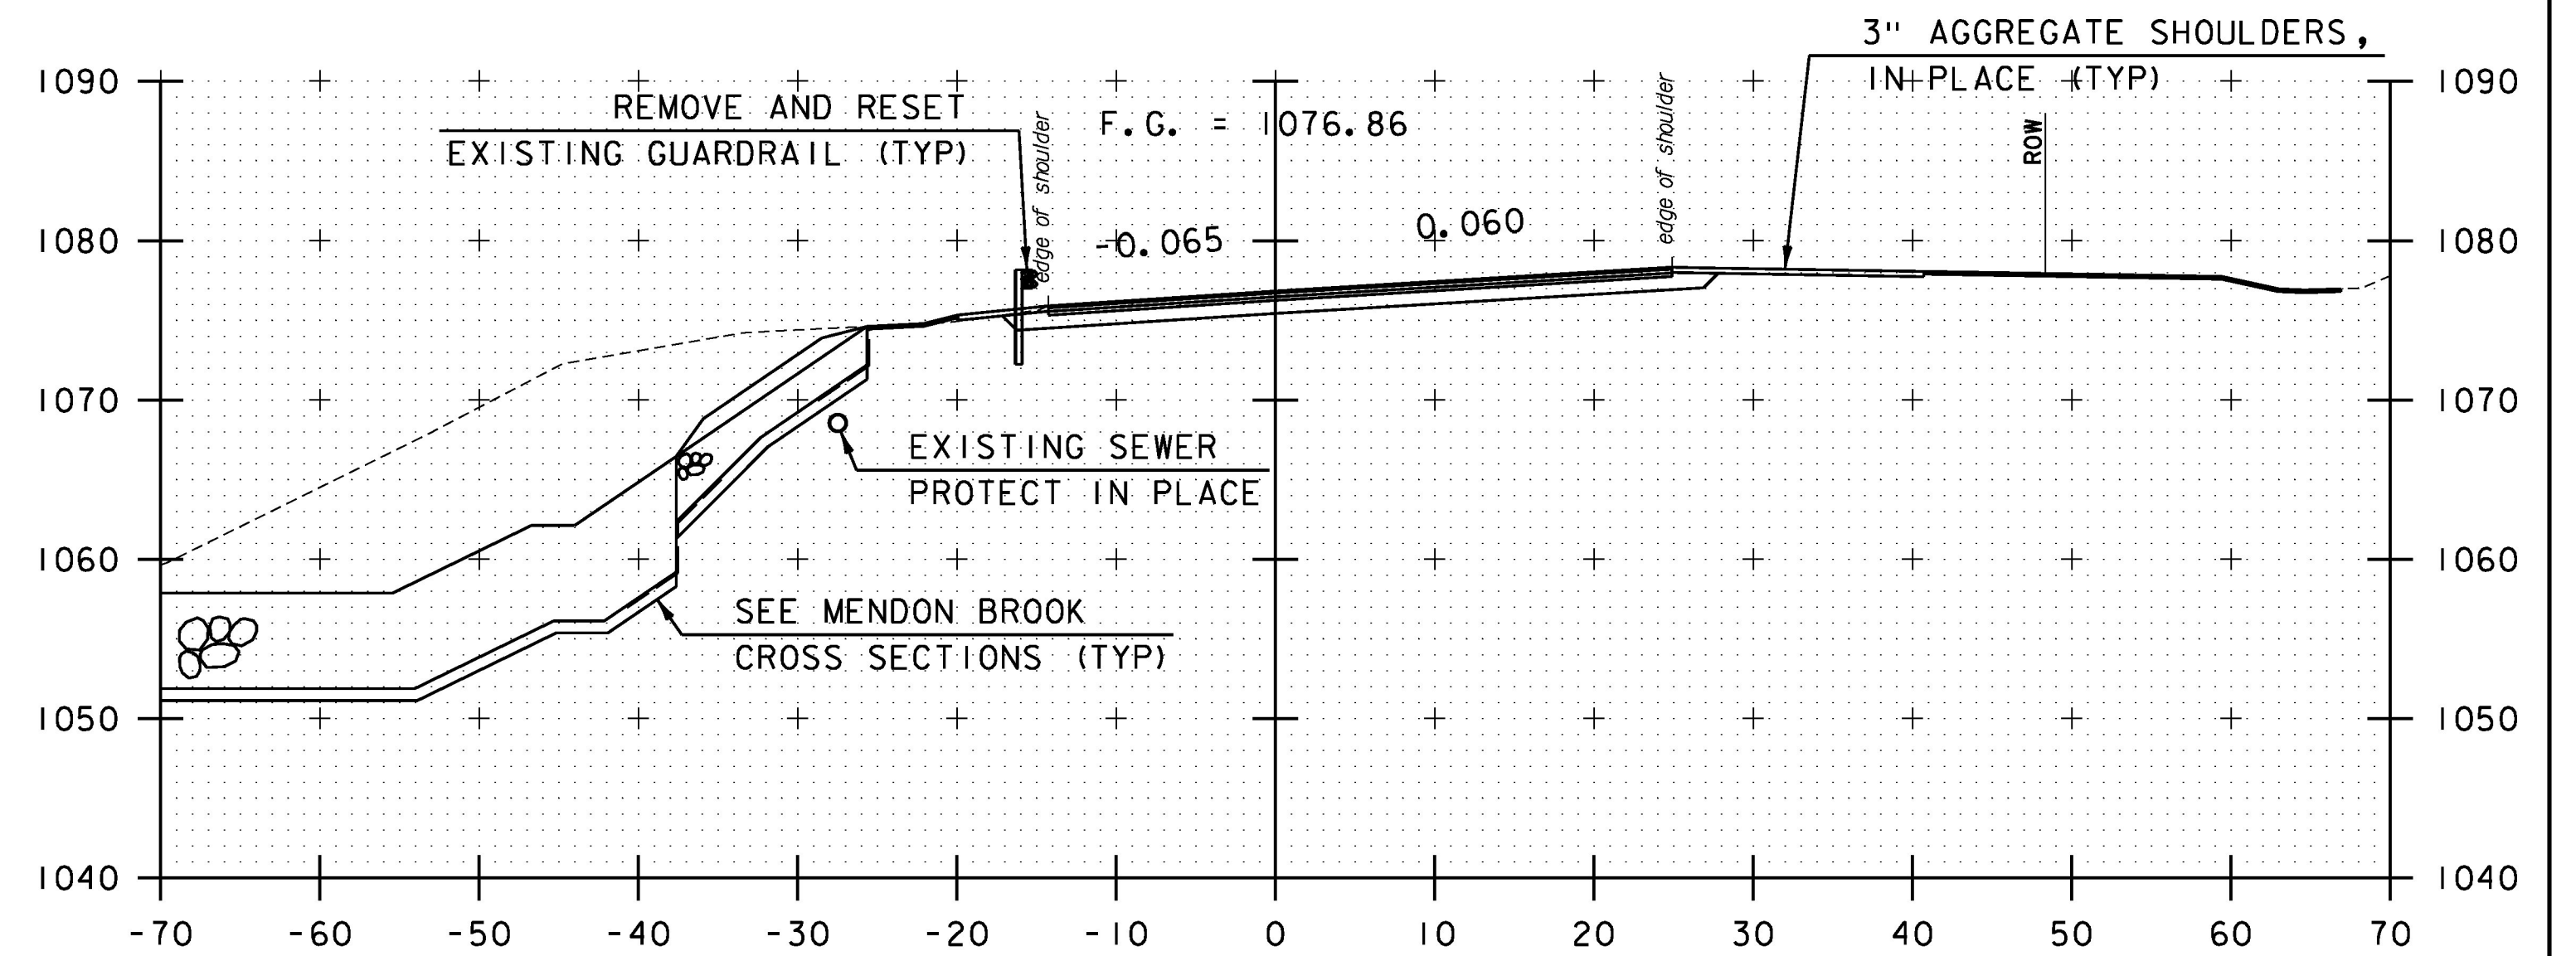

24+50.00

STA. 24+00 TO STA. 25+00

NOTES: ALL ROADWAY CROSS SLOPES ARE PROVIDED FOR INFORMATION ONLY
ALL ROADWAY CROSS SLOPES SHALL MATCH EXISTING
STATIONS AND ELEVATIONS ARE IN FEET

GREEN INTERNATIONAL AFFILIATES, INC.
CIVIL AND STRUCTURAL ENGINEERS

PROJECT NAME: MENDON
PROJECT NUMBER: ER 020-2(39)

FILE NAME: z13bi88xsl.dgn
PROJECT LEADER: E. ATKINS
DESIGNED BY: M. BRADLEY
CROSS SECTION SHEET 10

PLOT DATE: 11/13/2015
DRAWN BY: S. SOLLA
CHECKED BY: E. ATKINS
SHEET 62 OF 72