


25+50

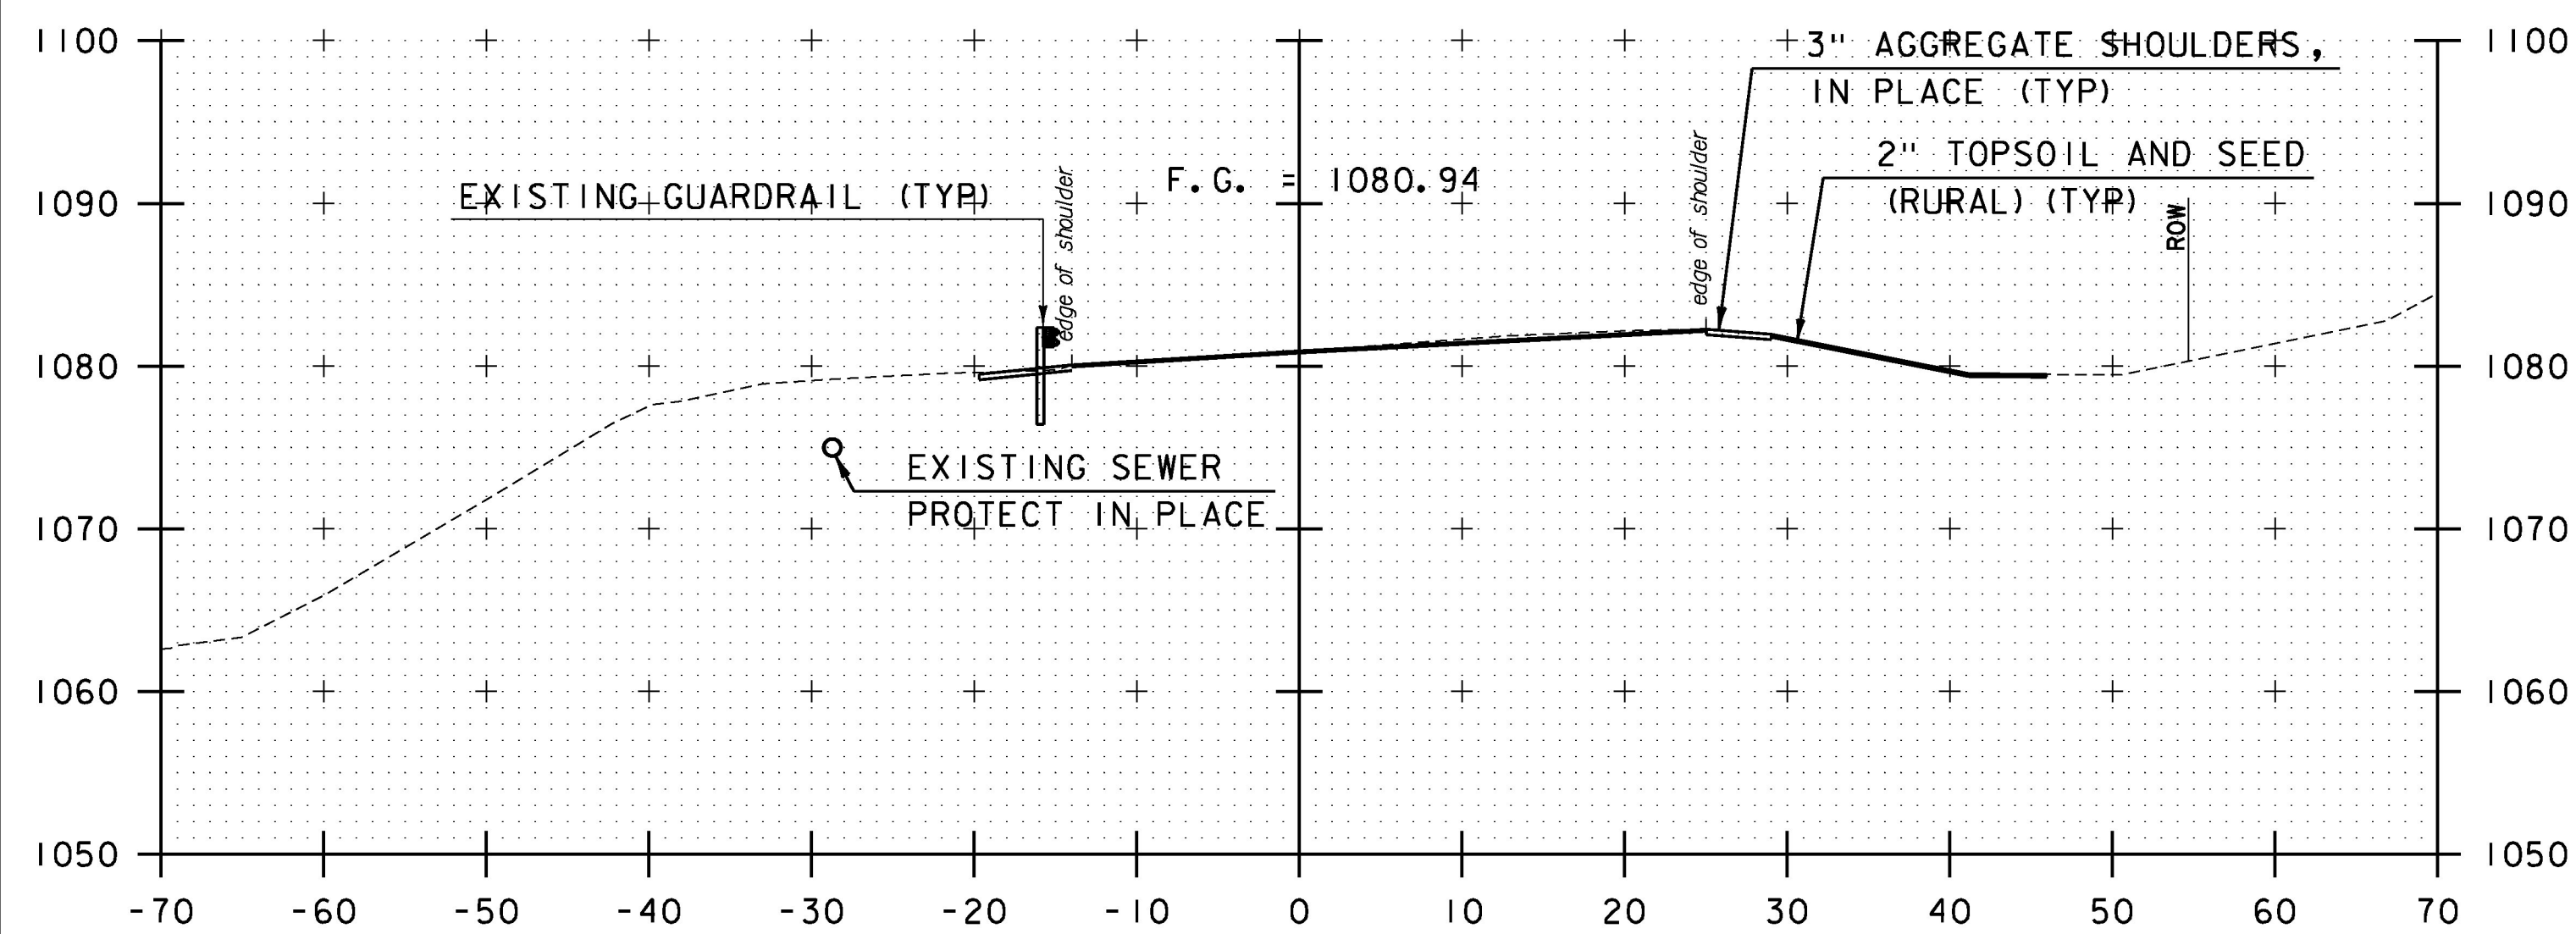

25+44.14 END APPROACH

STA. 25+44.14 TO STA. 25+50

NOTES: ALL ROADWAY CROSS SLOPES ARE PROVIDED FOR INFORMATION ONLY  
 ALL ROADWAY CROSS SLOPES SHALL MATCH EXISTING  
 STATIONS AND ELEVATIONS ARE IN FEET



PROJECT NAME: MENDON	PLOT DATE: 11/13/2015
PROJECT NUMBER: ER 020-2(39)	DRAWN BY: S. SOLLA
FILE NAME: z13bi88xsl.dgn	DESIGNED BY: M. BRADLEY
PROJECT LEADER: E. ATKINS	CHECKED BY: E. ATKINS
CROSS SECTION SHEET II	SHEET 63 OF 72