


207+50

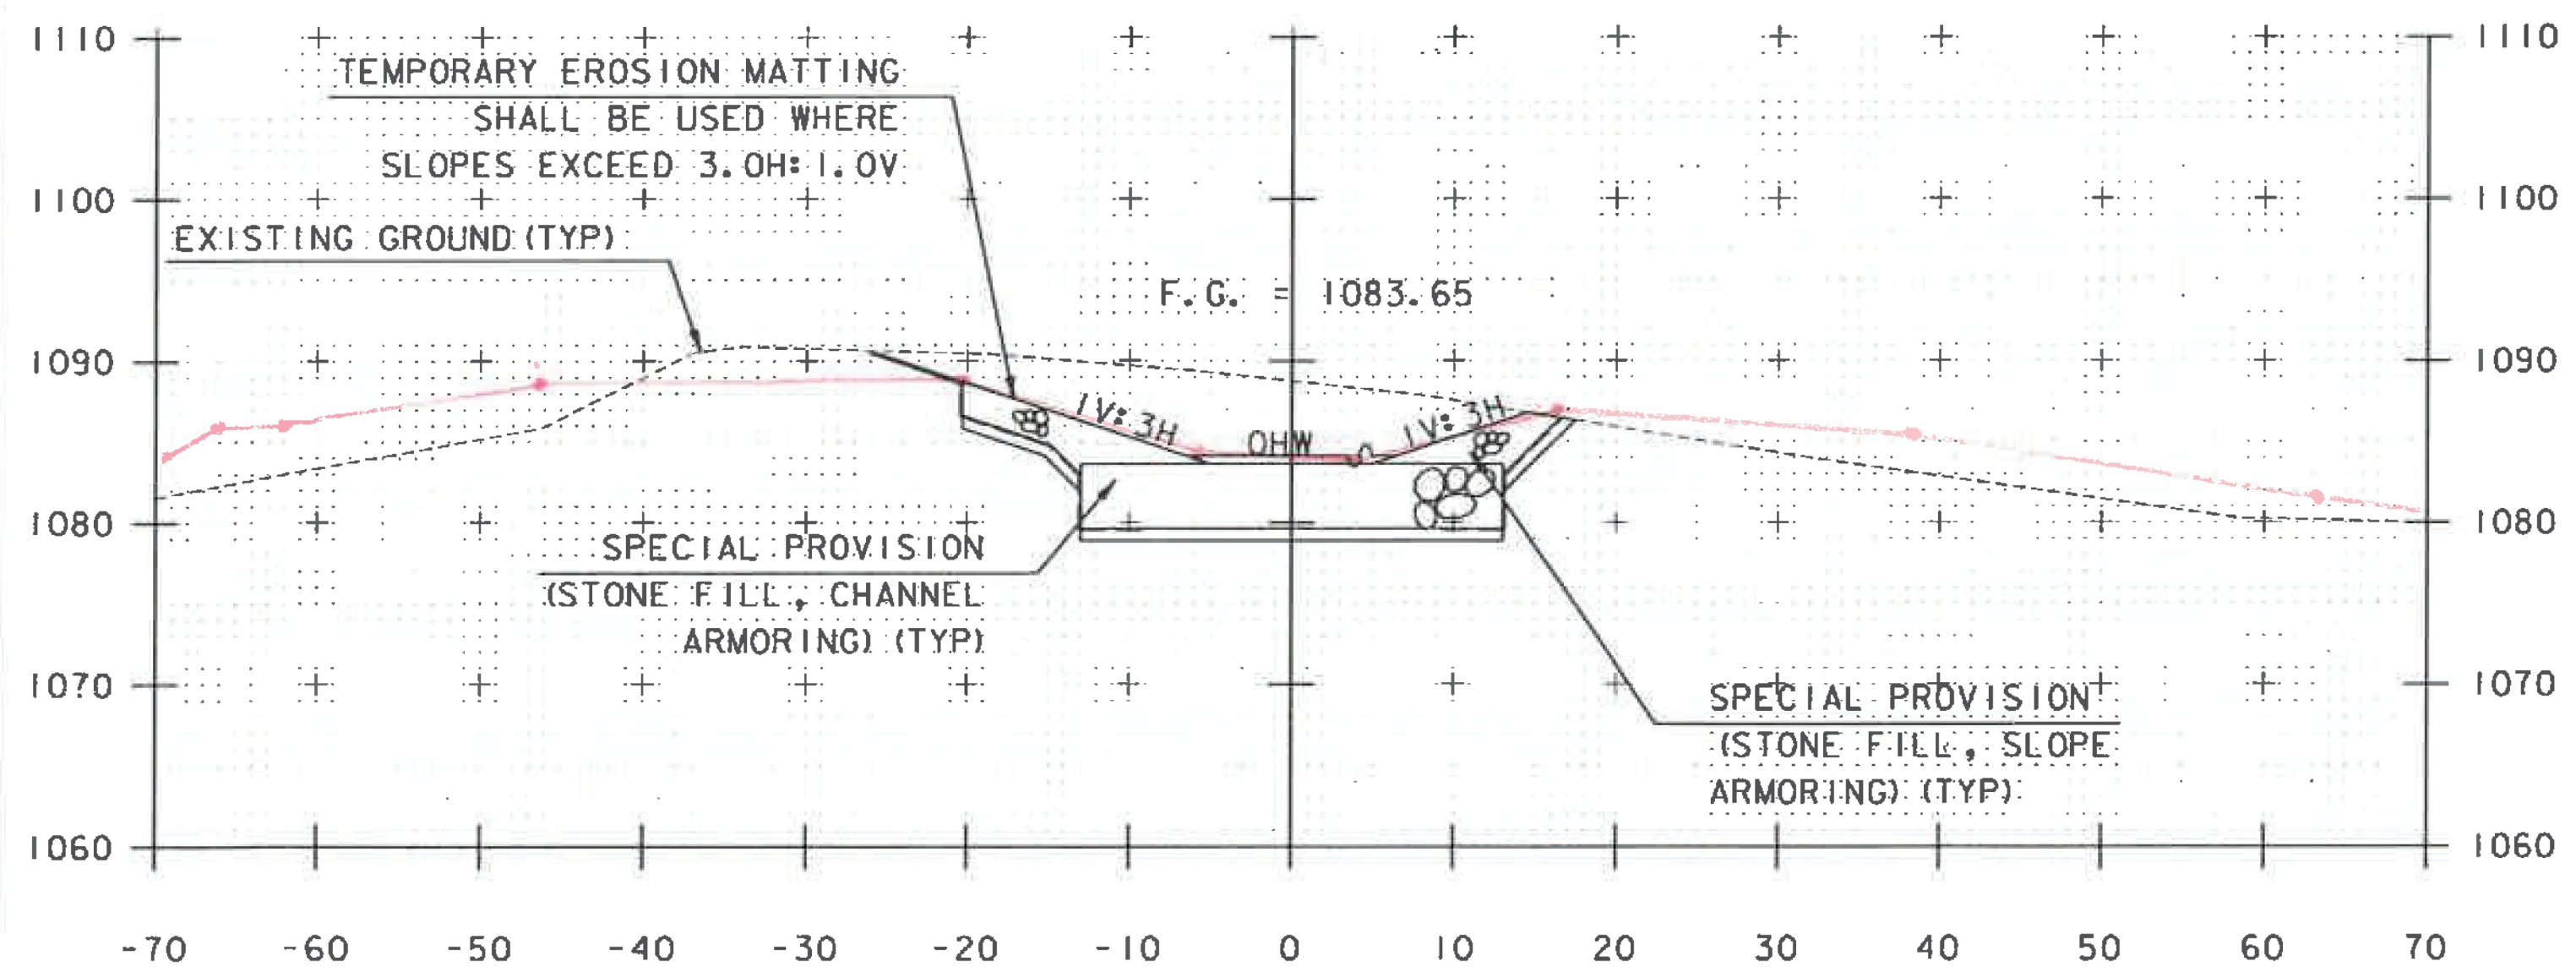

207+00

STA. 207+00 TO STA. 207+50

NOTE: STATIONS AND ELEVATIONS ARE IN FEET

GREEN INTERNATIONAL AFFILIATES, INC.  
CIVIL AND STRUCTURAL ENGINEERS

PROJECT NAME: MENDON	PLOT DATE: 11/13/2015
PROJECT NUMBER: ER 020-2(39)	DRAWN BY: S. SOLLA
FILE NAME: z13b188xsl.dgn	CHECKED BY: E. ATKINS
DESIGNED BY: M. BRADLEY	SHEET 69 OF 72
CROSS SECTION SHEET 17	