



### COLD PLANE AND OVERLAY TYPICAL SECTION

STA. B 350+60.00 - W 12+70.00

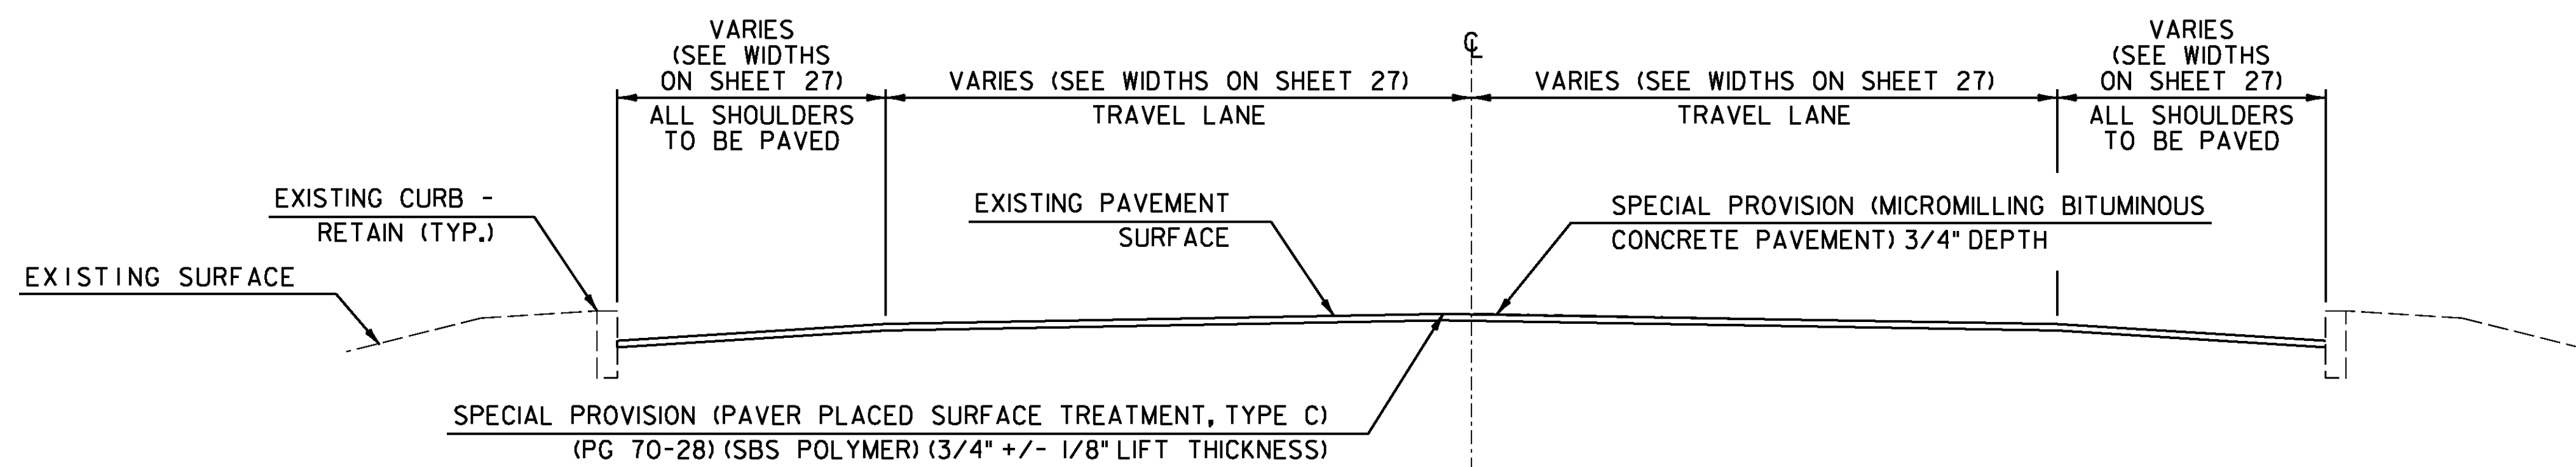

### MICROMILL AND OVERLAY CURBED TYPICAL SECTION

STA. B 0+00.00 - B 2+60.00  
STA. B 298+76.50 - B 340+70.00

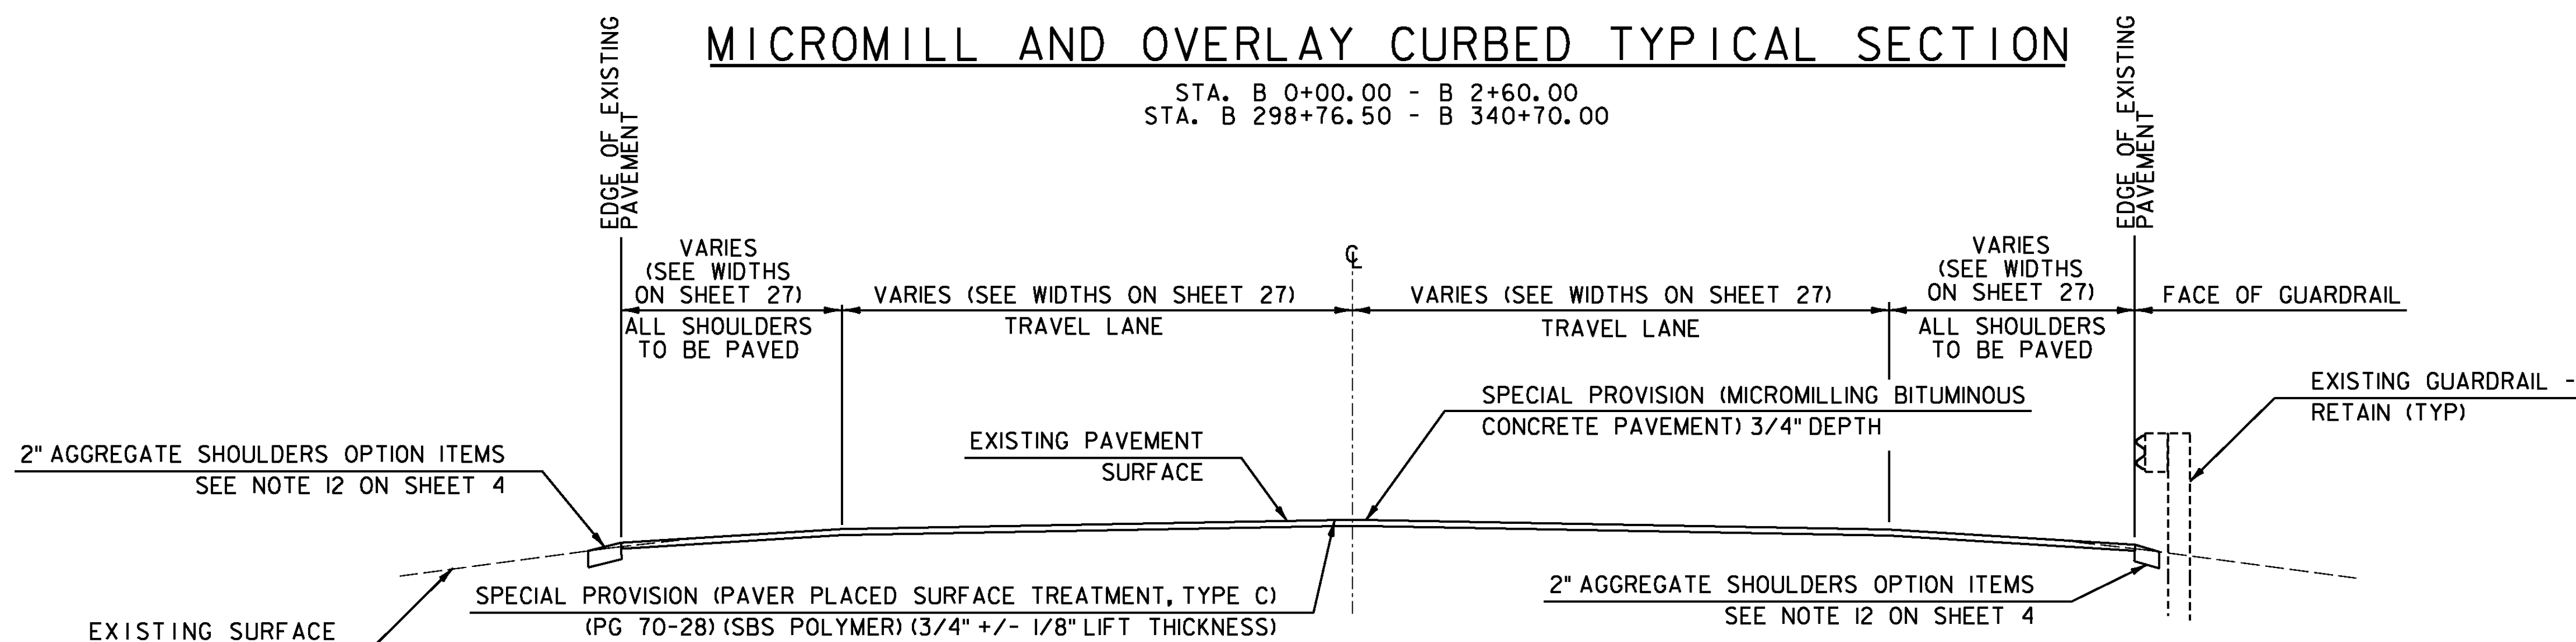

### MICROMILL AND OVERLAY TYPICAL SECTION

STA. K 398+80.00 - K 447+82.42 = B 0+00.00  
STA. B 6+65.00 - B 84+65.00  
STA. B 86+95.00 - B 118+40.00  
STA. B 120+85.00 - B 149+85.00  
STA. B 152+40.00 - B 298+76.50  
STA. B 340+70.00 - B 350+60.00  
STA. W 12+70.00 - W 298+83.00

PROJECT NAME: KILLINGTON-WOODSTOCK  
PROJECT NUMBER: ER NH 020-2(38)

FILE NAME: z13bi92typ.dgn  
PROJECT LEADER: E. ATKINS  
DESIGNED BY: T. BIGELOW  
TYPICAL SECTION SHEET 1

PLOT DATE: 3/7/2016  
DRAWN BY: N.GOTTIER  
CHECKED BY: E. ATKINS  
SHEET 5 OF 146

NOT TO SCALE