



MILLED RUMBLE STRIPS (CENTERLINE)  
STA. K 439+50 - B 1+00

TEMPORARY 4 INCH WHITE LINE, PAINT  
DURABLE 4 INCH WHITE LINE, (SEE OPTION ITEMS)  
(ALL LINES WILL INCLUDE EDGE LINE BREAKS  
AND RADIUS FOR SIDE ROADS)  
STA. K 439+50 - B 1+50 (SOLID LT & RT)

TEMPORARY 4 INCH YELLOW LINE, PAINT  
DURABLE 4 INCH YELLOW LINE, (SEE OPTION ITEMS)  
(ALL LINES WILL INCLUDE CENTER LINE BREAKS  
FOR SIDE ROADS)  
STA. K 439+50 - B 1+50 (SOLID LT & RT)

REMOVING SIGNS  
AS SHOWN - 19

ERECTING SALVAGED SIGNS  
AS SHOWN - 4

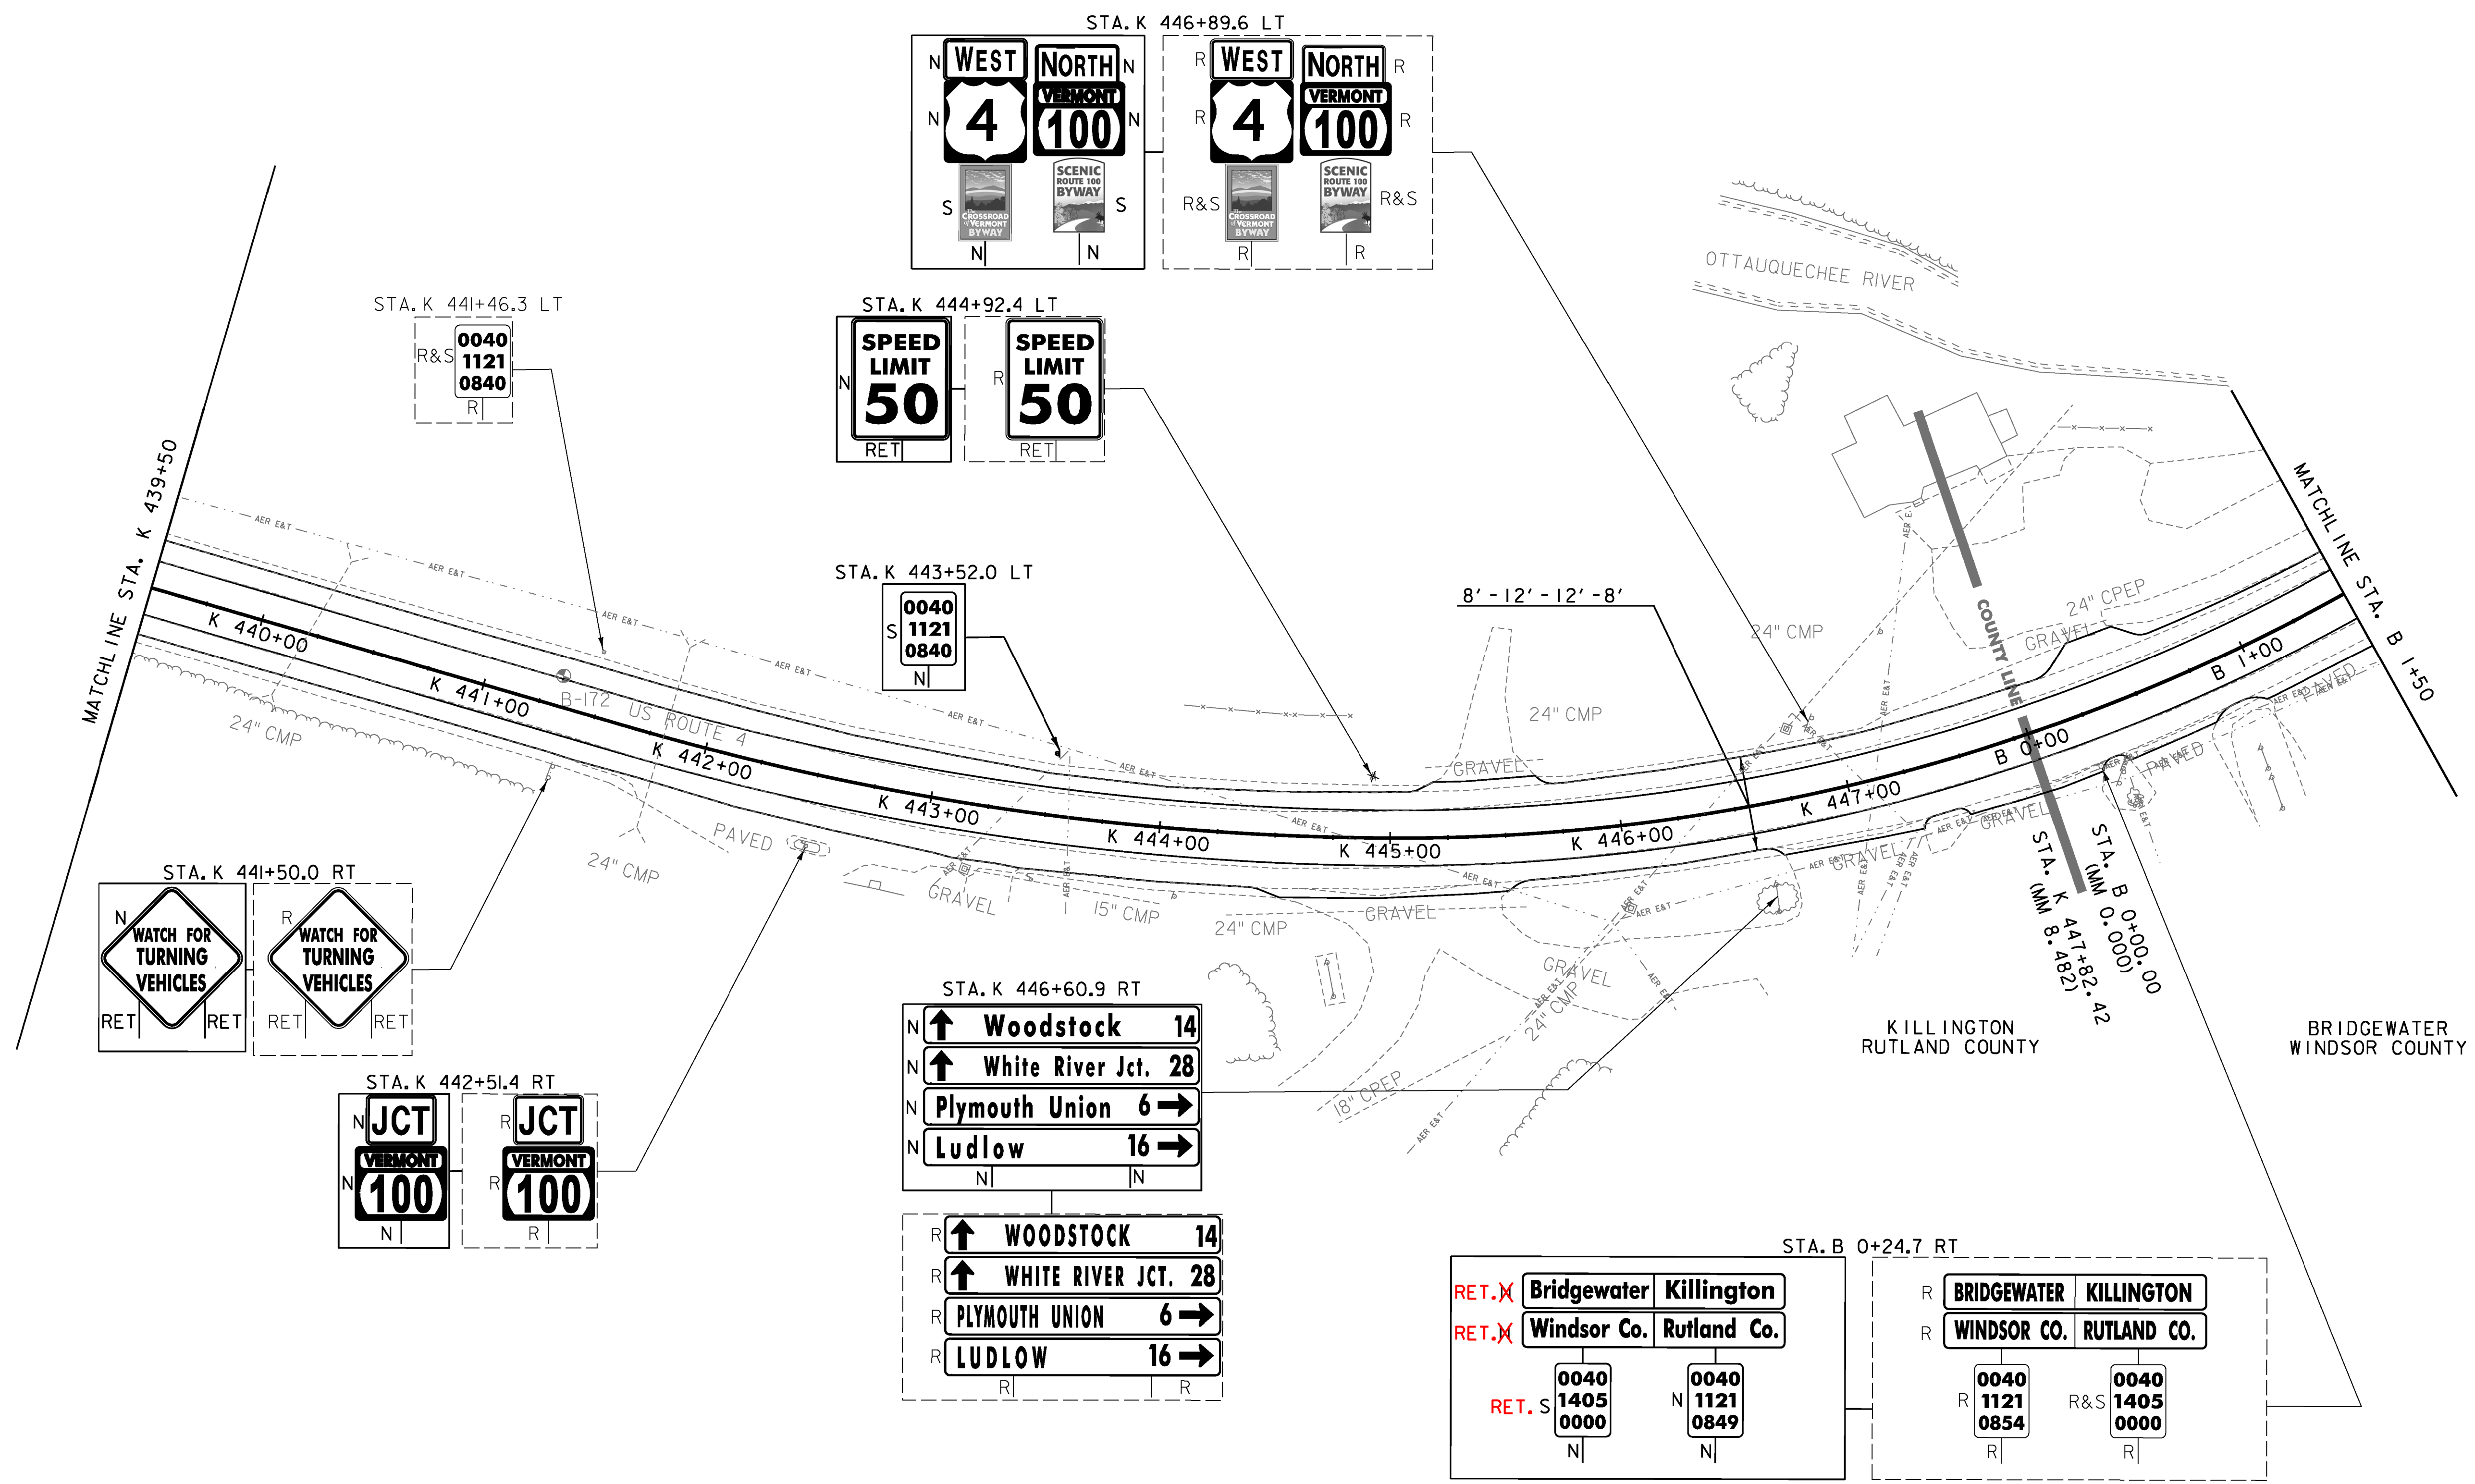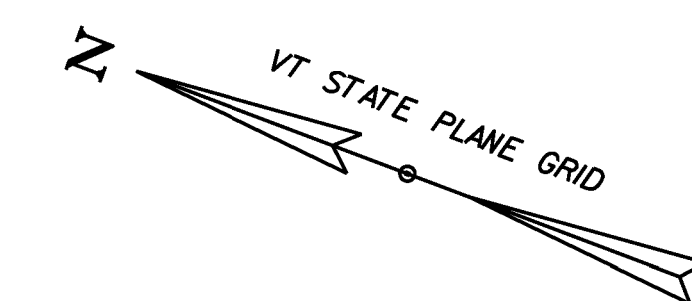

**SIGN LEGEND**  
R = REMOVE  
R&S = REMOVE AND SALVAGE  
RET = RETAIN  
S = SALVAGED  
N = NEW  
B-B = BACK TO BACK  
--- = EXISTING  
— = NEW

NOT TO SCALE

PROJECT NAME: KILLINGTON-WOODSTOCK	
PROJECT NUMBER: ER NH 020-2(38)	
FILE NAME: z13bi92bdr.dgn	PLOT DATE: 3/7/2016
PROJECT LEADER: E. ATKINS	DRAWN BY: I. KHALID
DESIGNED BY: T. BIGELOW/S. MUSTO	CHECKED BY: ATKINS/SOBEL
PLAN SHEET 4	SHEET 31 OF 146