

MILLED RUMBLE STRIPS (CENTERLINE)  
 STA. B 86+95 - B 93+30  
 STA. B 93+70 - B 105+50

STEEL BEAM GUARDRAIL, GALVANIZED  
 STA. B 93+79.3 RT - B 94+01.5 RT



REMOVAL AND DISPOSAL OF GUARDRAIL  
 STA. B 93+79.3 RT - B 94+01.5 RT

TEMPORARY 4 INCH WHITE LINE, PAINT  
DURABLE 4 INCH WHITE LINE, (SEE OPTION ITEMS)  
 (ALL LINES WILL INCLUDE EDGE LINE BREAKS  
 AND RADII FOR SIDE ROADS)  
 STA. B 86+95 - B 105+50 (SOLID LT & RT)

TEMPORARY 4 INCH YELLOW LINE, PAINT  
DURABLE 4 INCH YELLOW LINE, (SEE OPTION ITEMS)  
 (ALL LINES WILL INCLUDE CENTER LINE BREAKS  
 FOR SIDE ROADS)  
 STA. B 86+95 - B 105+50 (SOLID LT & RT)

TEMPORARY 24 INCH STOP BAR, PAINT  
DURABLE 24 INCH STOP BAR, (SEE OPTION ITEMS)  
 STA. B 93+50 RT

TEMPORARY LETTER OR SYMBOL, PAINT  
DURABLE LETTER OR SYMBOL, (SEE OPTION ITEMS)  
 STA. B 93+50 RT "STOP" (4 EA)  
 REMOVING SIGNS  
 AS SHOWN - 6

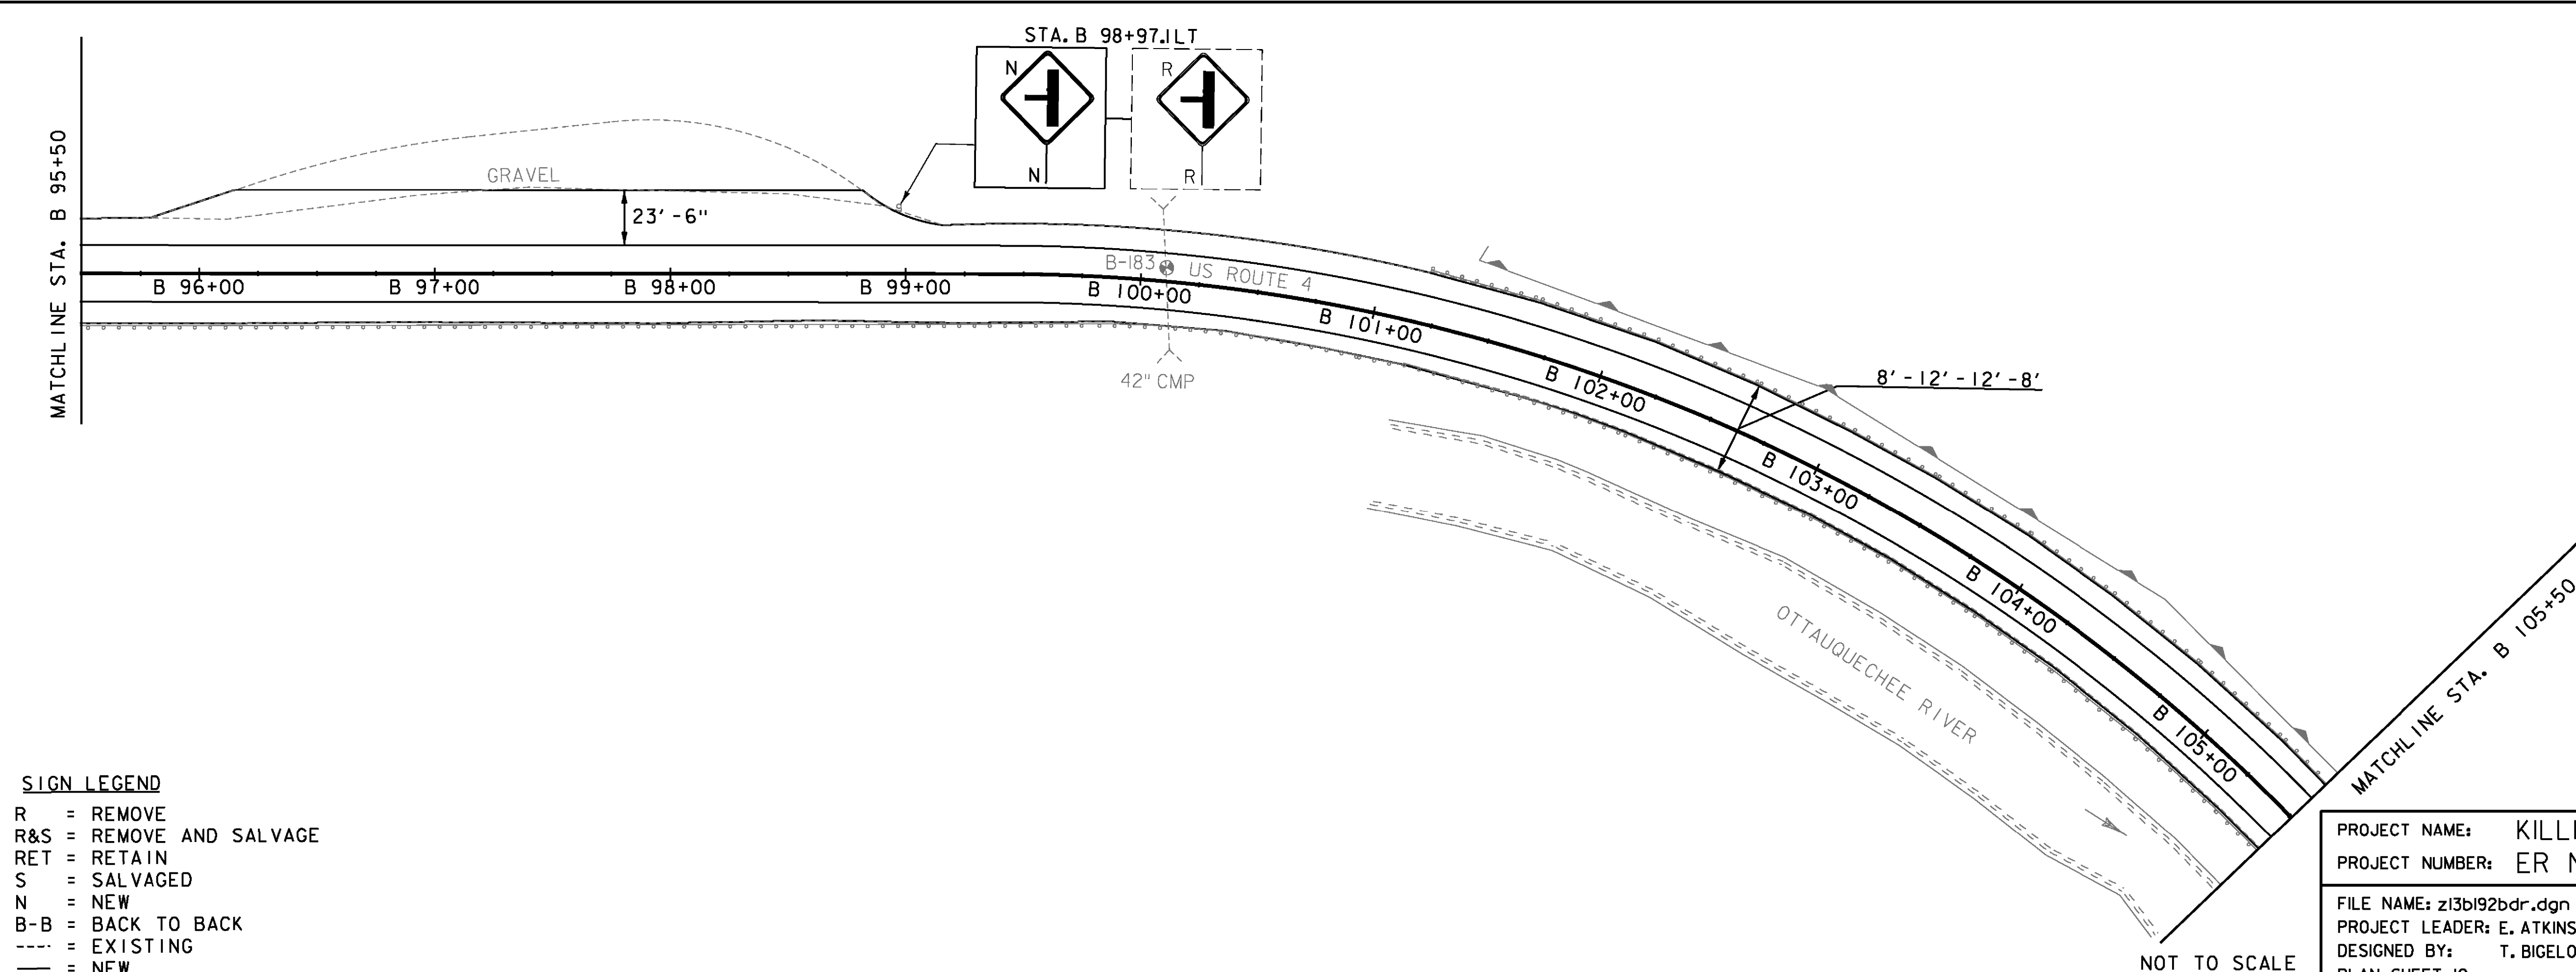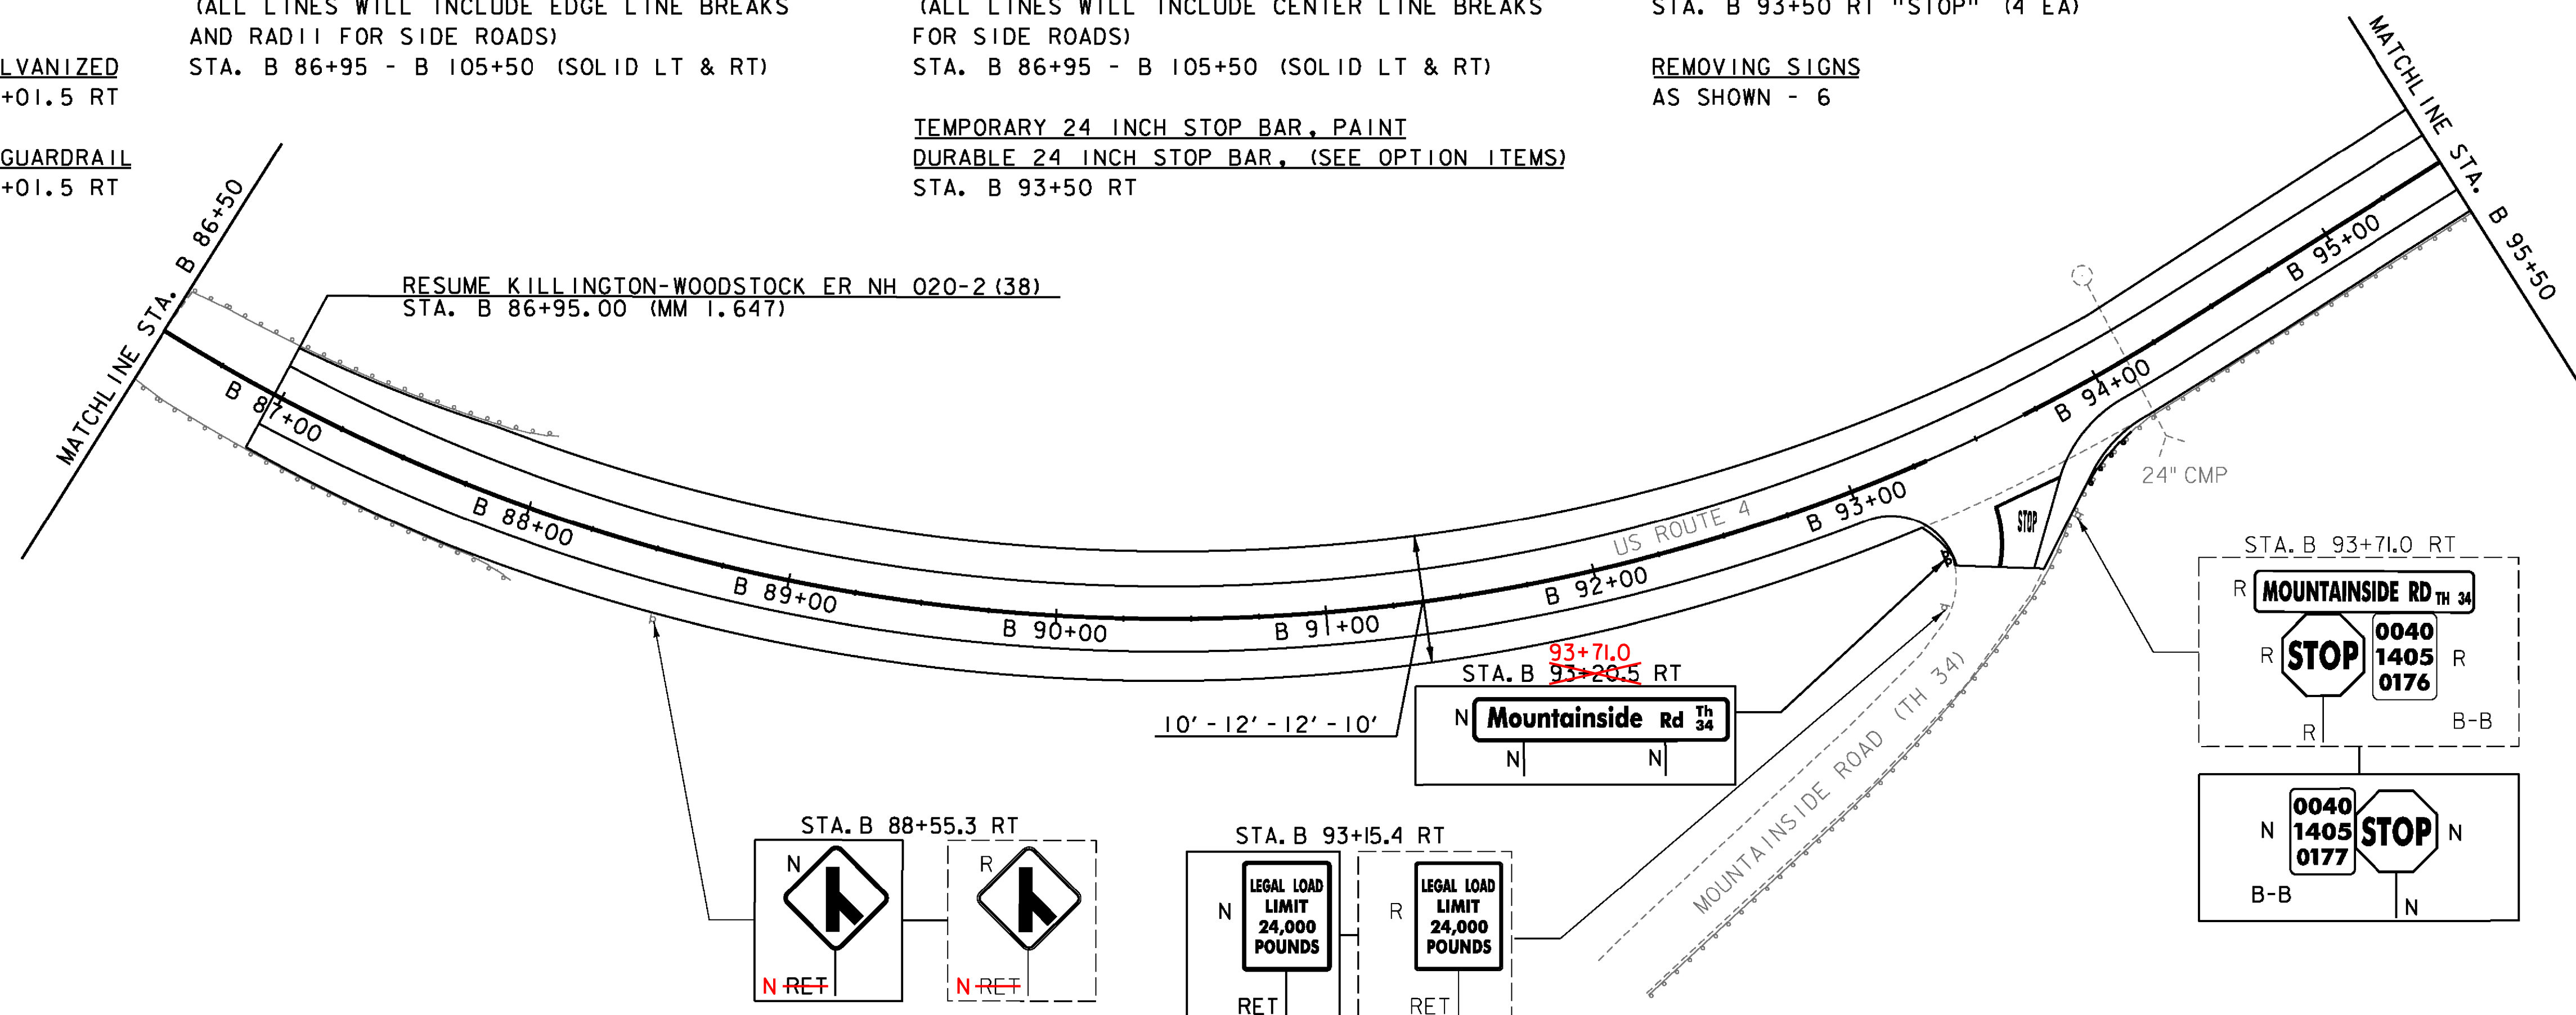

**SIGN LEGEND**  
 R = REMOVE  
 R&S = REMOVE AND SALVAGE  
 RET = RETAIN  
 S = SALVAGED  
 N = NEW  
 B-B = BACK TO BACK  
 --- = EXISTING  
 — = NEW

PROJECT NAME: KILLINGTON-WOODSTOCK  
 PROJECT NUMBER: ER NH 020-2(38)

FILE NAME: z13b192bdr.dgn  
 PROJECT LEADER: E. ATKINS  
 DESIGNED BY: T. BIGELOW/S. MUSTO  
 PLAN SHEET 10

PLOT DATE: 3/7/2016  
 DRAWN BY: I. KHALID  
 CHECKED BY: ATKINS/SOBEL  
 SHEET 37 OF 146

NOT TO SCALE