

MILLED RUMBLE STRIPS (CENTERLINE)

STA. B 203+50 - B 210+55  
 STA. B 210+95 - B 222+50

TEMPORARY 24 INCH STOP BAR, PAINT

DURABLE 24 INCH STOP BAR, (SEE OPTION ITEMS)  
 STA. B 210+60 LT

TEMPORARY LETTER OR SYMBOL, PAINT

DURABLE LETTER OR SYMBOL, (SEE OPTION ITEMS)  
 STA. B 210+59 LT "STOP" (4 EA)

TEMPORARY 4 INCH WHITE LINE, PAINT



DURABLE 4 INCH WHITE LINE, (SEE OPTION ITEMS)  
 (ALL LINES WILL INCLUDE EDGE LINE BREAKS  
 AND RADI1 FOR SIDE ROADS)  
 STA. B 203+50 - B 222+50 (SOLID LT & RT)

TEMPORARY 4 INCH YELLOW LINE, PAINT

DURABLE 4 INCH YELLOW LINE, (SEE OPTION ITEMS)  
 (ALL LINES WILL INCLUDE CENTER LINE BREAKS  
 FOR SIDE ROADS)  
 STA. B 203+50 - B 212+41 (SOLID LT & RT)  
 STA. B 212+41 - B 219+00 (SOLID LT & DASHED RT)  
 STA. B 219+00 - B 219+80 (DASHED)  
 STA. B 219+80 - B 222+50 (DASHED LT & SOLID RT)

REMOVING SIGNS

AS SHOWN - 6

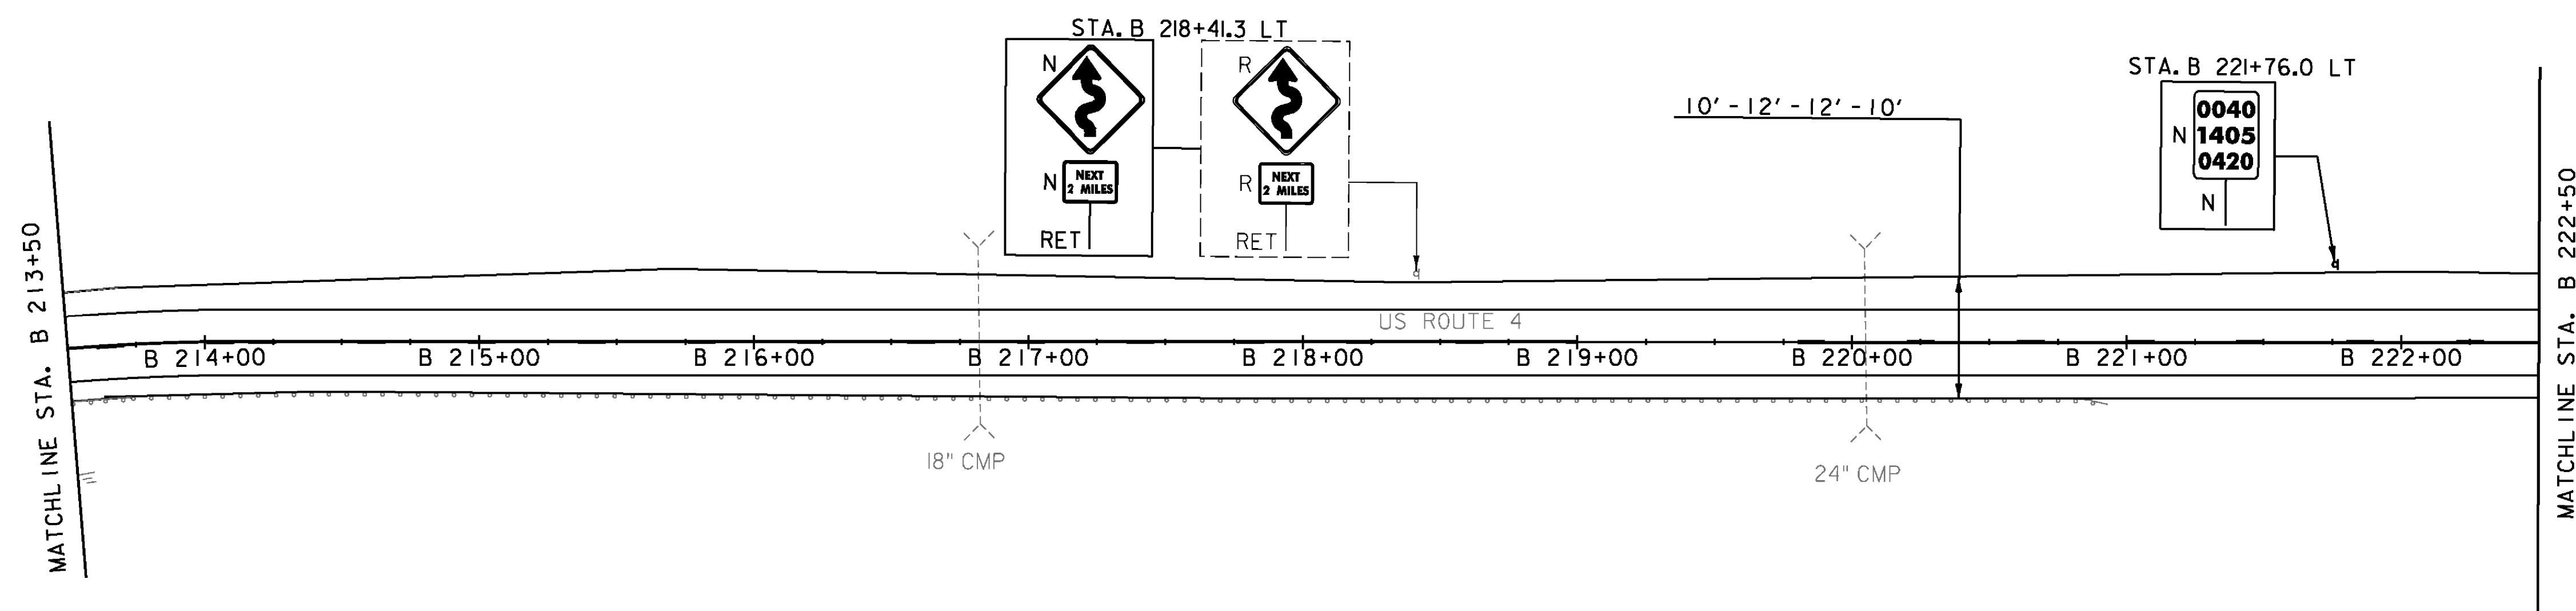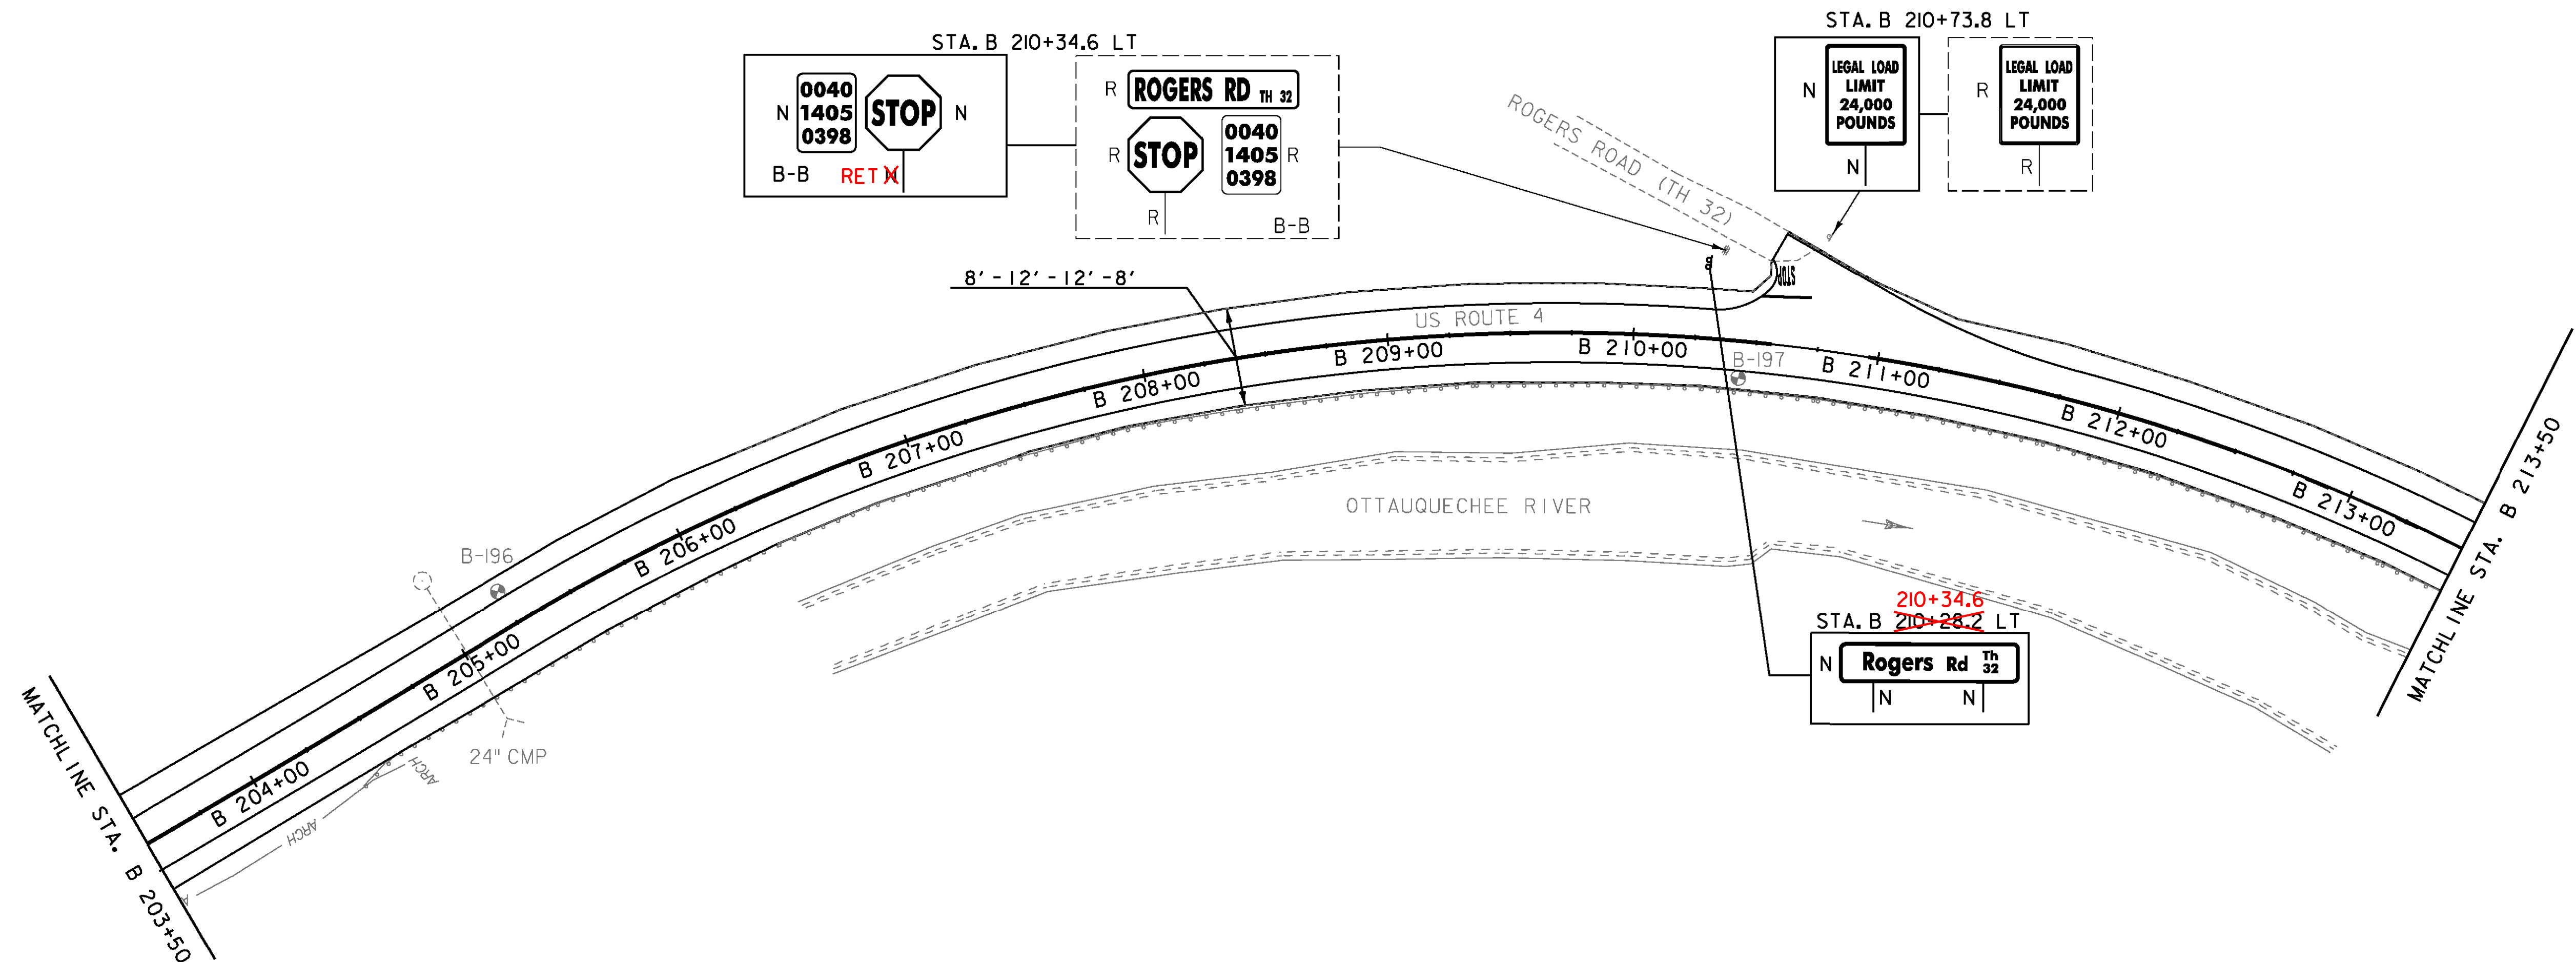

SIGN LEGEND

R = REMOVE  
 R&S = REMOVE AND SALVAGE  
 RET = RETAIN  
 S = SALVAGED  
 N = NEW  
 B-B = BACK TO BACK  
 --- = EXISTING  
 — = NEW

PROJECT NAME: KILLINGTON-WOODSTOCK  
 PROJECT NUMBER: ER NH 020-2(38)

FILE NAME: z13b192bdr.dgn  
 PROJECT LEADER: E. ATKINS  
 DESIGNED BY: T. BIGELOW/S. MUSTO  
 PLAN SHEET 17

PLOT DATE: 3/7/2016  
 DRAWN BY: I. KHALID  
 CHECKED BY: ATKINS/SOBEL  
 SHEET 44 OF 146

NOT TO SCALE