

REMOVE AND RESET GUARDRAIL  
 STA. B 311+50.0 RT - B 321+50.0 RT

TEMPORARY 4 INCH WHITE LINE, PAINT  
 DURABLE 4 INCH WHITE LINE, (SEE OPTION ITEMS)  
 (ALL LINES WILL INCLUDE EDGE LINE BREAKS  
 AND RADIUS FOR SIDE ROADS)  
 STA. B 311+50 - B 321+50 (SOLID LT & RT)



TEMPORARY 4 INCH YELLOW LINE, PAINT  
 DURABLE 4 INCH YELLOW LINE, (SEE OPTION ITEMS)  
 (ALL LINES WILL INCLUDE CENTER LINE BREAKS  
 FOR SIDE ROADS)  
 STA. B 311+50 - B 321+50 (SOLID LT & RT)

TEMPORARY 24 INCH STOP BAR, PAINT  
 DURABLE 24 INCH STOP BAR, (SEE OPTION ITEMS)  
 STA. B 313+07 LT

TEMPORARY LETTER OR SYMBOL, PAINT  
 DURABLE LETTER OR SYMBOL, (SEE OPTION ITEMS)  
 STA. B 313+07 LT "STOP" (4 EA)

REMOVING SIGNS  
 AS SHOWN - 8

ERECTING SALVAGED SIGNS  
 AS SHOWN - 2

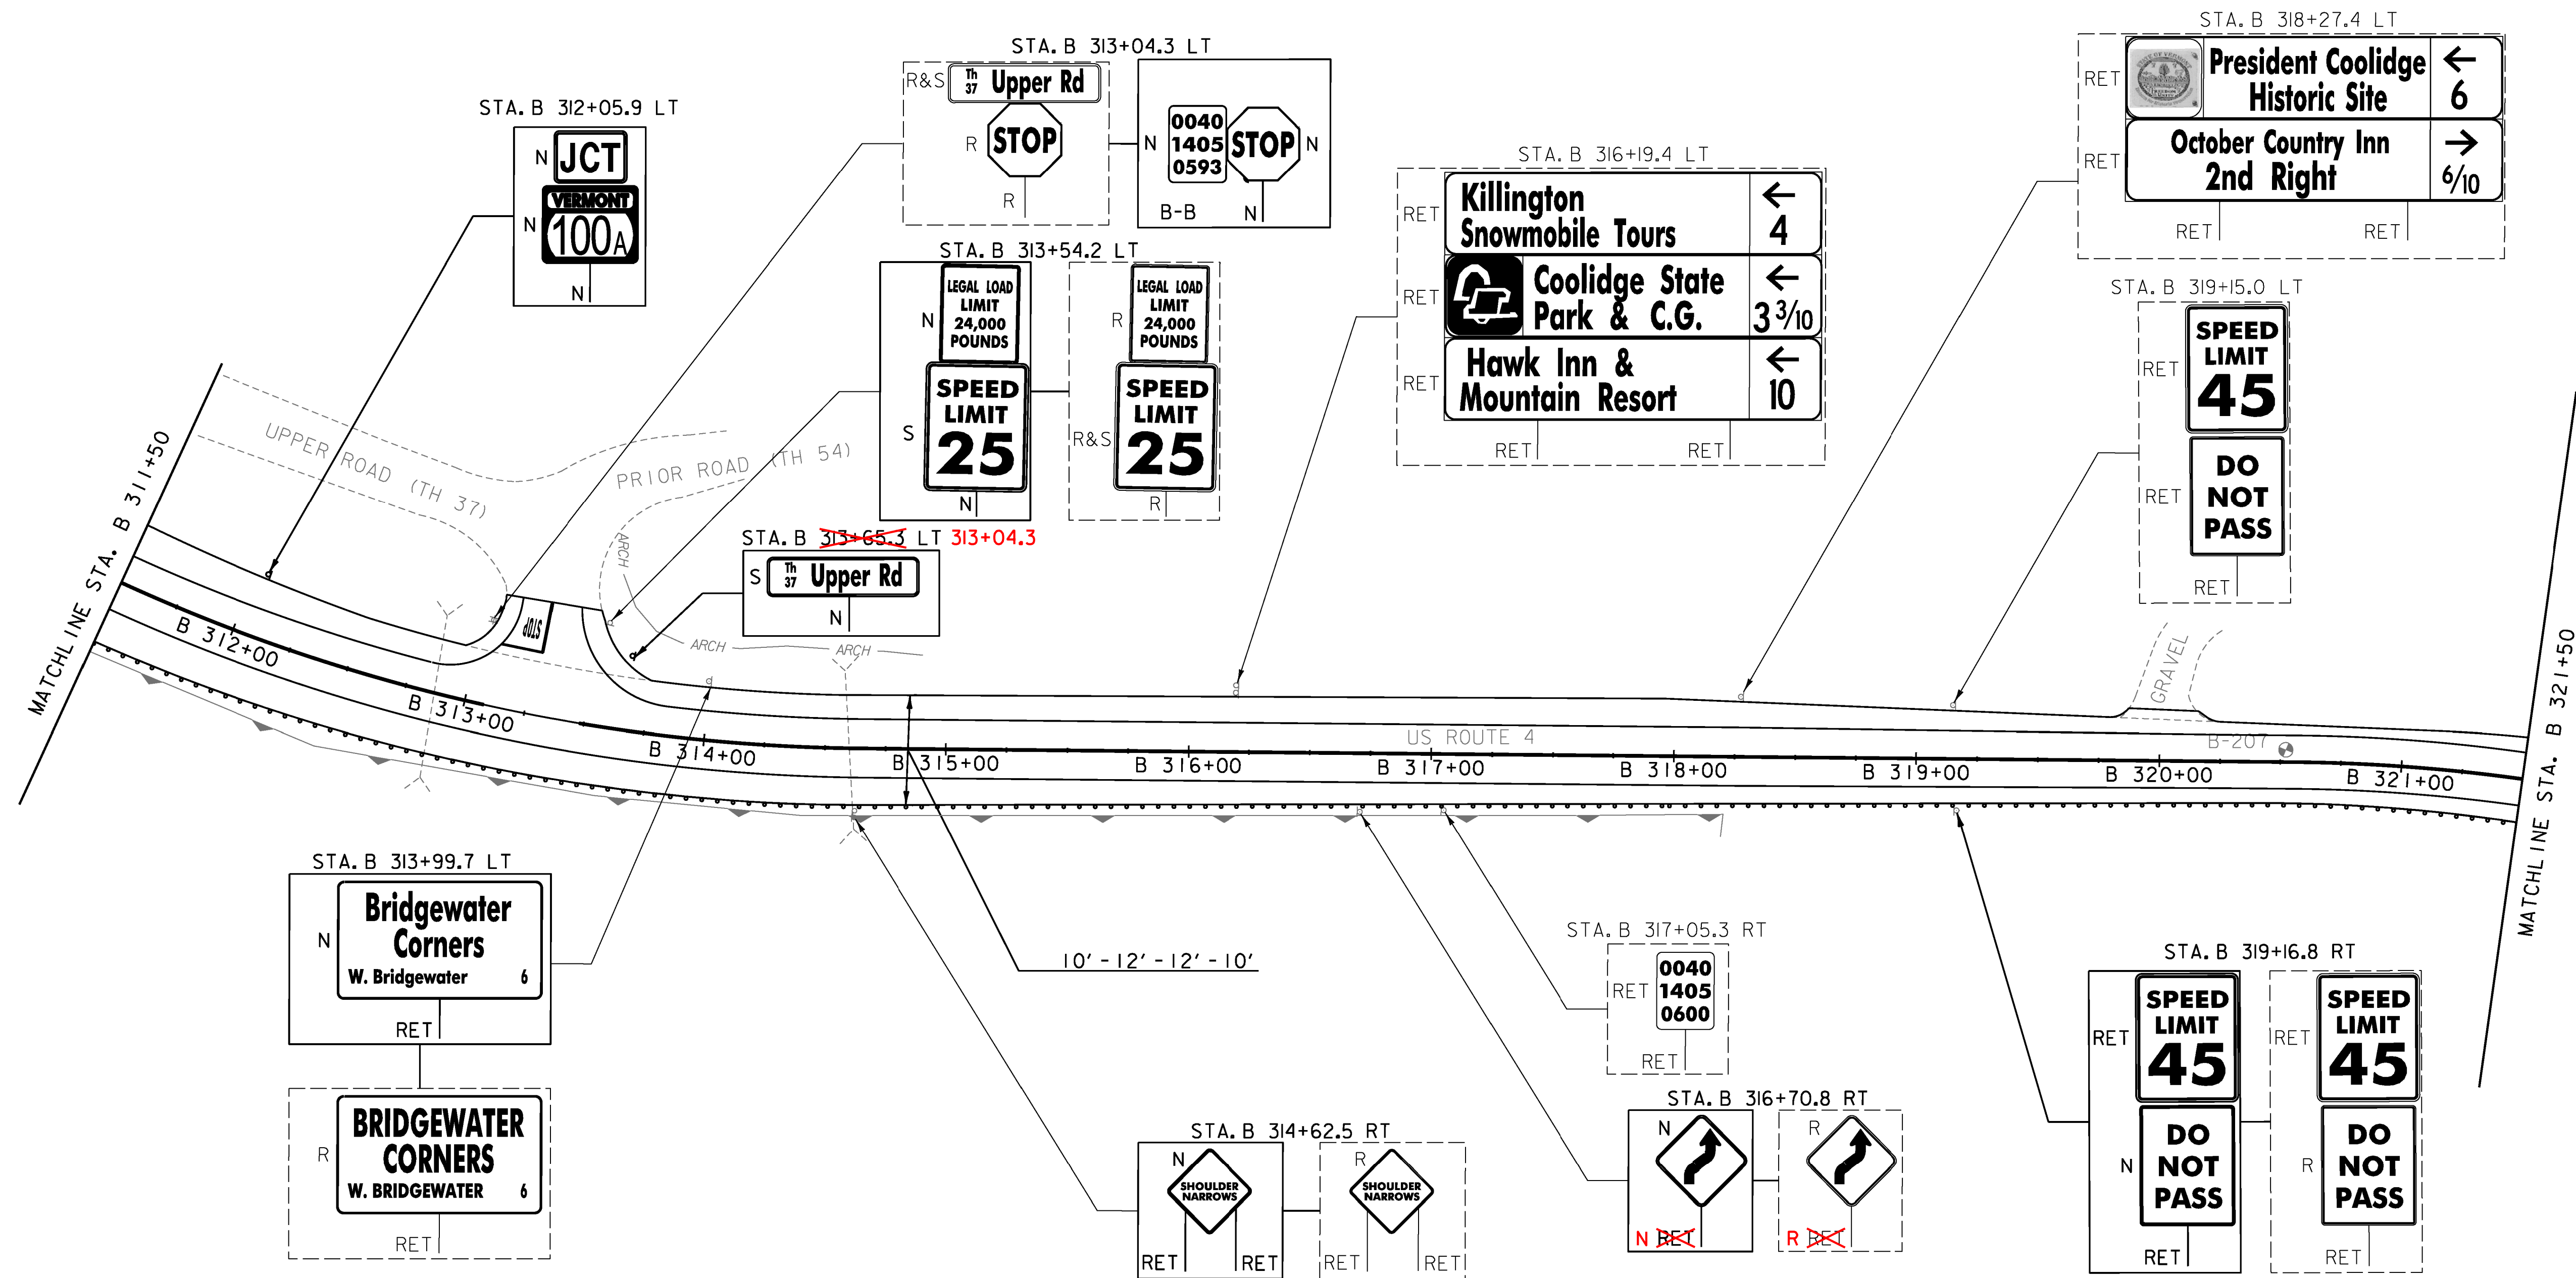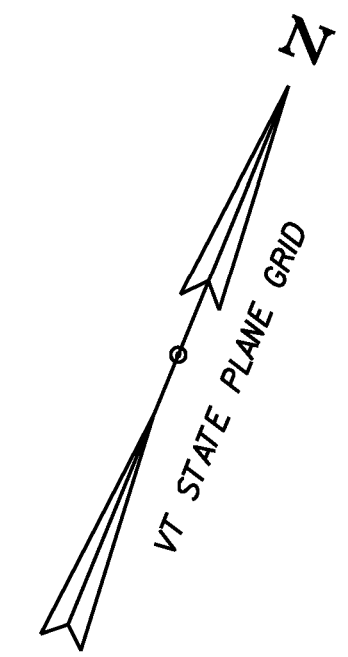

**SIGN LEGEND**

- R = REMOVE
- R&S = REMOVE AND SALVAGE
- RET = RETAIN
- S = SALVAGED
- N = NEW
- B-B = BACK TO BACK
- = EXISTING
- = NEW

PROJECT NAME: KILLINGTON-WOODSTOCK  
 PROJECT NUMBER: ER NH 020-2(38)

FILE NAME: z13bi92bdr.dgn  
 PROJECT LEADER: E. ATKINS  
 DESIGNED BY: T. BIGELOW/S. MUSTO  
 PLAN SHEET 24

PLOT DATE: 3/7/2016  
 DRAWN BY: I. KHALID  
 CHECKED BY: ATKINS/SOBEL  
 SHEET 51 OF 146

NOT TO SCALE