

CHANGING ELEVATION OF SEWER MANHOLES
 STA. B 383+72.9 LT



TEMPORARY 4 INCH YELLOW LINE, PAINT
 DURABLE 4 INCH YELLOW LINE, (SEE OPTION ITEMS)
 (ALL LINES WILL INCLUDE CENTER LINE BREAKS
 FOR SIDE ROADS)
 STA. B 378+50 - B 387+50 (SOLID LT & RT)

TEMPORARY 24 INCH STOP BAR, PAINT
 DURABLE 24 INCH STOP BAR, (SEE OPTION ITEMS)
 STA. B 383+70 LT

REMOVING SIGNS
 AS SHOWN - 4

TEMPORARY 4 INCH WHITE LINE, PAINT
 DURABLE 4 INCH WHITE LINE, (SEE OPTION ITEMS)
 (ALL LINES WILL INCLUDE EDGE LINE BREAKS
 AND RADIUS FOR SIDE ROADS)
 STA. B 378+50 - B 387+50 (SOLID LT & RT)

TEMPORARY LETTER OR SYMBOL, PAINT
 DURABLE LETTER OR SYMBOL, (SEE OPTION ITEMS)
 STA. B 383+70 LT "STOP" (4 EA)

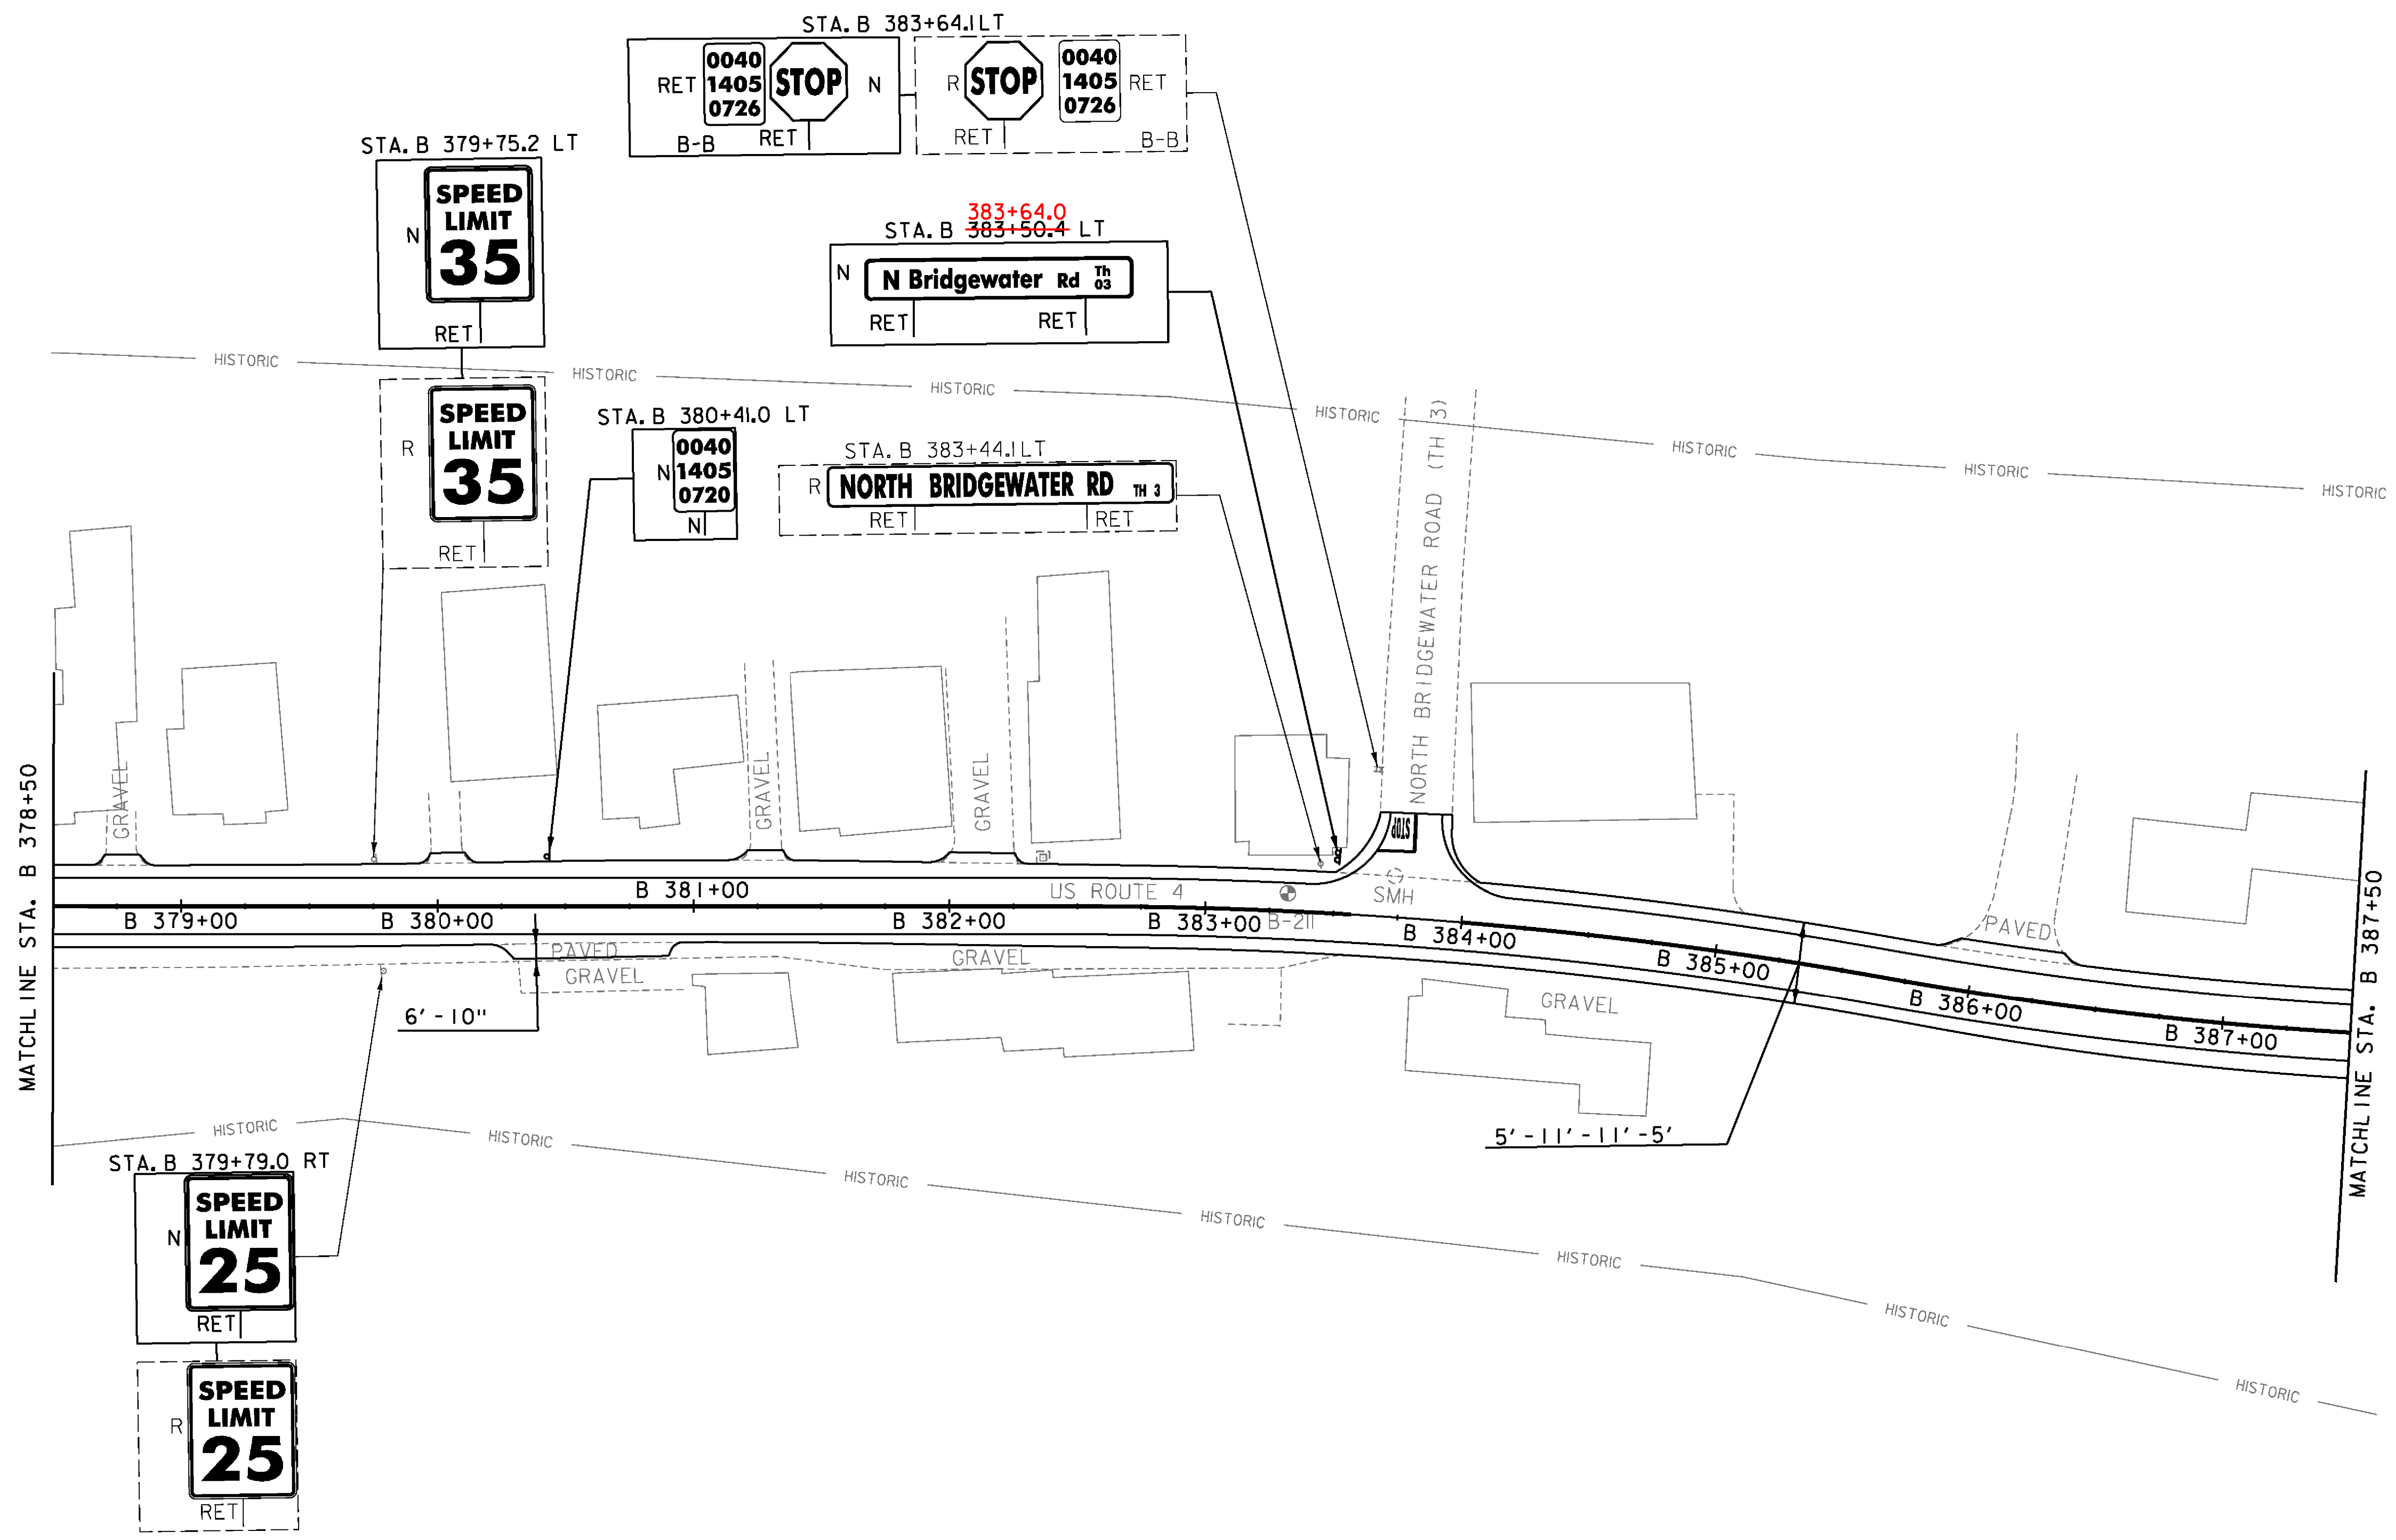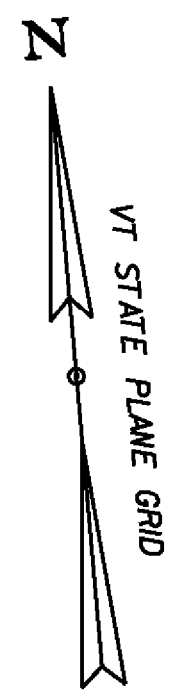

SIGN LEGEND

- R = REMOVE
- R&S = REMOVE AND SALVAGE
- RET = RETAIN
- S = SALVAGED
- N = NEW
- B-B = BACK TO BACK
- = EXISTING
- = NEW

PROJECT NAME: KILLINGTON-WOODSTOCK
 PROJECT NUMBER: ER NH 020-2(38)

FILE NAME: z13b192bdr.dgn
 PROJECT LEADER: E. ATKINS
 DESIGNED BY: T. BIGELOW/S. MUSTO
 PLAN SHEET 28

PLOT DATE: 3/7/2016
 DRAWN BY: I. KHALID
 CHECKED BY: ATKINS/SOBEL
 SHEET 55 OF 146

NOT TO SCALE