

MILLED RUMBLE STRIPS (CENTERLINE)
 STA. W 160+50 - W 164+00

TEMPORARY 4 INCH WHITE LINE, PAINT
 DURABLE 4 INCH WHITE LINE, (SEE OPTION ITEMS)
 (ALL LINES WILL INCLUDE EDGE LINE BREAKS
 AND RADI FOR SIDE ROADS)
 STA. W 160+50 - W 170+50 (SOLID LT & RT)
 STA. W 164+83 - W 166+40 (SOLID LT)
 STA. W 166+40 - W 167+94 (DOTTED LT)



TEMPORARY 4 INCH YELLOW LINE, PAINT
 DURABLE 4 INCH YELLOW LINE, (SEE OPTION ITEMS)
 (ALL LINES WILL INCLUDE CENTER LINE BREAKS
 FOR SIDE ROADS)
 STA. W 160+50 - W 170+50 (SOLID LT & RT)
 DURABLE 8 INCH YELLOW LINE, (SEE OPTION ITEMS)
 STA. W 162+00 - W 164+50 (GORE)
 STA. W 166+75 - W 170+50 (GORE)

TEMPORARY 24 INCH STOP BAR, PAINT
 DURABLE 24 INCH STOP BAR, (SEE OPTION ITEMS)
 STA. W 164+80 RT

TEMPORARY LETTER OR SYMBOL, PAINT
 DURABLE LETTER OR SYMBOL, (SEE OPTION ITEMS)
 STA. W 164+80 RT "STOP" (4 EA)
 STA. W 165+10 LT LEFT ARROW (1 EA)
 STA. W 165+50 LT "ONLY" (4 EA)
 STA. W 165+90 LT LEFT ARROW (1 EA)
 STA. W 166+30 LT "ONLY" (4 EA)

REMOVING SIGNS
 AS SHOWN - 10

RECTIFYING SALVAGED SIGNS
 AS SHOWN - 1

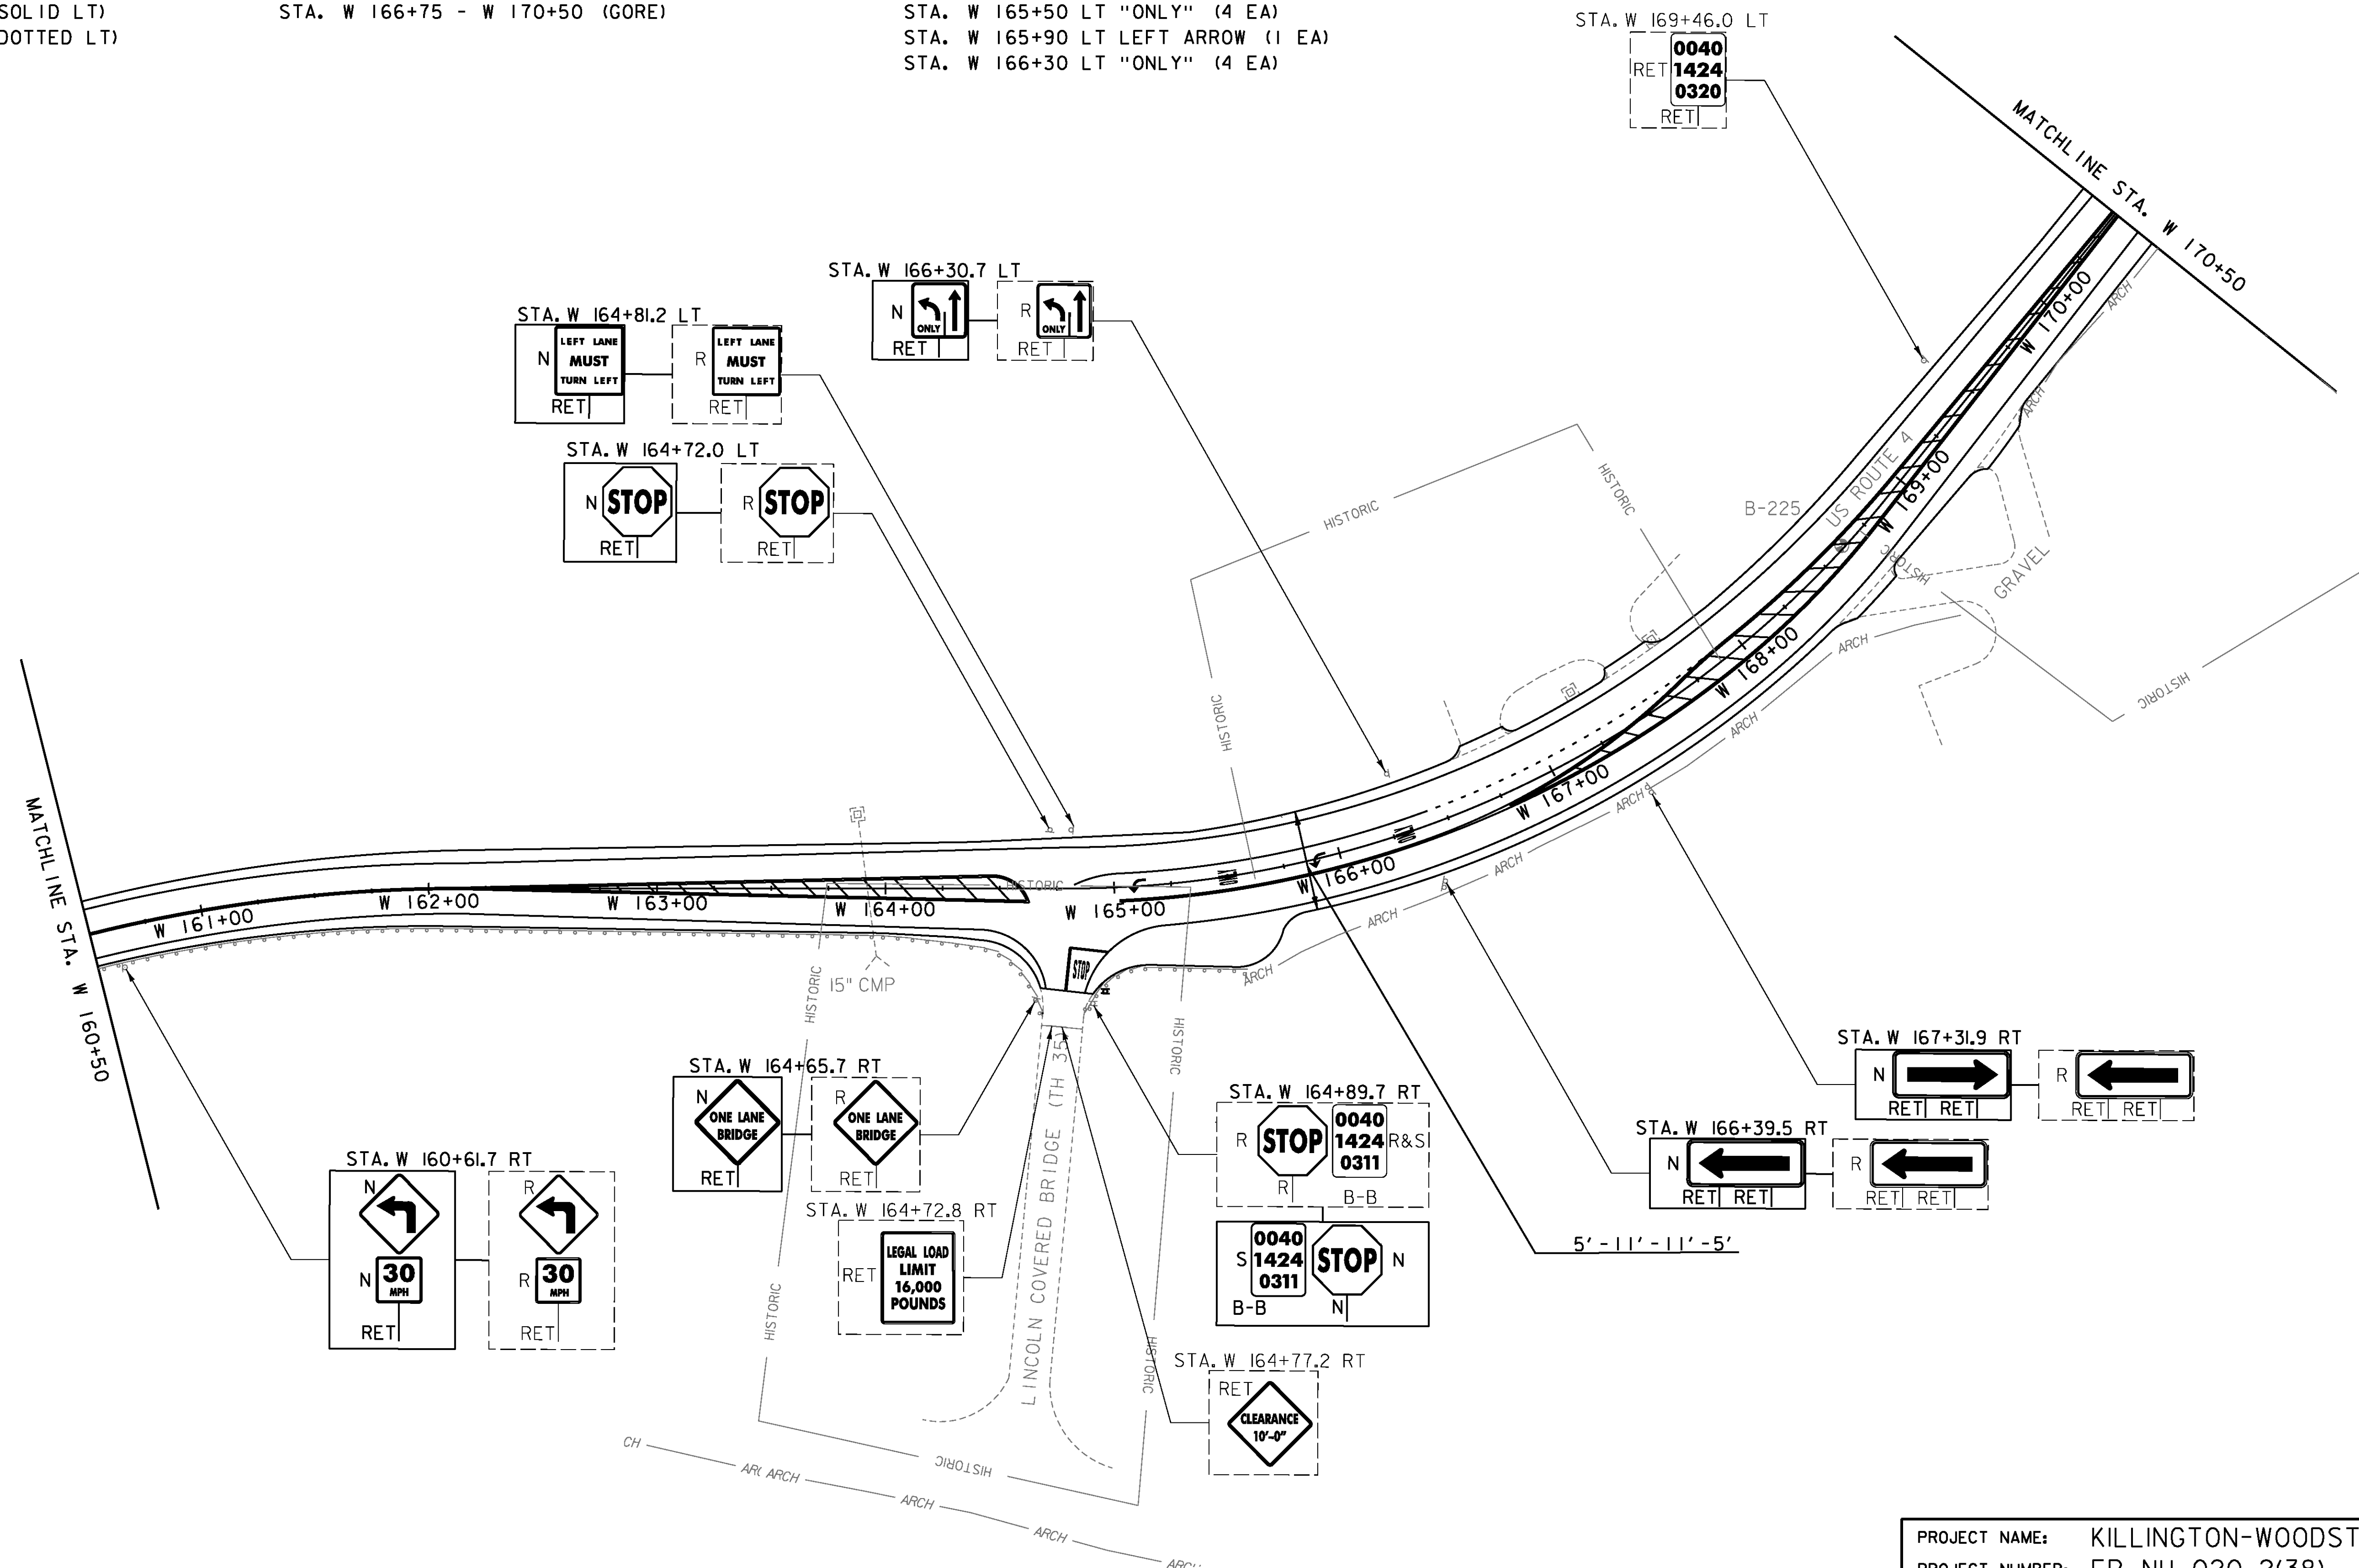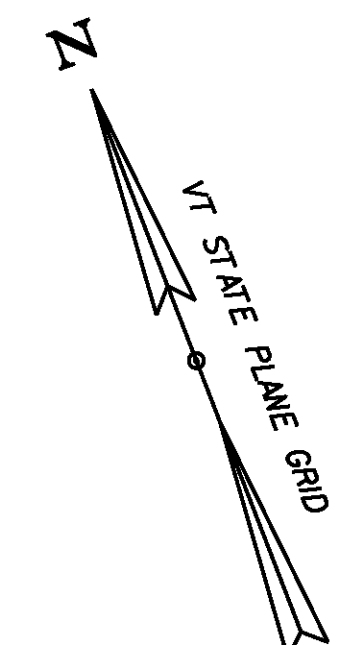

SIGN LEGEND
 R = REMOVE
 R&S = REMOVE AND SALVAGE
 RET = RETAIN
 S = SALVAGED
 N = NEW
 B-B = BACK TO BACK
 --- = EXISTING
 — = NEW

PROJECT NAME: KILLINGTON-WOODSTOCK
 PROJECT NUMBER: ER NH 020-2(38)
 FILE NAME: z13bi92bdr.dgn
 PROJECT LEADER: E. ATKINS
 DESIGNED BY: T. BIGELOW/S. MUSTO
 PLAN SHEET 39
 PLOT DATE: 3/7/2016
 DRAWN BY: I. KHALID
 CHECKED BY: ATKINS/SOBEL
 SHEET 66 OF 146

NOT TO SCALE