

TEMPORARY 4 INCH WHITE LINE, PAINT
 DURABLE 4 INCH WHITE LINE, (SEE OPTION ITEMS)
 (ALL LINES WILL INCLUDE EDGE LINE BREAKS
 AND RADII FOR SIDE ROADS)
 STA. W 229+50 - W 239+50 (SOLID LT & RT)

TEMPORARY 8 INCH WHITE LINE, PAINT
 DURABLE 8 INCH WHITE LINE, (SEE OPTION ITEMS)
 STA. W 232+19 - W 232+39 (GORE)



TEMPORARY LETTER OR SYMBOL, PAINT
 DURABLE LETTER OR SYMBOL, (SEE OPTION ITEMS)
 STA. W 231+48 LT "STOP" (4 EA)
 STA. W 232+05 LT "STOP" (4 EA)
 STA. W 235+75 RT "SCHOOL" (6 EA)

TEMPORARY 4 INCH YELLOW LINE, PAINT
 DURABLE 4 INCH YELLOW LINE, (SEE OPTION ITEMS)
 (ALL LINES WILL INCLUDE CENTER LINE BREAKS
 FOR SIDE ROADS)
 STA. W 229+50 - W 239+50 (SOLID LT & RT)

TEMPORARY 24 INCH STOP BAR, PAINT
 DURABLE 24 INCH STOP BAR, (SEE OPTION ITEMS)
 STA. W 231+48 LT
 STA. W 232+05 LT

REMOVING SIGNS
 AS SHOWN - 18

ERECTING SALVAGED SIGNS
 AS SHOWN - 2

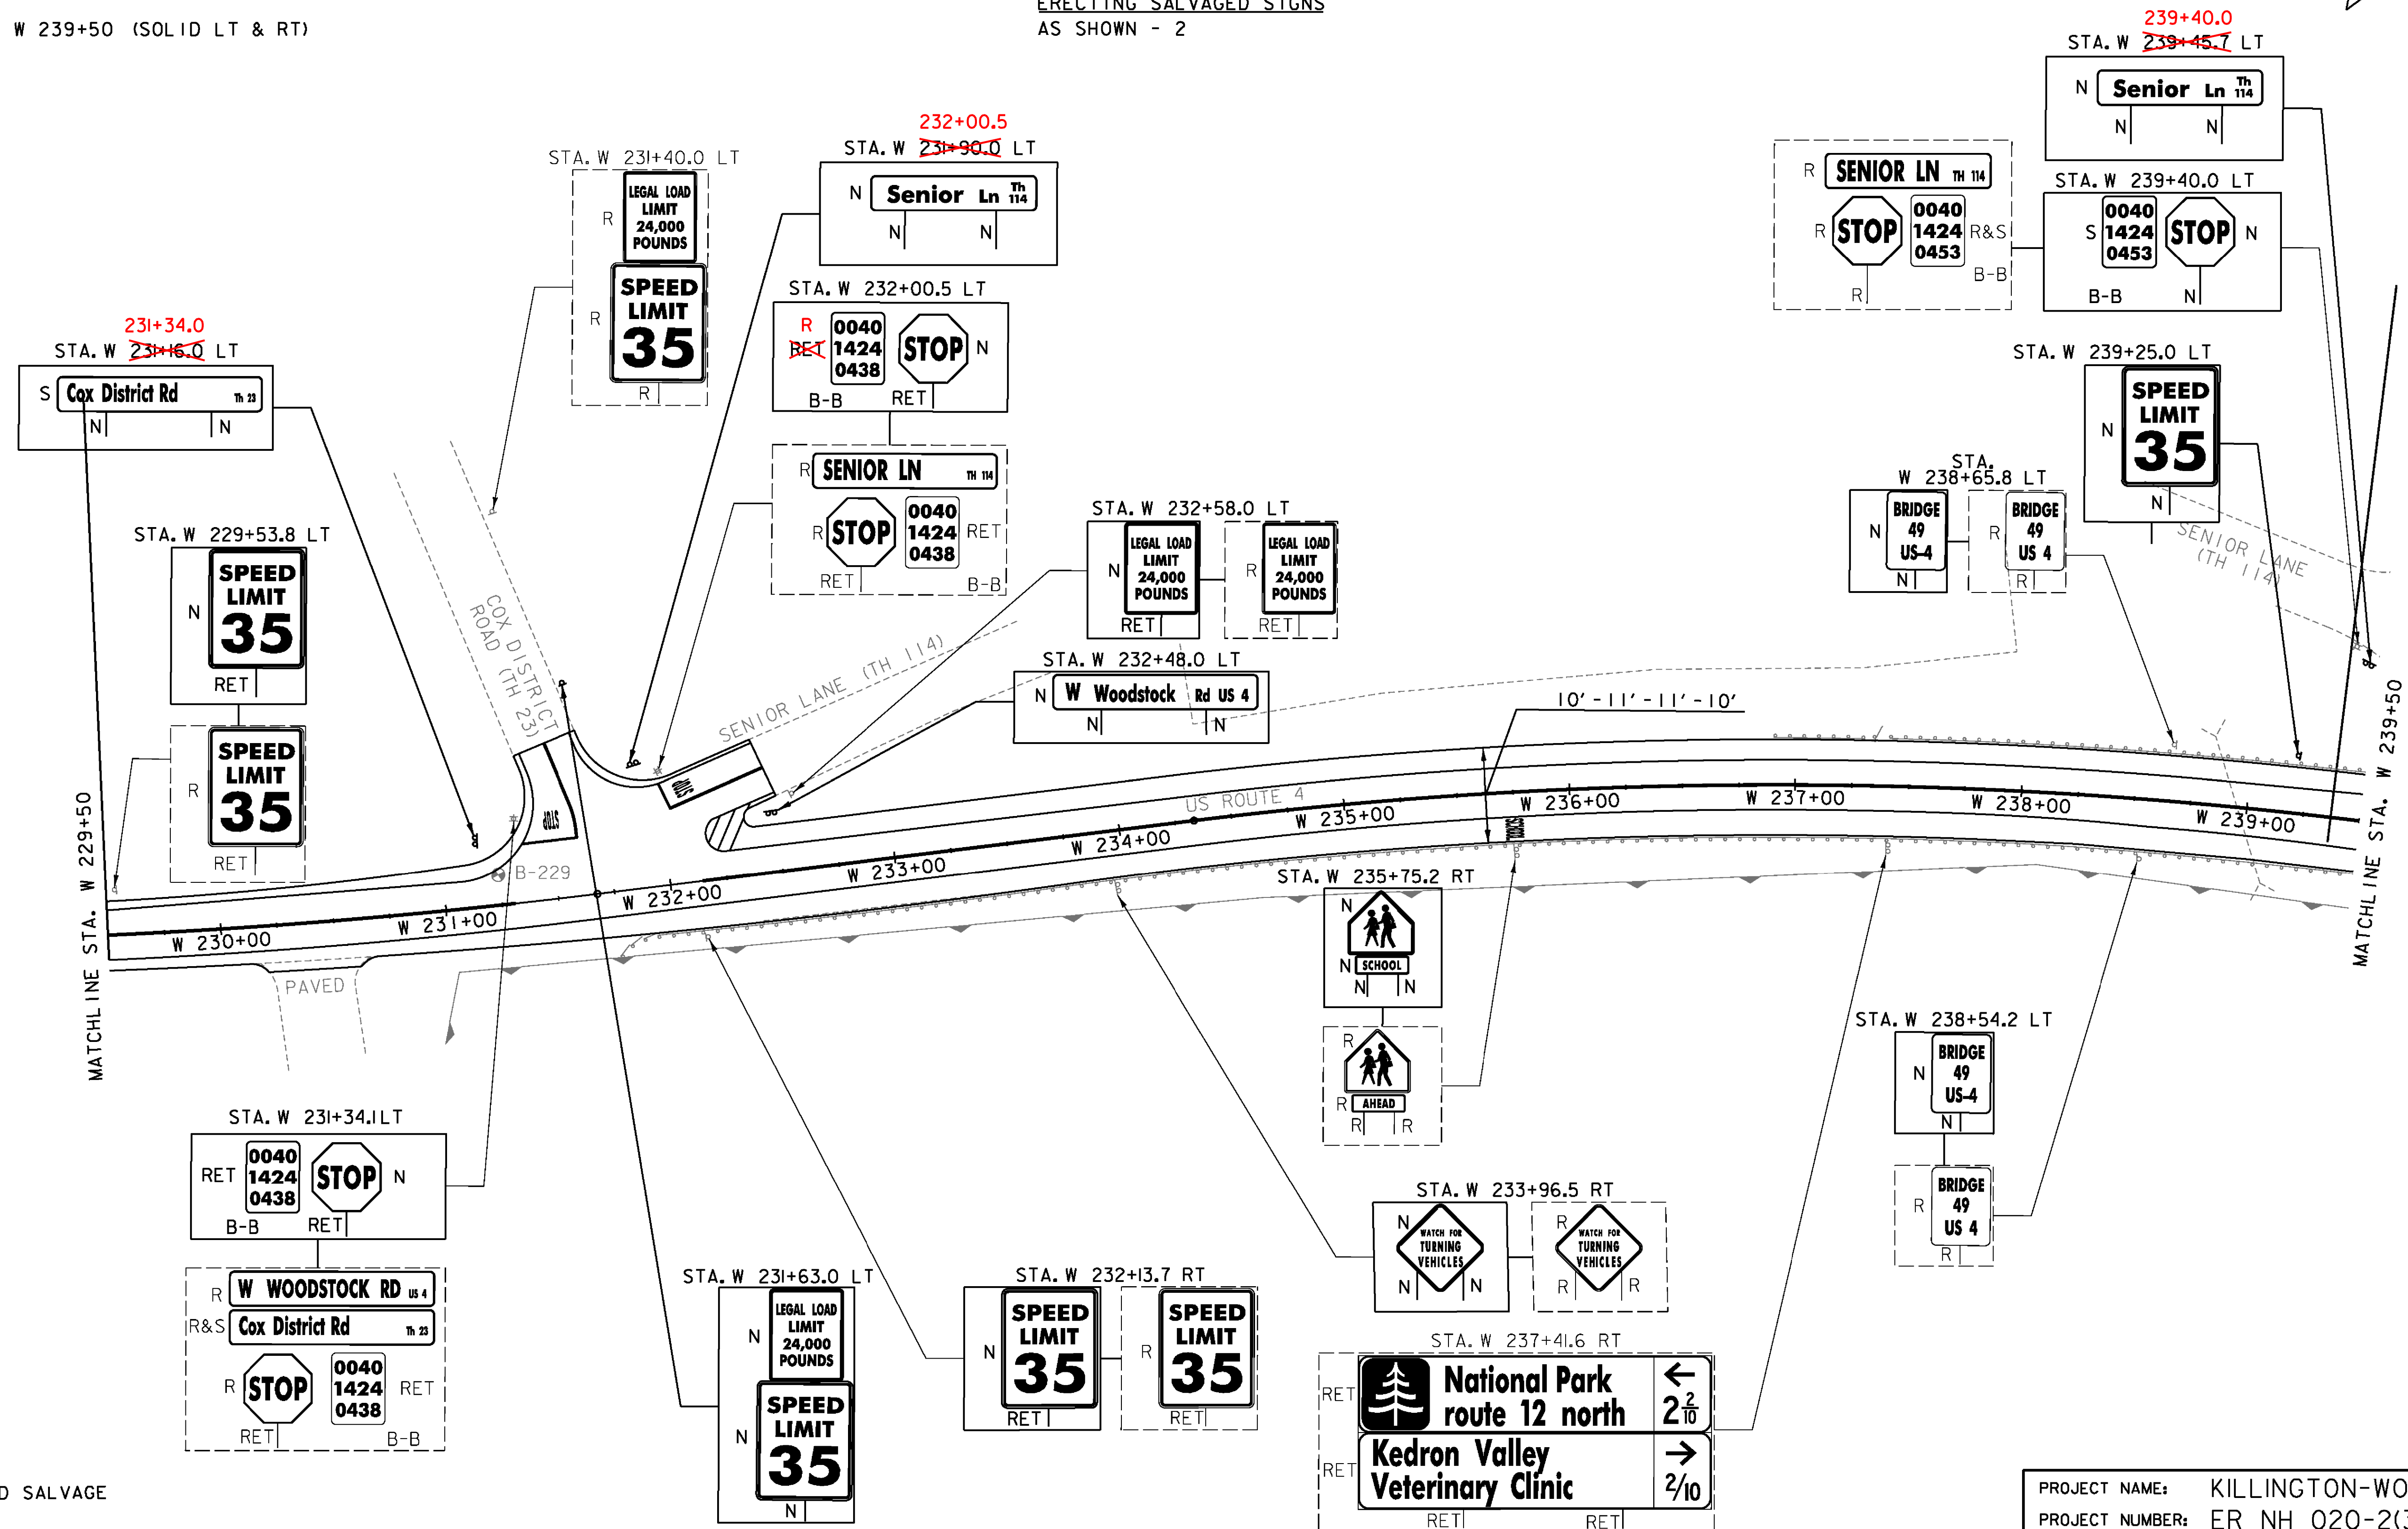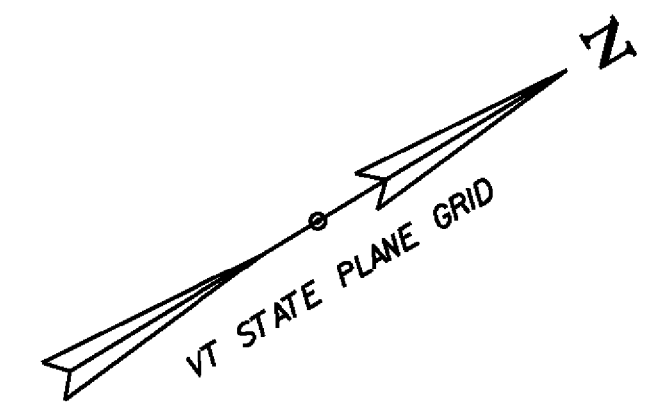

SIGN LEGEND
 R = REMOVE
 R&S = REMOVE AND SALVAGE
 RET = RETAIN
 S = SALVAGED
 N = NEW
 B-B = BACK TO BACK
 --- = EXISTING
 — = NEW

PROJECT NAME: KILLINGTON-WOODSTOCK
 PROJECT NUMBER: ER NH 020-2(38)
 FILE NAME: z13bi92bdr.dgn
 PROJECT LEADER: E. ATKINS
 DESIGNED BY: T. BIGELOW/S. MUSTO
 PLAN SHEET 44
 PLOT DATE: 3/7/2016
 DRAWN BY: I. KHALID
 CHECKED BY: ATKINS/SOBEI
 SHEET 71 OF 146

NOT TO SCALE