

TEMPORARY 4 INCH WHITE LINE, PAINT
DURABLE 4 INCH WHITE LINE, (SEE OPTION ITEMS)
 (ALL LINES WILL INCLUDE EDGE LINE BREAKS AND RADII FOR SIDE ROADS)
 STA. W 239+50 - W 249+50 (SOLID LT & RT)
 STA. W 242+60 - W 244+50 (SOLID LT)
 STA. W 244+50 - W 245+75 (DOTTED LT)

TEMPORARY 8 INCH YELLOW LINE, PAINT
DURABLE 8 INCH YELLOW LINE, (SEE OPTION ITEMS)
 STA. W 240+50 - W 242+29 (GORE)
 STA. W 244+75 - W 247+75 (GORE)

TEMPORARY 24 INCH STOP BAR, PAINT
DURABLE 24 INCH STOP BAR, (SEE OPTION ITEMS)
 STA. W 239+75 LT
 STA. W 242+55 RT



TEMPORARY CROSSWALK MARKING PAINT
DURABLE CROSSWALK MARKING, (SEE OPTION ITEMS)
 STA. W 248+33

REMOVING SIGNS
 AS SHOWN - 12

ERECTING SALVAGED SIGNS
 AS SHOWN - 1

TEMPORARY LETTER OR SYMBOL, PAINT
DURABLE LETTER OR SYMBOL, (SEE OPTION ITEMS)
 STA. W 239+75 LT "STOP" (4 EA)
 STA. W 242+55 RT "STOP" (4 EA)
 STA. W 242+88 LT LEFT ARROW (1 EA)
 STA. W 243+28 LT "ONLY" (4 EA)
 STA. W 243+68 LT LEFT ARROW (1 EA)
 STA. W 244+08 LT "ONLY" (4 EA)
 STA. W 244+48 LT LEFT ARROW (1 EA)

TEMPORARY 4 INCH YELLOW LINE, PAINT
DURABLE 4 INCH YELLOW LINE, (SEE OPTION ITEMS)
 (ALL LINES WILL INCLUDE CENTER LINE BREAKS FOR SIDE ROADS)
 STA. W 239+50 - W 249+50 (SOLID LT & RT)

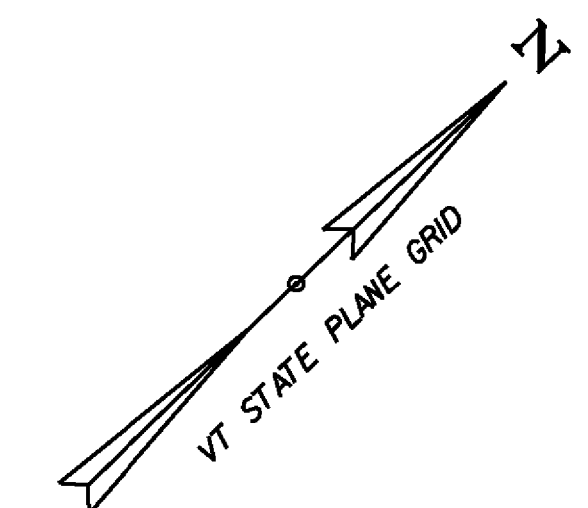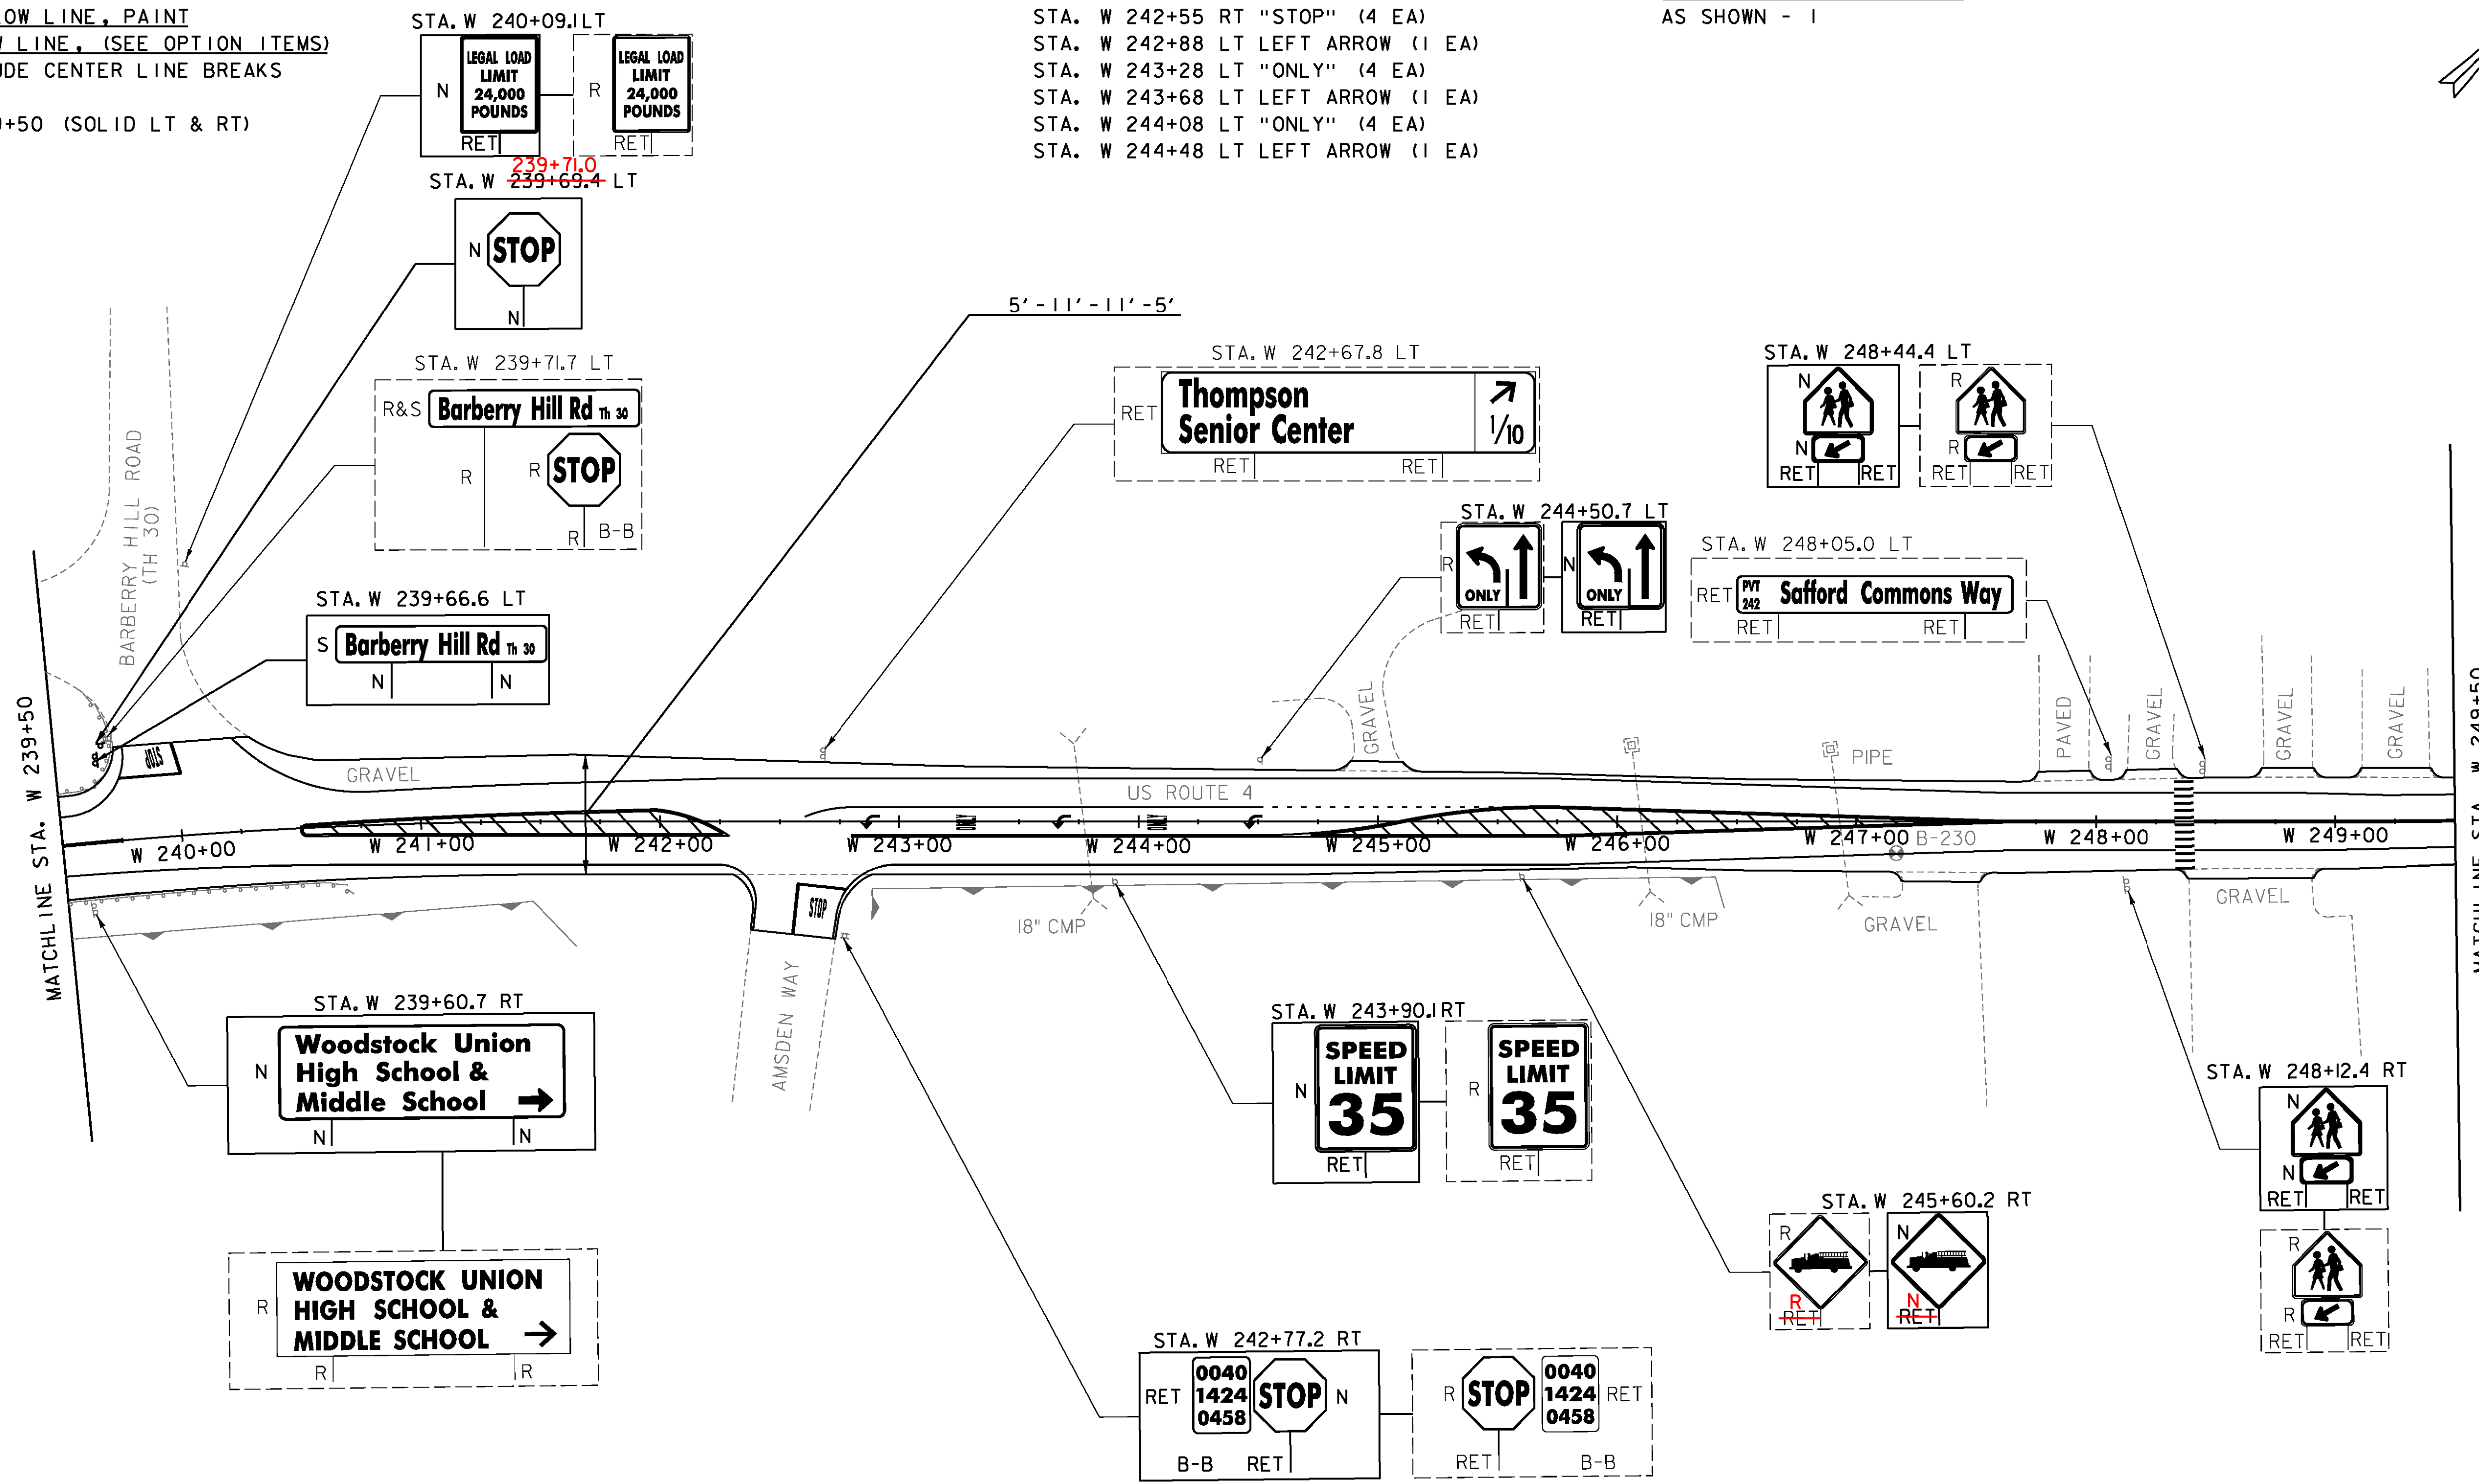

SIGN LEGEND
 R = REMOVE
 R&S = REMOVE AND SALVAGE
 RET = RETAIN
 S = SALVAGED
 N = NEW
 B-B = BACK TO BACK
 --- = EXISTING
 — = NEW

PROJECT NAME: KILLINGTON-WOODSTOCK
 PROJECT NUMBER: ER NH 020-2(38)
 FILE NAME: z13bi92bdr.dgn
 PROJECT LEADER: E. ATKINS
 DESIGNED BY: T. BIGELOW/S. MUSTO
 PLAN SHEET 45
 PLOT DATE: 3/7/2016
 DRAWN BY: I. KHALID
 CHECKED BY: ATKINS/SOBEL
 SHEET 72 OF 146

NOT TO SCALE