

STEEL BEAM GUARDRAIL, GALVANIZED
STA. W 258+47.4 LT - W 259+09.9 LT

REMOVAL AND DISPOSAL OF GUARDRAIL
STA. W 258+47.4 LT - W 259+09.9 LT

TEMPORARY 4 INCH WHITE LINE, PAINT
DURABLE 4 INCH WHITE LINE, (SEE OPTION ITEMS)
(ALL LINES WILL INCLUDE EDGE LINE BREAKS
AND RADI FOR SIDE ROADS)
STA. W 249+50 - W 259+50 (SOLID LT & RT)

TEMPORARY 4 INCH YELLOW LINE, PAINT
DURABLE 4 INCH YELLOW LINE, (SEE OPTION ITEMS)
(ALL LINES WILL INCLUDE CENTER LINE BREAKS
FOR SIDE ROADS)
STA. W 249+50 - W 259+50 (SOLID LT & RT)



TEMPORARY 8 INCH WHITE LINE, PAINT
DURABLE 8 INCH WHITE LINE, (SEE OPTION ITEMS)
STA. W 257+59 - W 258+20 (GORE)

TEMPORARY 24 INCH STOP BAR, PAINT
DURABLE 24 INCH STOP BAR, (SEE OPTION ITEM)
W 251+98 RT
W 257+18 LT
W 257+54 LT

TEMPORARY LETTER OR SYMBOL, PAINT
DURABLE LETTER OR SYMBOL, (SEE OPTION ITEM)
W 251+96 RT "STOP" (4 EA)
W 252+17 LT "SCHOOL" (6 EA)
W 257+20 LT "STOP" (4 EA)
W 257+62 LT "STOP" (4 EA)

REMOVING SIGNS
AS SHOWN - 19

ERECTING SALVAGED SIGNS
AS SHOWN - 2

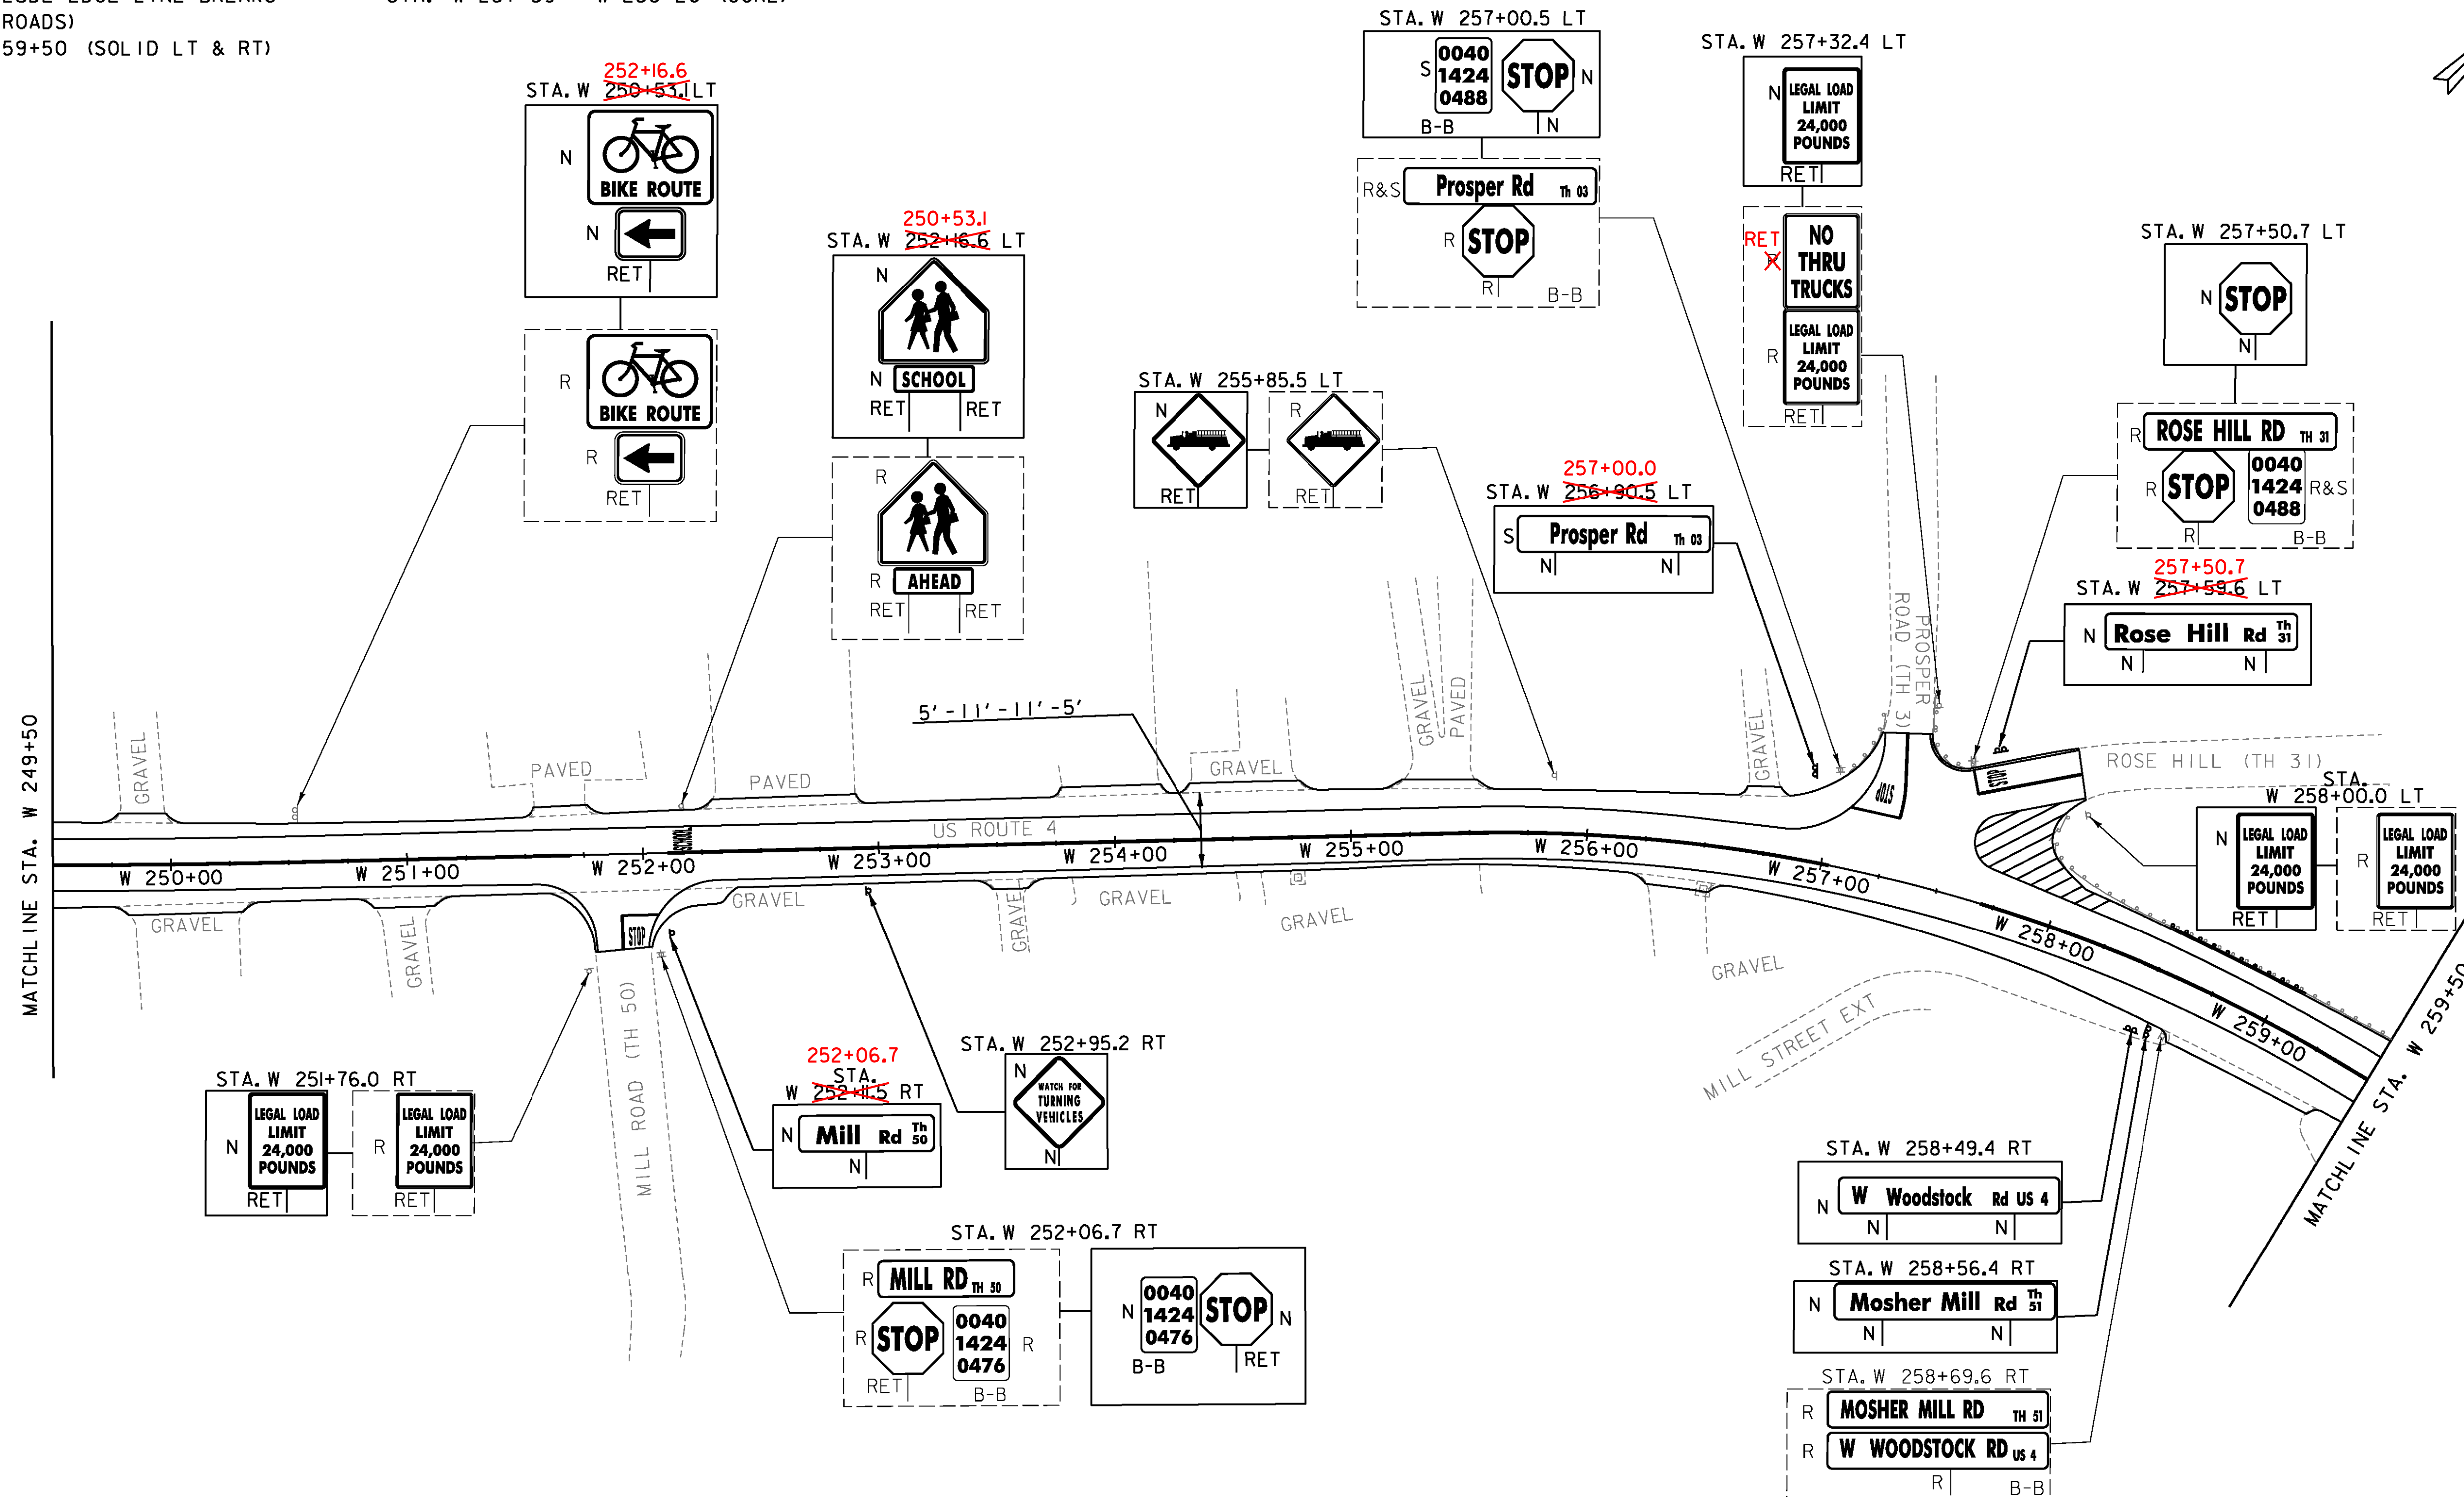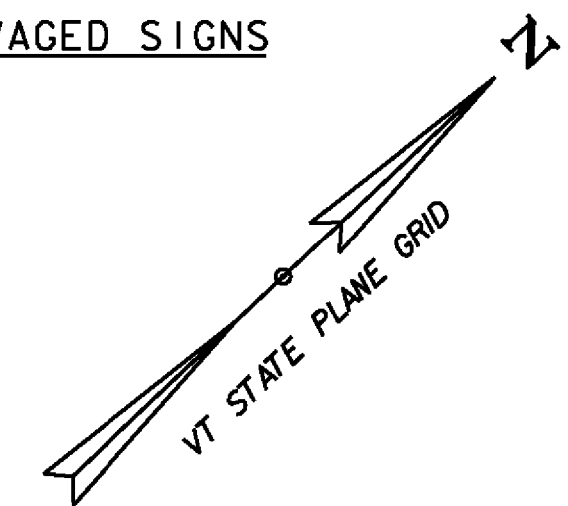

SIGN LEGEND

- R = REMOVE
- R&S = REMOVE AND SALVAGE
- RET = RETAIN
- S = SALVAGED
- N = NEW
- B-B = BACK TO BACK
- = EXISTING
- = NEW

NOT TO SCALE

PROJECT NAME: KILLINGTON-WOODSTOCK
PROJECT NUMBER: ER NH 020-2(38)

FILE NAME: z13bi92bdr.dgn
PROJECT LEADER: E. ATKINS
DESIGNED BY: T. BIGELOW/S. MUSTO
PLAN SHEET 46

PLOT DATE: 3/7/2016
DRAWN BY: I. KHALID
CHECKED BY: ATKINS/SOBEL
SHEET 73 OF 146