

BEGIN ROCK FALL SITE 038
STA. B 138+14.50 (MM 2.616)

END ROCK FALL SITE 038
STA. B 143+08.50 (MM 2.710)

24

US ROUTE 4

US-ROUTE-4
TO HARTFORD

US ROUTE 4
TO MENDON

18" RCP

18" RCP

AER E&T

AER E&T

6" UNDERDRAIN

6" UNDERDRAIN


6" UNDERDRAIN

DITCH

DITCH

58E

ID

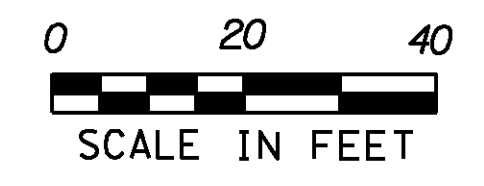

PROJECT NAME:	KILLINGTON-WOODSTOCK
PROJECT NUMBER:	ER NH 020-2(38)
FILE NAME:	z13bi92erof1nalbdr_RF038.dgn
PROJECT LEADER:	E. ATKINS
DESIGNED BY:	T. BIGELOW
RF SITE 038 FINAL CONDITIONS PLAN SHEET	
PLOT DATE:	3/7/2016
DRAWN BY:	N. GOTTIER
CHECKED BY:	E. ATKINS
SHEET	134 OF 146

NOTE:
SEE CROSS SECTIONS FOR PROPOSED GRADING.