



REFERENCE CHANGE ORDER #2 FOR LEDGE CUT OFFSETS

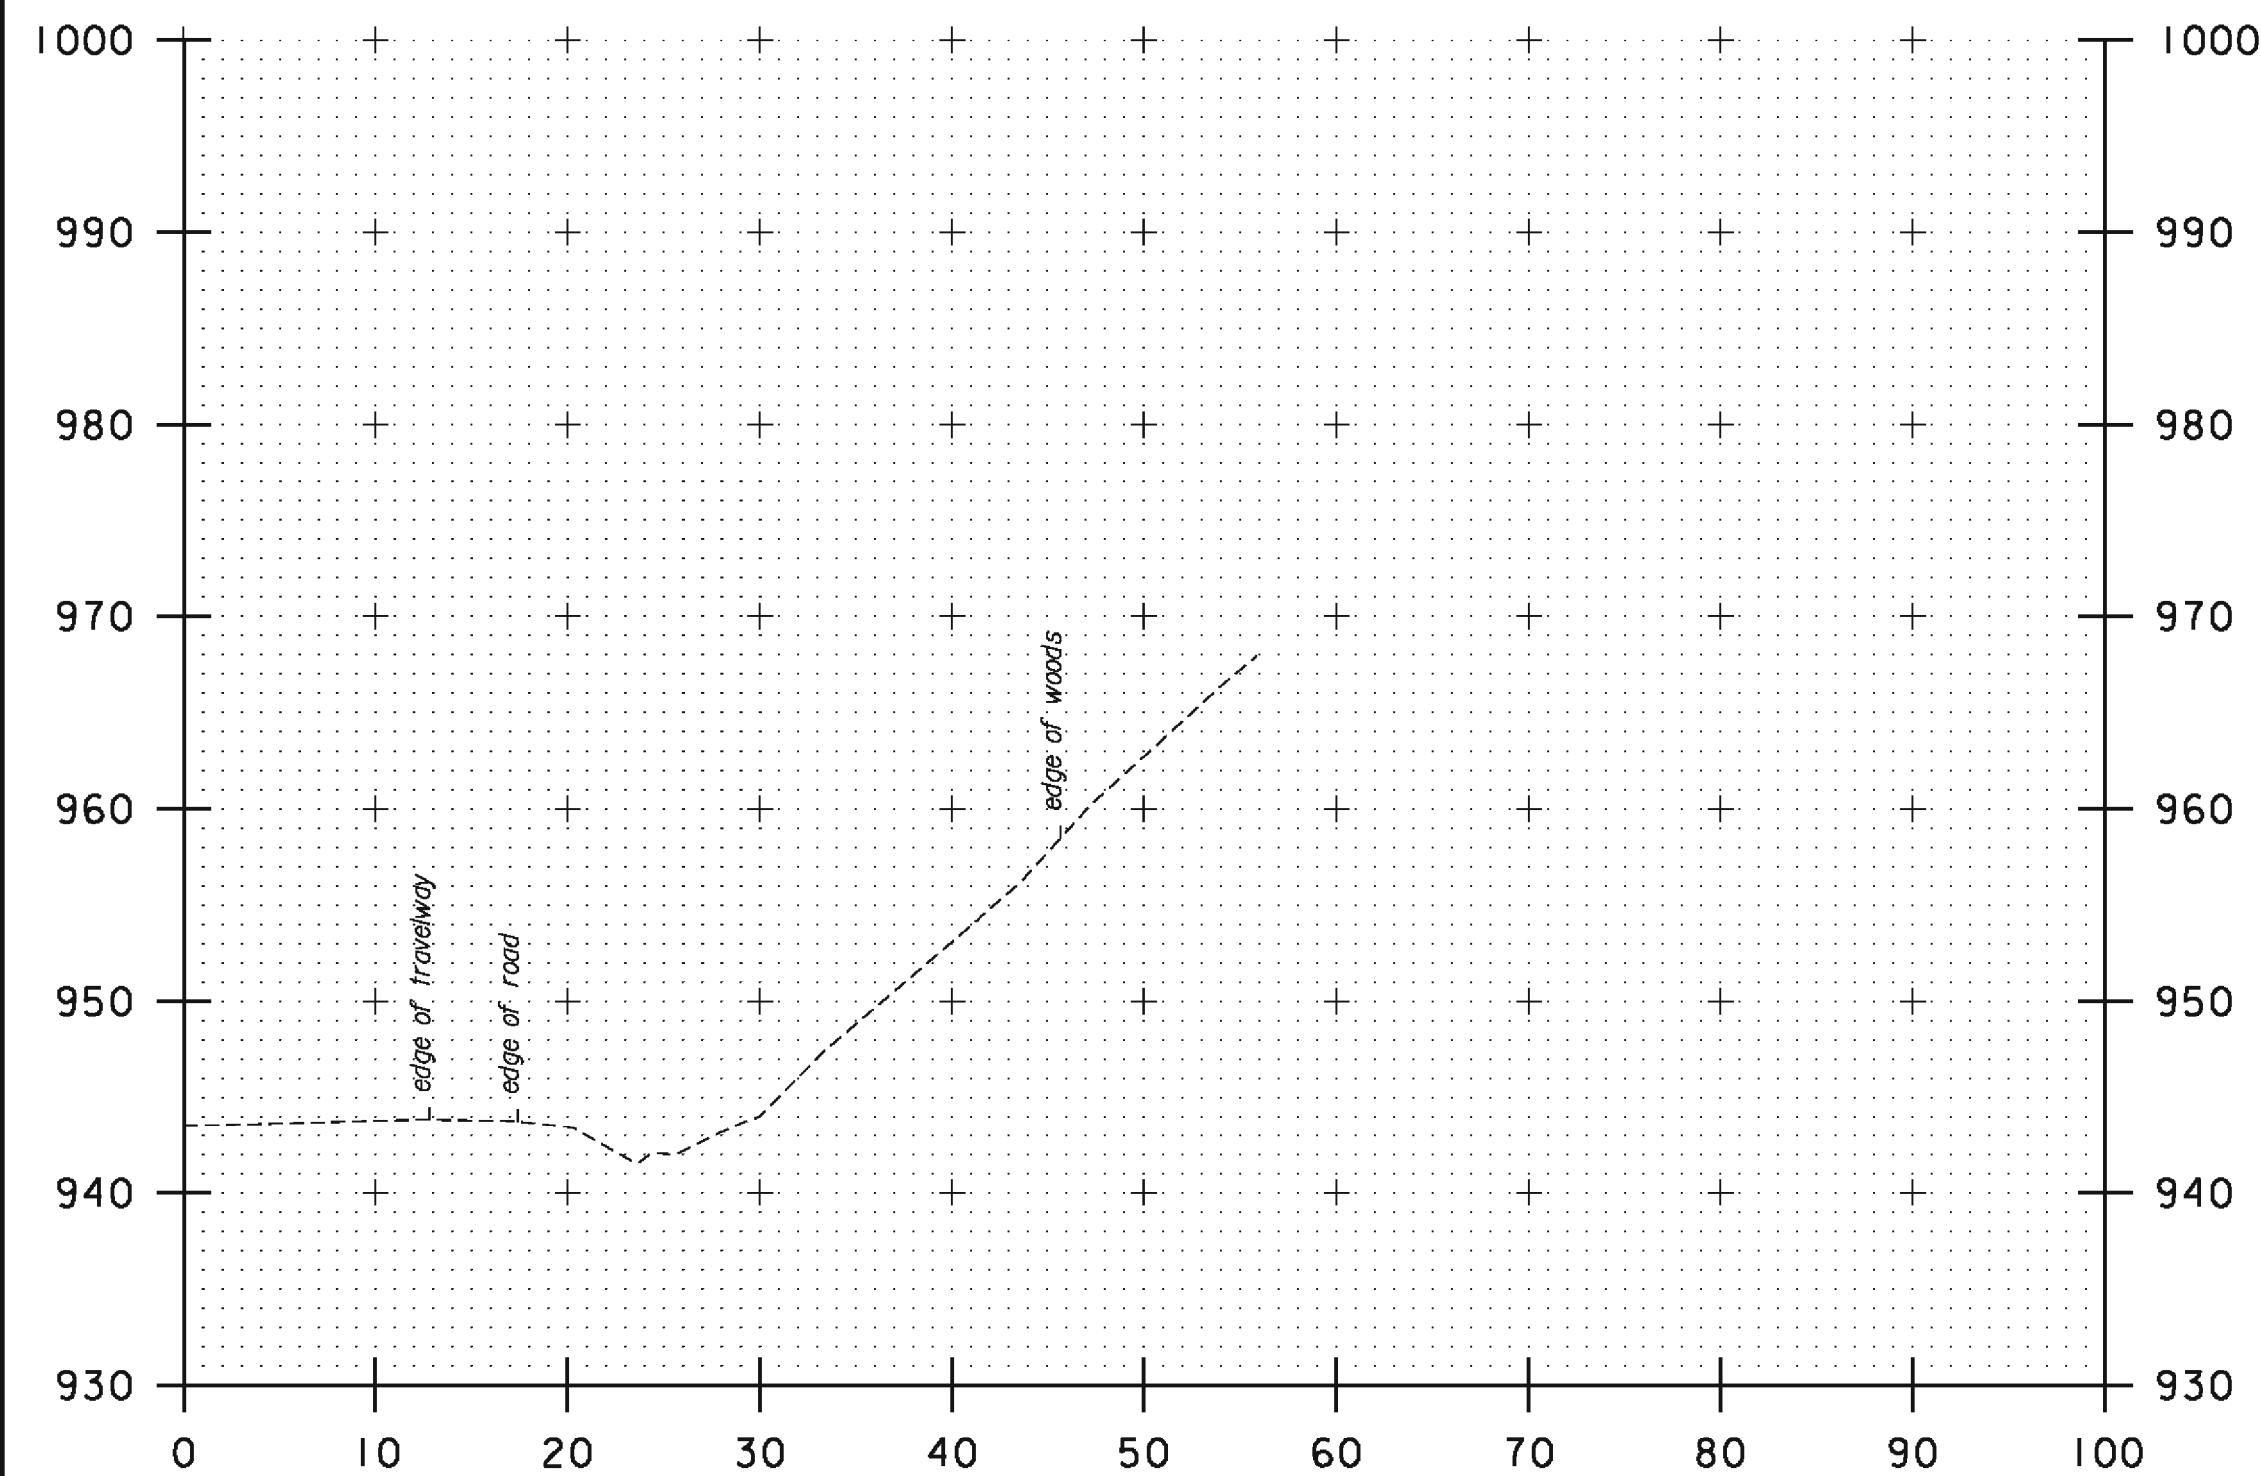

B 138+10

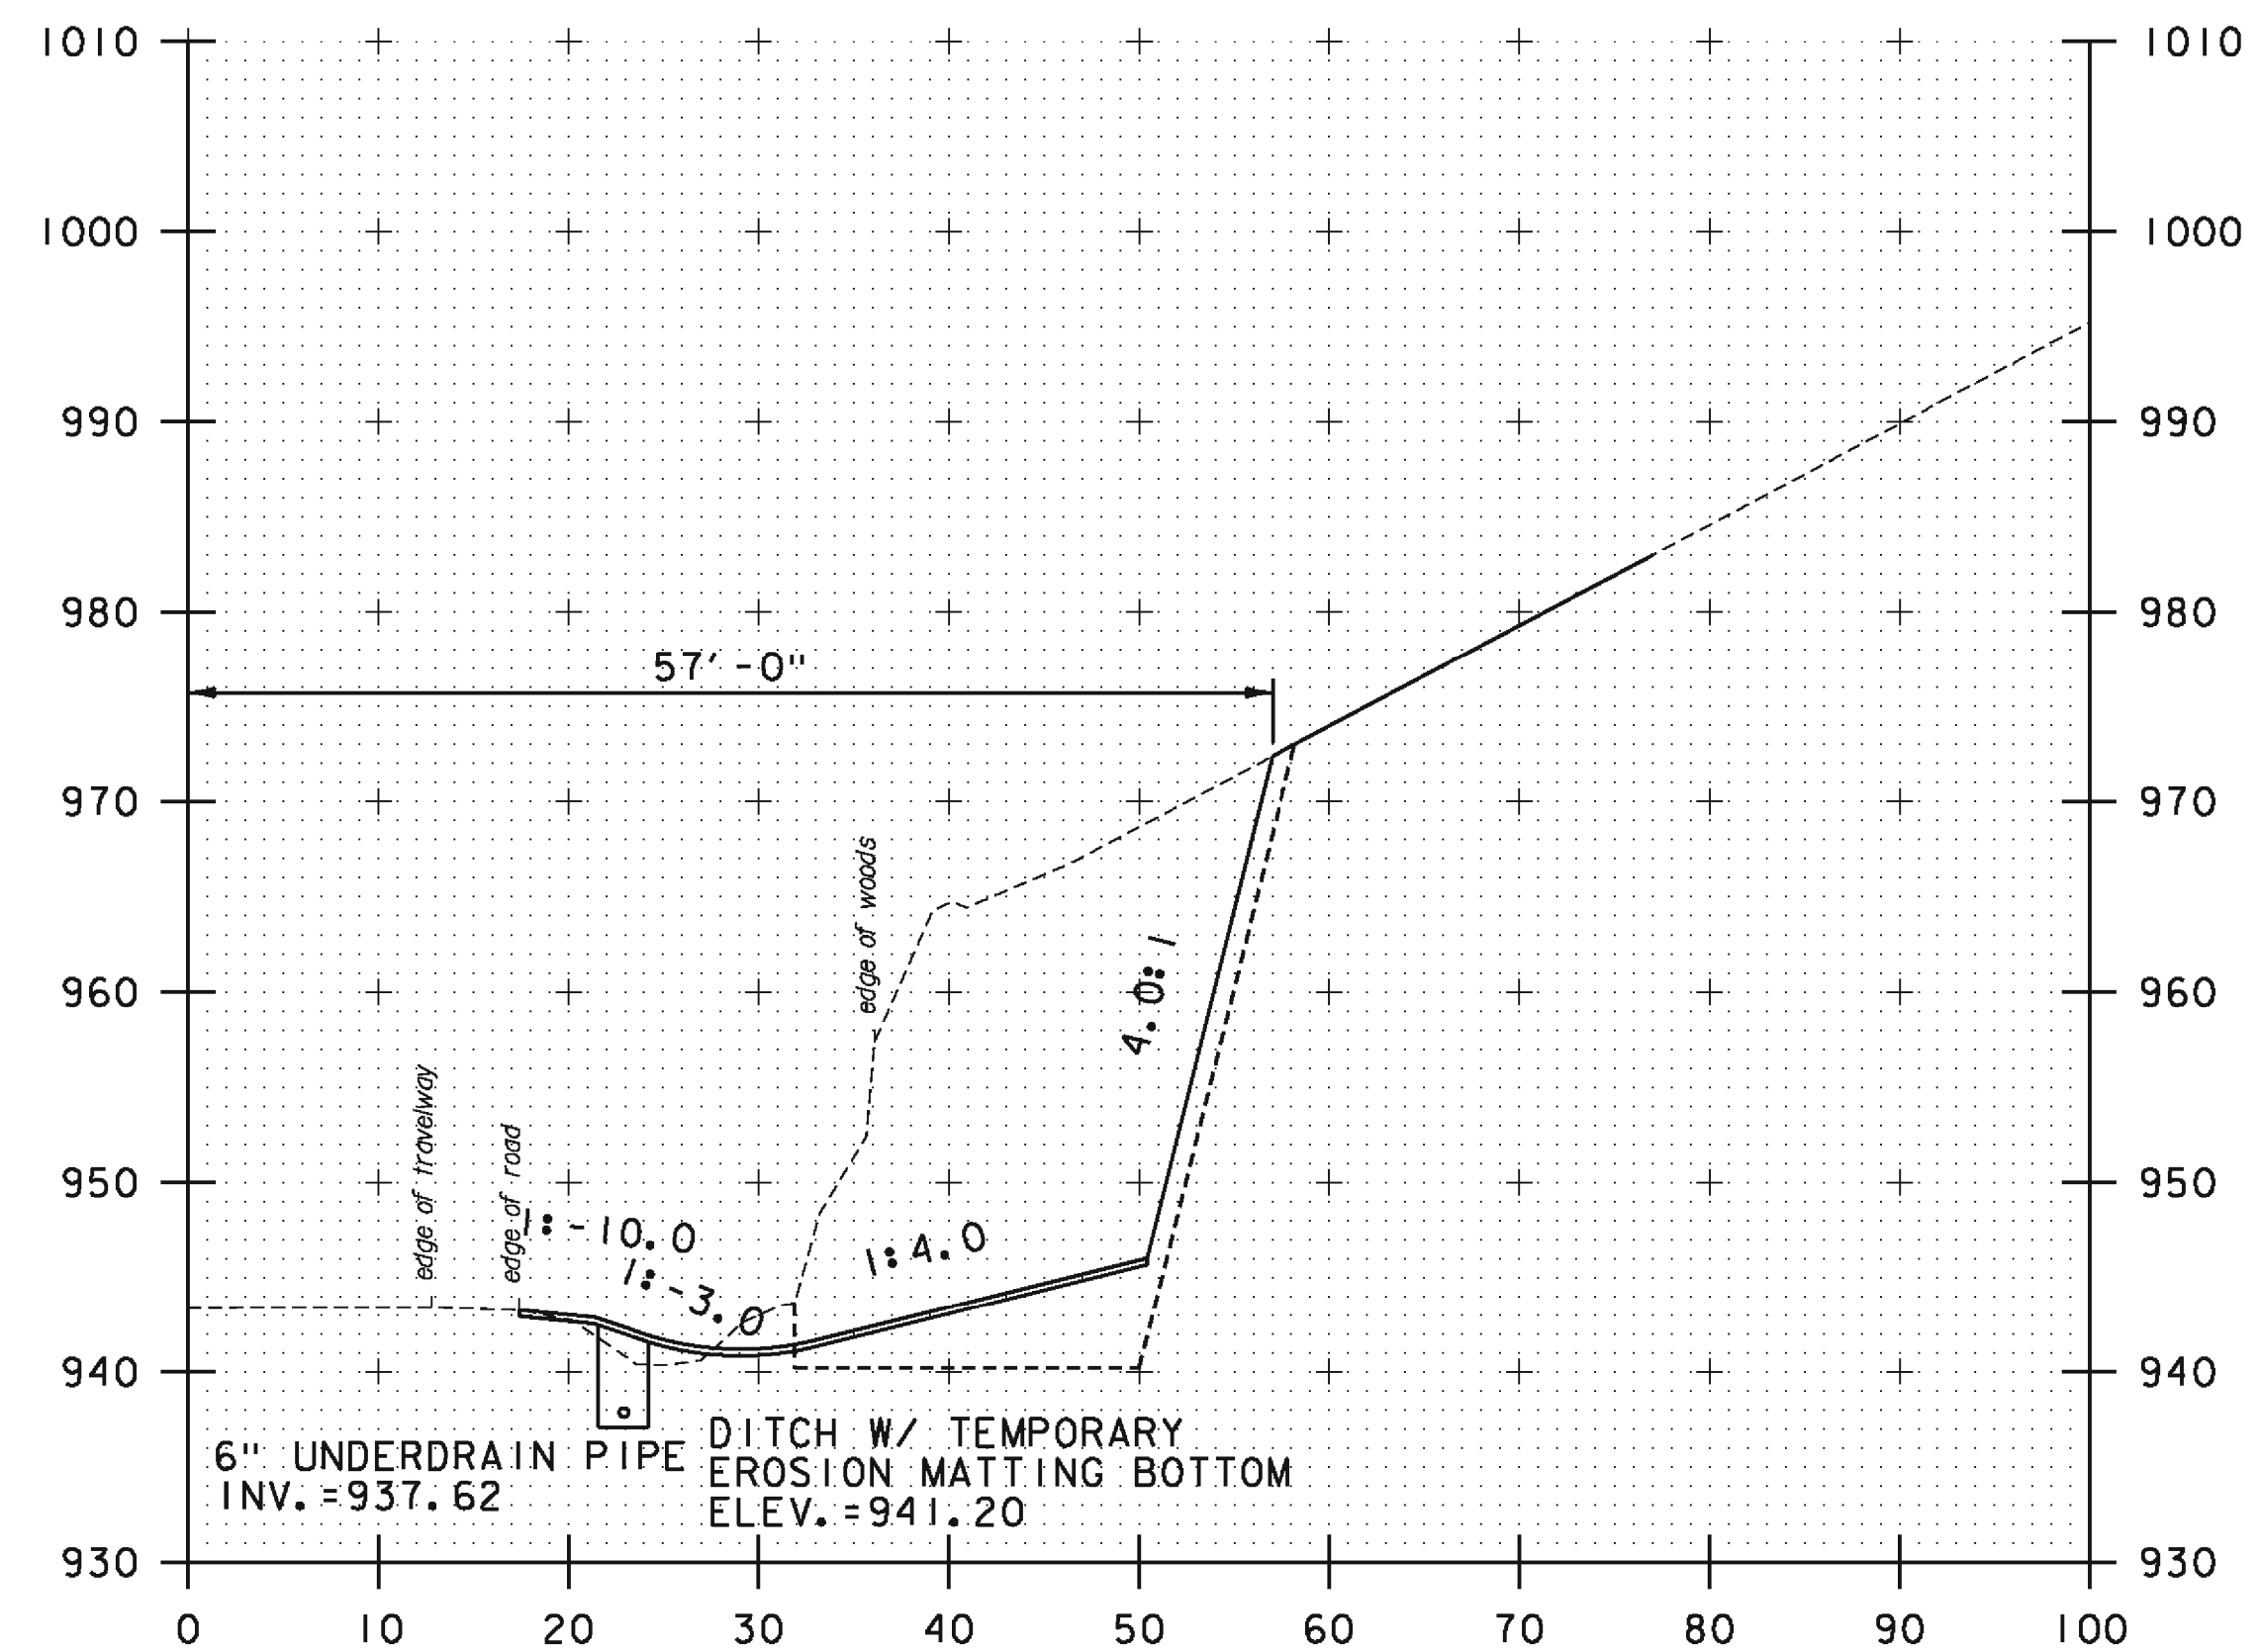

B 138+50

B 138+14.50 BEGIN ROCKFALL SITE 038

STA. B 138+10 TO STA. B 138+50

PROJECT NAME:	KILLINGTON-WOODSTOCK
PROJECT NUMBER:	ER NH 020-2(38)
FILE NAME:	z13b192xsl_RF038.dgn
PROJECT LEADER:	E. ATKINS
DESIGNED BY:	T. BIGELOW
ROCKFALL SITE 038 CROSS SECTION SHEET 1	SHEET 137 OF 146
PLOT DATE:	3/7/2016
DRAWN BY:	T. BIGELOW
CHECKED BY:	E. ATKINS