


B 139+00.70 PC

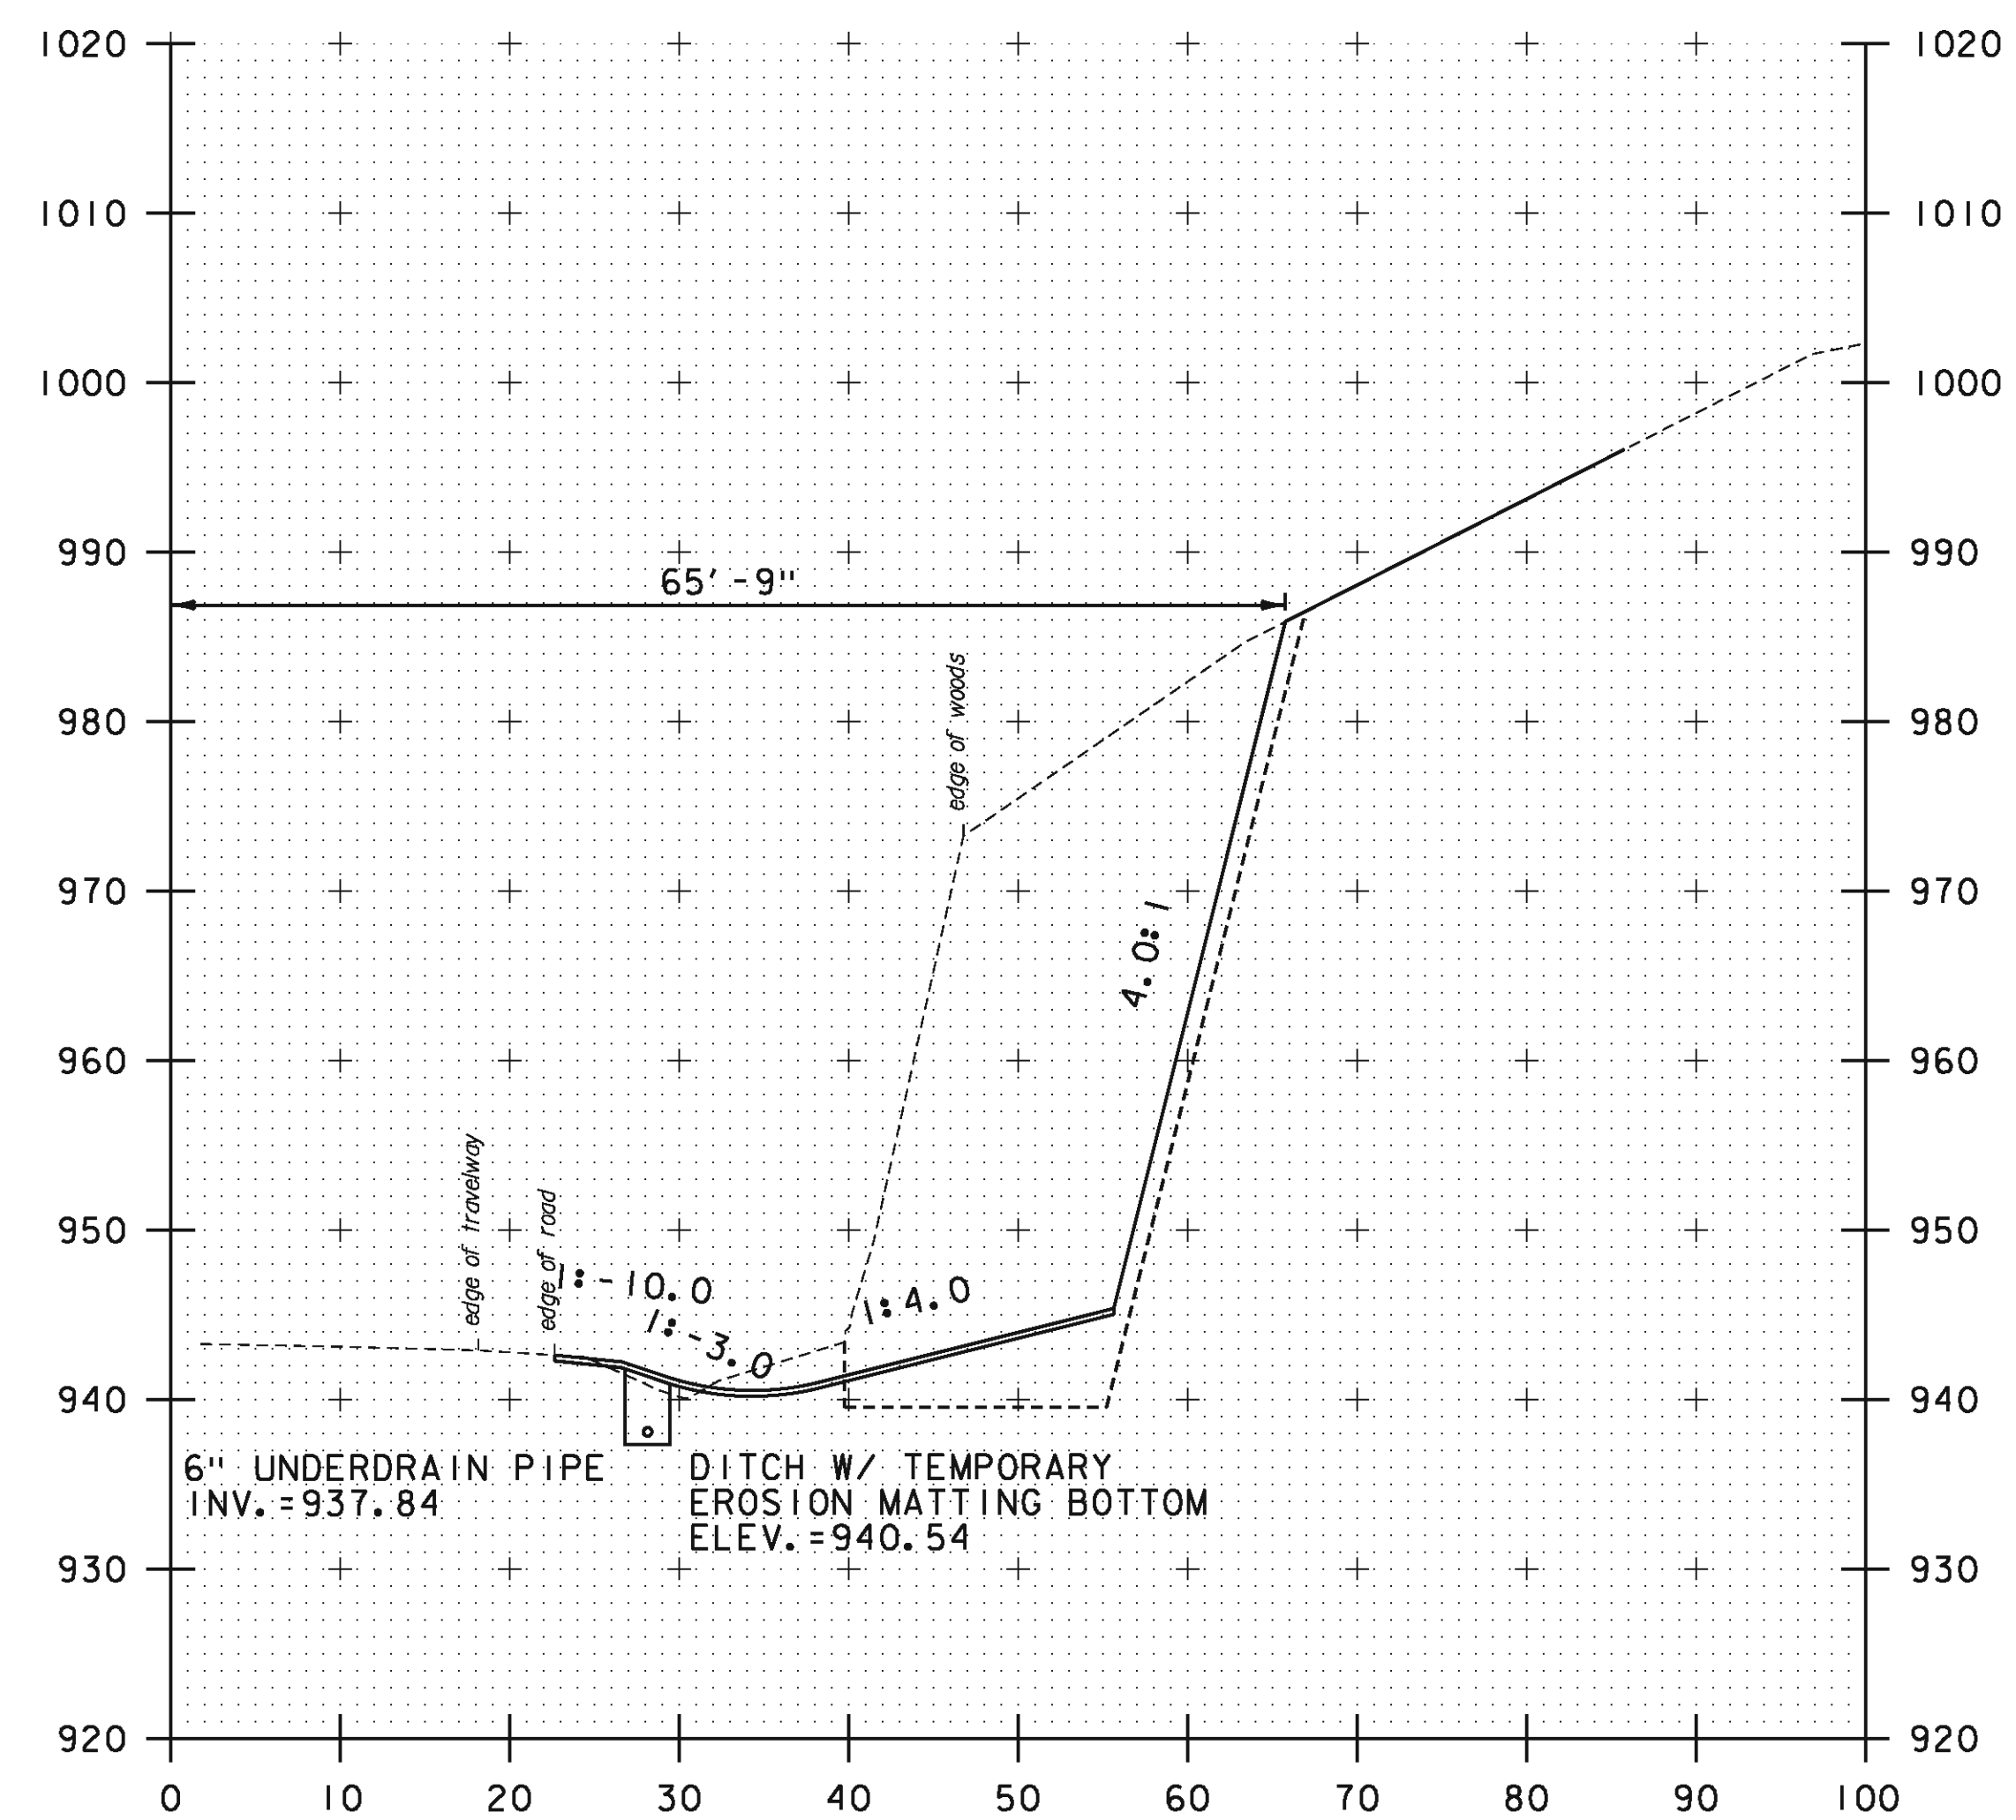

B 139+50

STA. B 139+00.70 TO STA. B 139+50

PROJECT NAME:	KILLINGTON-WOODSTOCK
PROJECT NUMBER:	ER NH 020-2(38)
FILE NAME:	z13bi92xsl_RF038.dgn
PROJECT LEADER:	E. ATKINS
DESIGNED BY:	T. BIGELOW
ROCKFALL SITE 038 CROSS SECTION SHEET 3 SHEET	139 OF 146
PLOT DATE:	3/7/2016
DRAWN BY:	T. BIGELOW
CHECKED BY:	E. ATKINS