


B 141+00

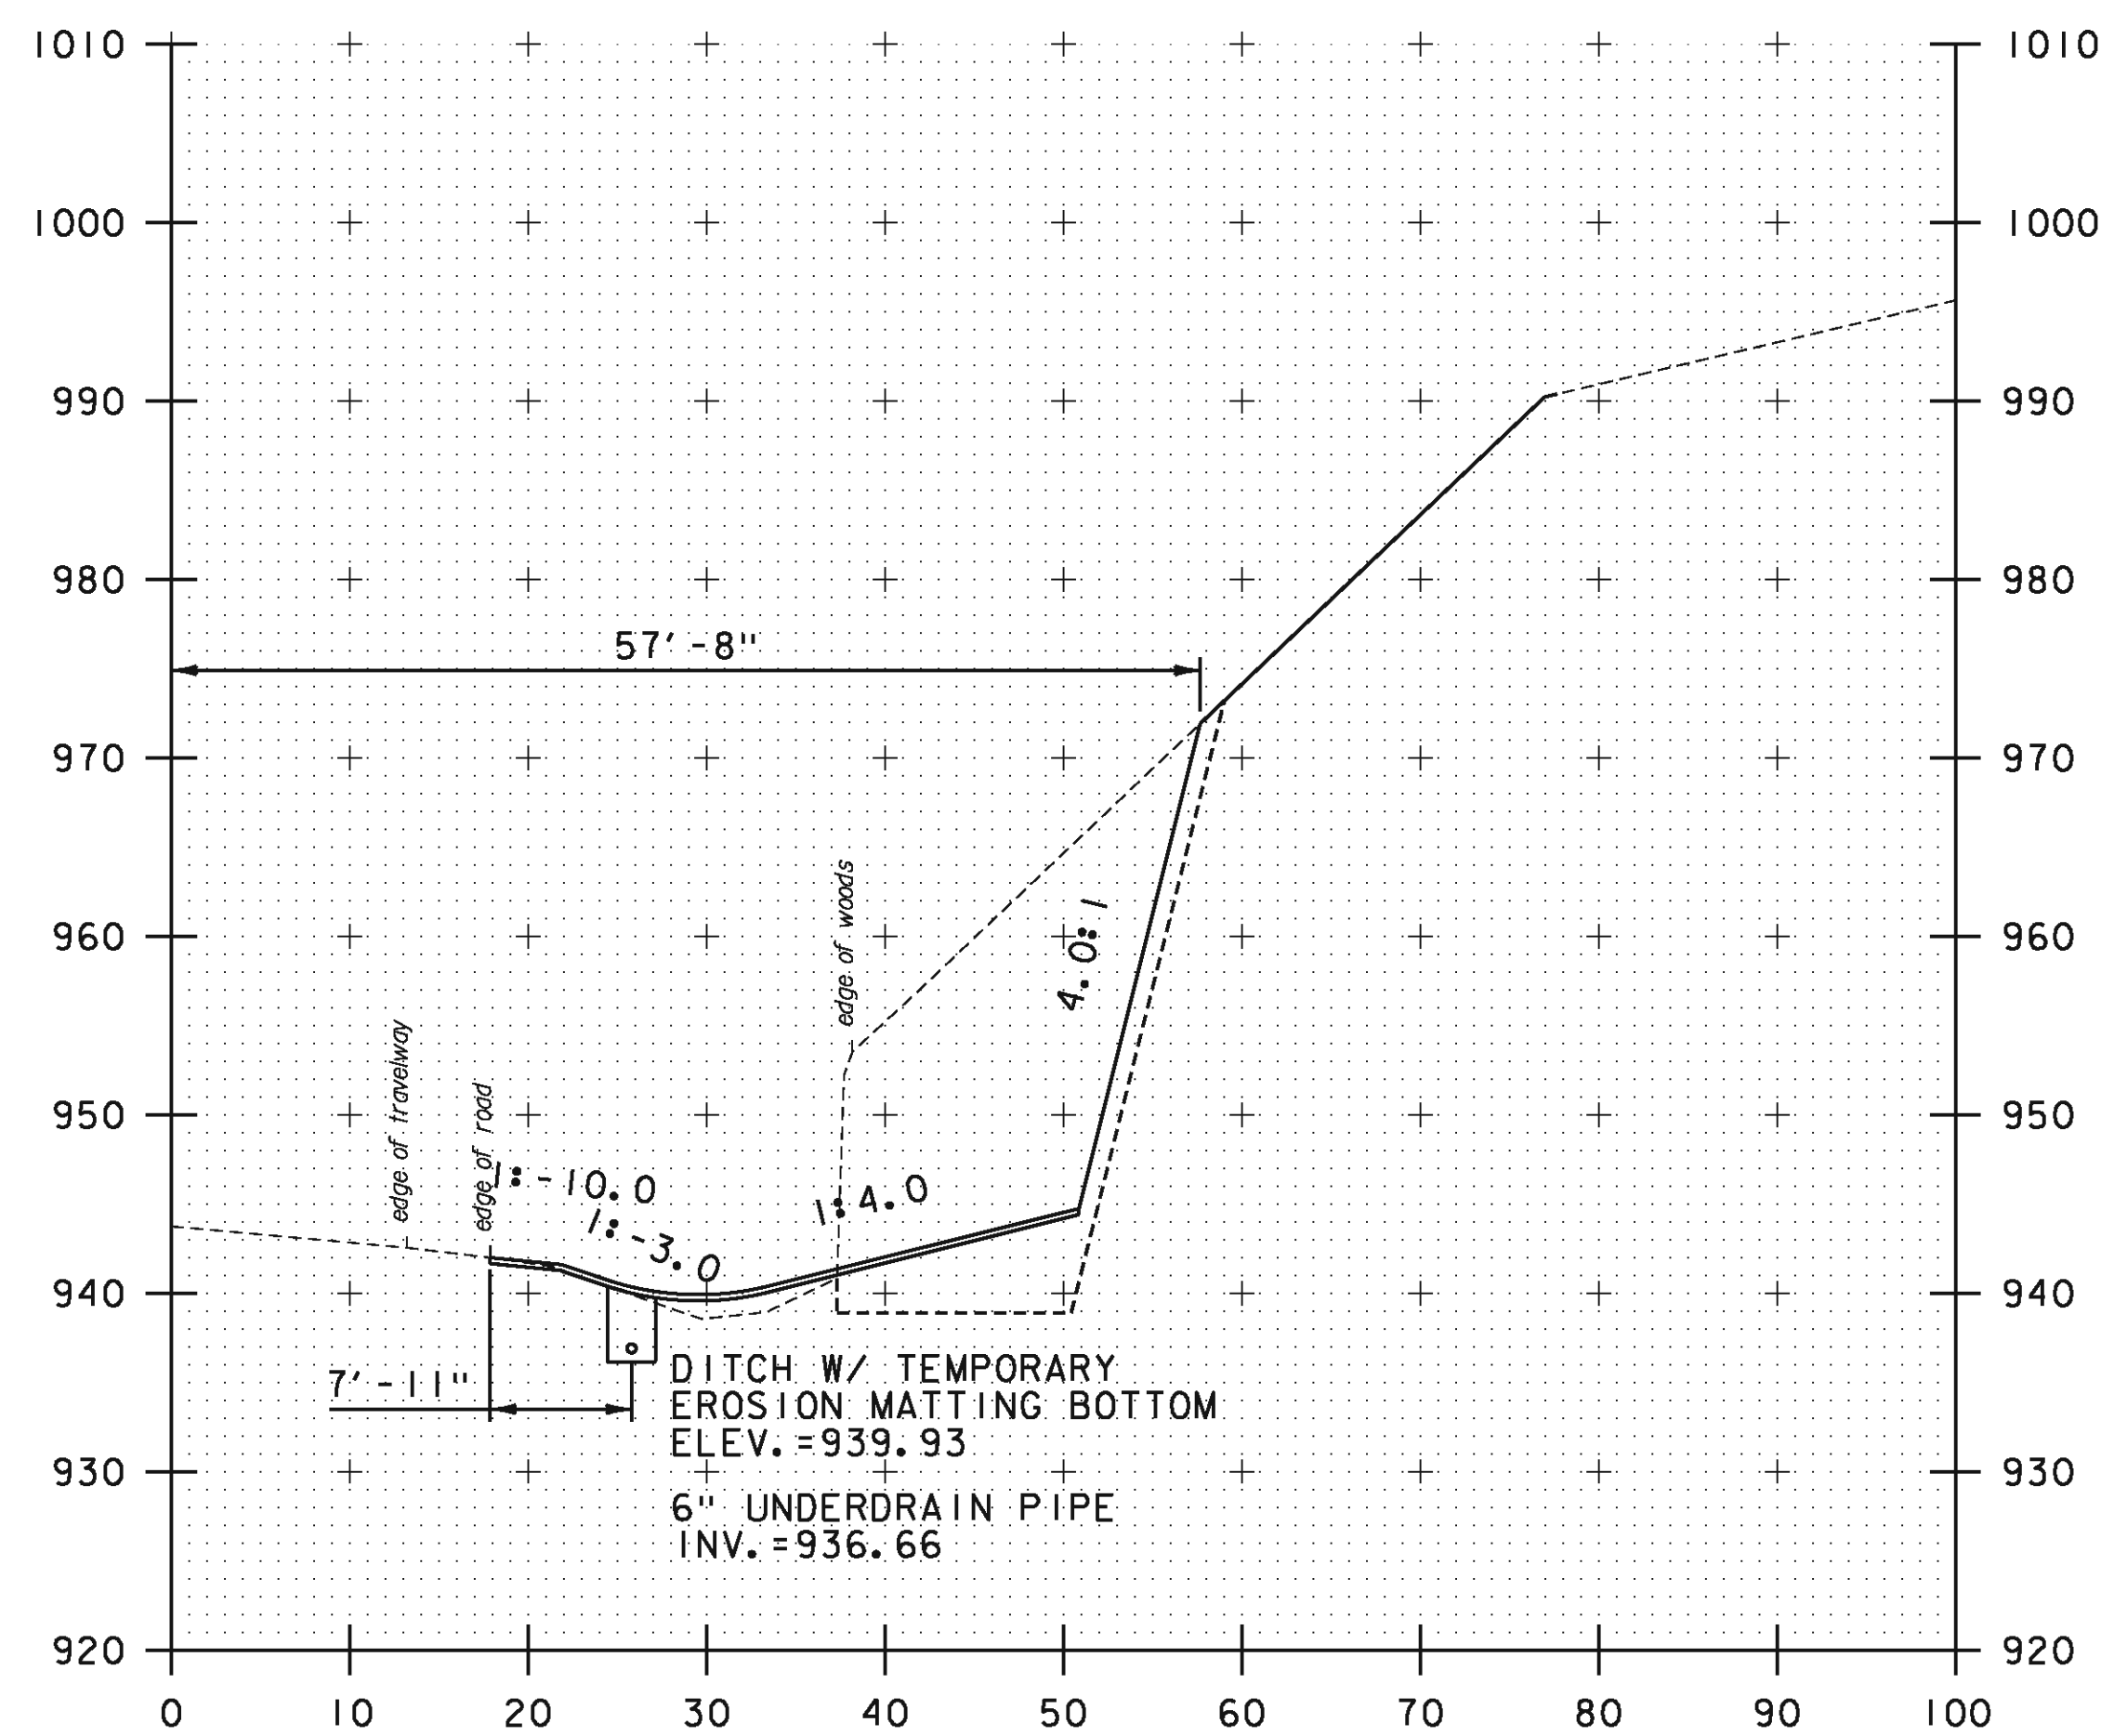

B 141+50

STA. B 141+00 TO STA. B 141+50

PROJECT NAME:	KILLINGTON-WOODSTOCK
PROJECT NUMBER:	ER NH 020-2(38)
FILE NAME:	z13bi92xsl.RF038.dgn
PROJECT LEADER:	E. ATKINS
DESIGNED BY:	T. BIGELOW
ROCKFALL SITE 038 CROSS SECTION SHEET 5 SHEET	141 OF 146
PLOT DATE:	3/7/2016
DRAWN BY:	T. BIGELOW
CHECKED BY:	E. ATKINS