


B 141+52.23
 SKEWED 1°57'.00 RT

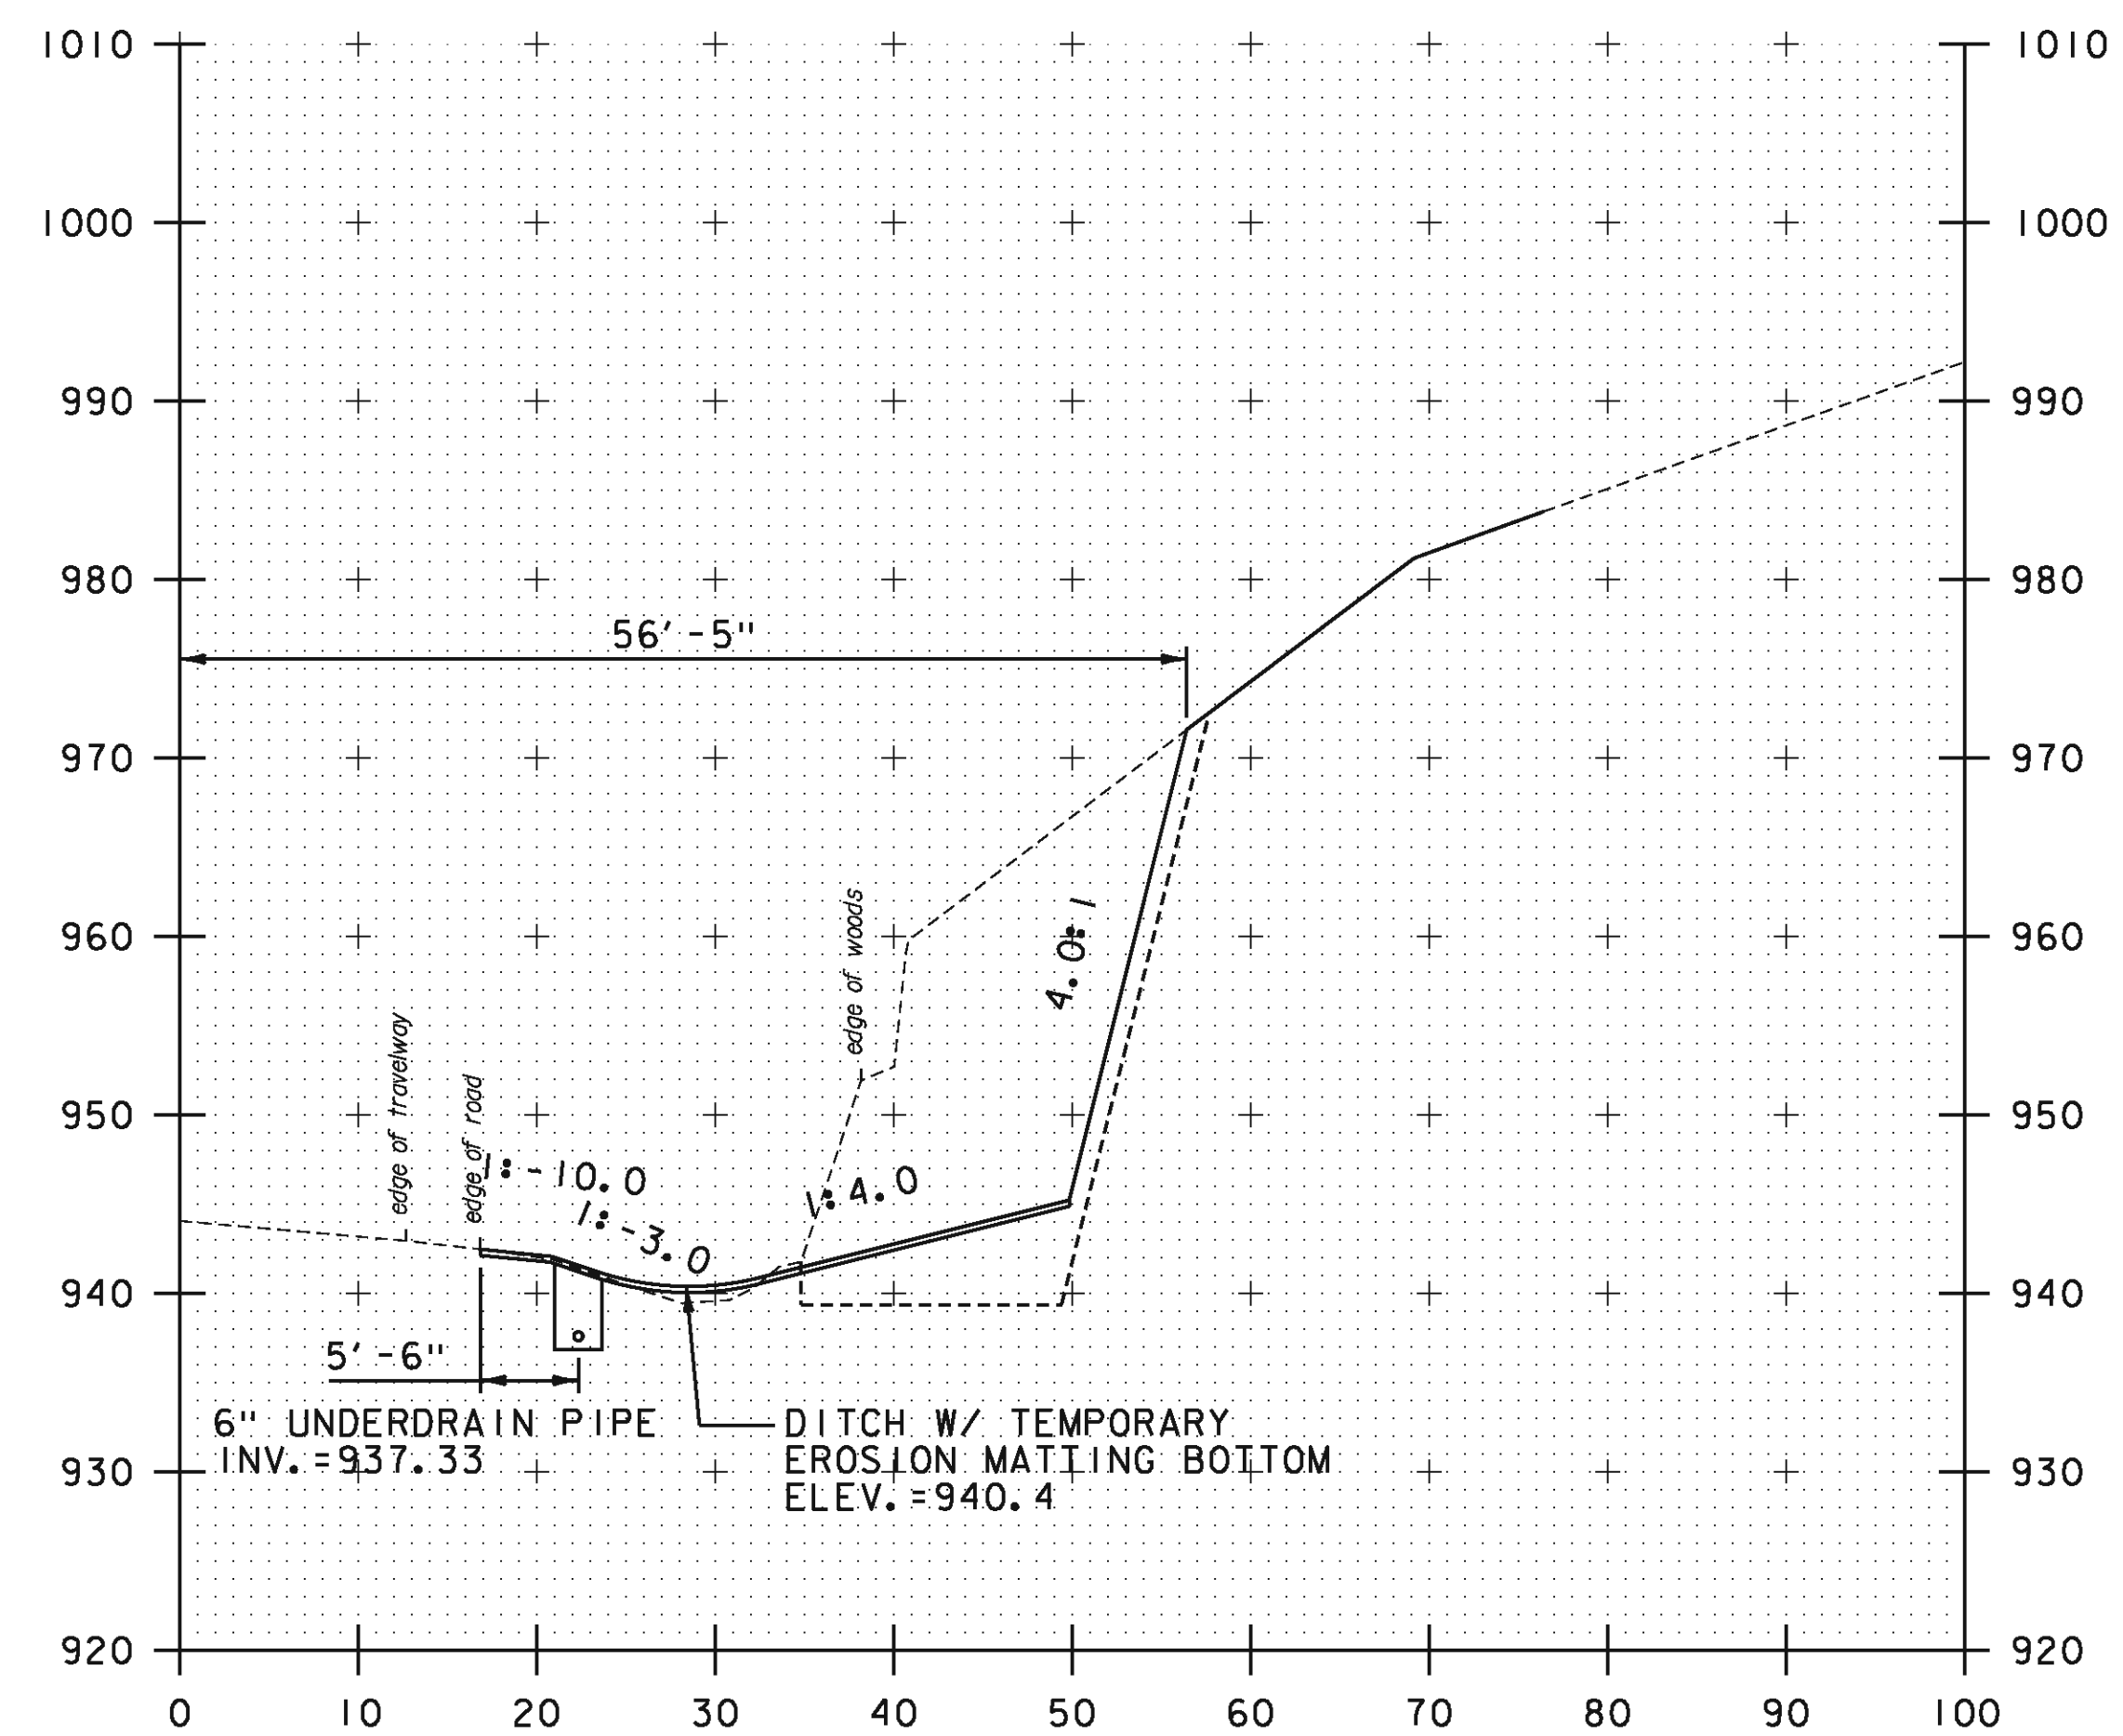

B 142+00

STA. B 141+52.23 TO STA. B 142+00

PROJECT NAME:	KILLINGTON-WOODSTOCK
PROJECT NUMBER:	ER NH 020-2(38)
FILE NAME:	z13bi92xsl.RF038.dgn
PROJECT LEADER:	E. ATKINS
DESIGNED BY:	T. BIGELOW
ROCKFALL SITE 038 CROSS SECTION SHEET 6 SHEET 142 OF 146	
PLOT DATE:	3/7/2016
DRAWN BY:	T. BIGELOW
CHECKED BY:	E. ATKINS