


TYPICAL SECTION ALTERNATE A
MM 0.000 (POWNAI) - MM 2.156 (BENNINGTON)

USED

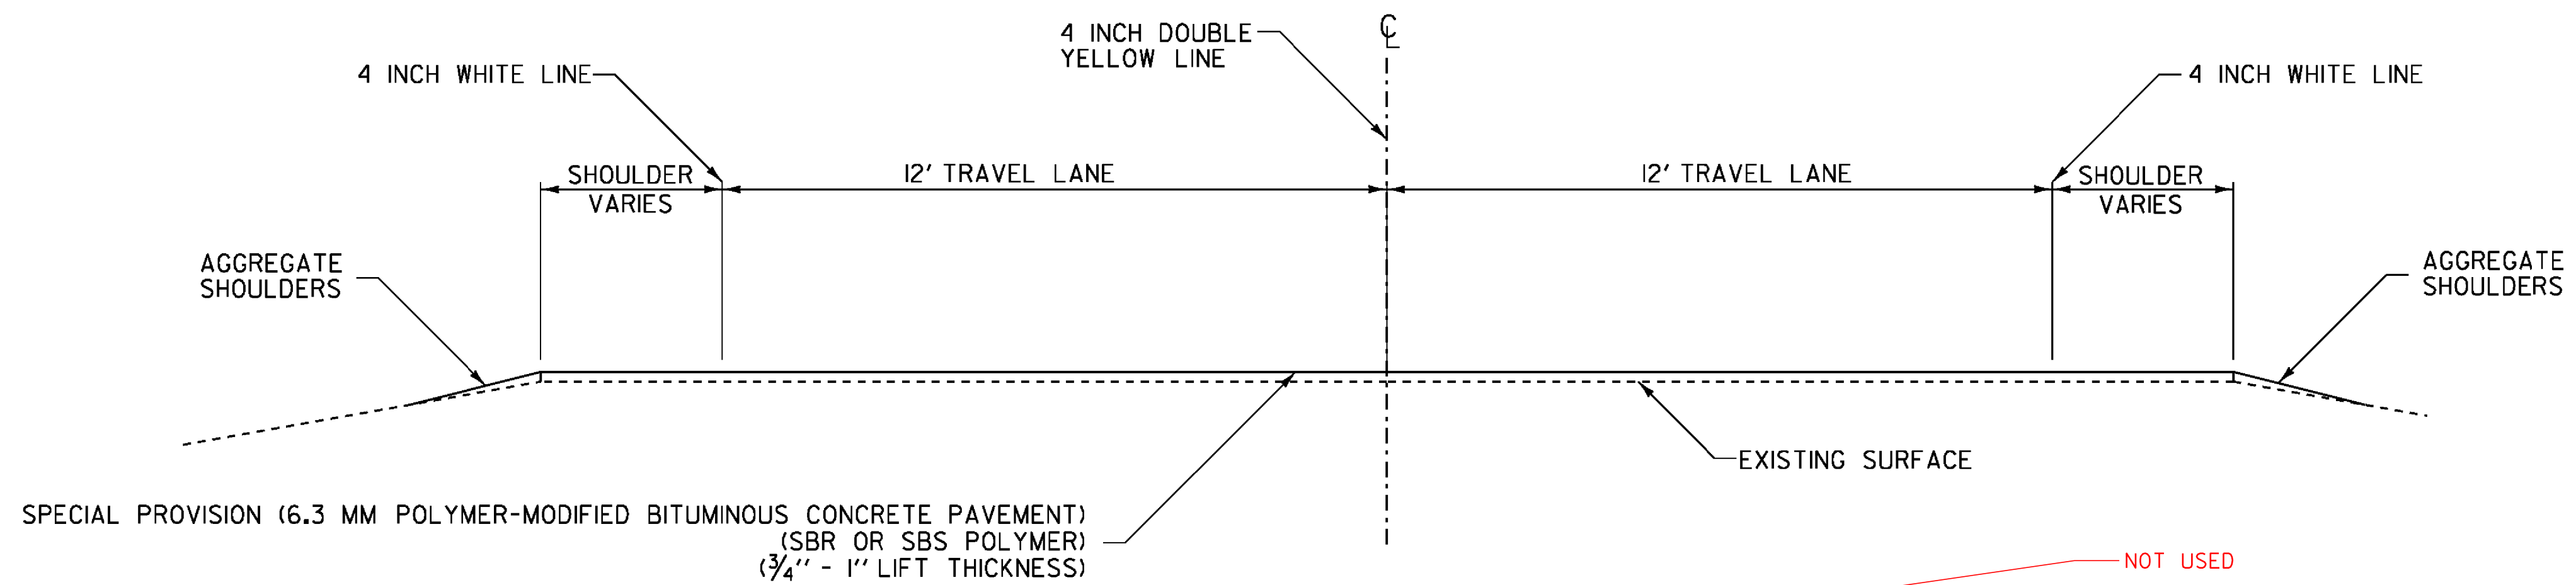

TYPICAL SECTION ALTERNATE B
MM 0.000 (POWNAI) - MM 2.156 (BENNINGTON)

NOT USED

NOTES:
 1. PRIOR TO THE PLACEMENT OF THE POLYMER-MODIFIED BITUMINOUS CONCRETE PAVEMENT, EMULSIFIED ASPHALT SHALL BE APPLIED TO ALL EXISTING PAVEMENT SURFACES AND ON ALL COLD PLANNED SURFACES AT A RATE OF 0.080 GAL/SY (+/- 0.01GAL/SY) OR AS DIRECTED BY THE RESIDENT ENGINEER. EMULSIFIED ASPHALT SHALL BE RS-IH OR CRS-IH PER THE MANUFACTURER'S RECOMMENDATION AND PAID UNDER ITEM 900.683 SPECIAL PROVISION (EMULSIFIED ASPHALT)(RS-IH OR CRS-IH).

NOT TO SCALE

TYPICAL SECTIONS	PROJECT NAME:	POWNAI - BENNINGTON	
	PROJECT NUMBER:	NH SURF (42)	
	FILE NAME:	I3b592\p13b592.dgn	
	PLOT DATE:	02-APR-2014	
PROJECT LEADER:	FOWLER	DRAWN BY:	LOCKE
DESIGNED BY:	LOCKE	CHECKED BY:	PAVT MGMT
IPARM FILE NAME:	p13b592_03.I	SHEET	3 OF 23