

PROJECT AREA

LEGEND

- TWBH-THROUGHWAY BEGINS HERE
- TWEH-THROUGHWAY ENDS HERE
- SHB-STATE HIGHWAY BEGINS
- SHE-STATE HIGHWAY ENDS
- SL-SPEED LIMIT
- T/L-TOWN LINE
- SA - STATE AID TOWN HIGHWAY
- S.M. - SPECIAL MARKINGS

TEMPORARY 4 INCH WHITE LINE, PAINT
 MM 5.000 - MM 8.000 LT & RT (EDGELINES)
 (WITH BREAKS OR RADIAT TOWN HIGHWAYS)
 MM 6.684 - MM 6.924 LT (DASHED LINE, TRUCK LANE -
 SEE PROJECT SPECIAL MARKING LAYOUT SHEETS 9-10)


DURABLE 4 INCH WHITE LINE, POLYUREA
 MM 5.000 - MM 8.000 LT & RT (EDGELINES)
 (WITH BREAKS OR RADIAT TOWN HIGHWAYS)
 MM 6.684 - MM 6.924 LT (DASHED LINE, TRUCK LANE -
 SEE PROJECT SPECIAL MARKING LAYOUT SHEETS 9-10)

TEMPORARY 4 INCH YELLOW LINE, PAINT
 MM 5.000 - MM 7.325 SOLID LT & RT
 MM 7.325 - MM 7.480 SOLID LT, DASHED RT
 MM 7.480 - MM 7.510 DASHED CL
 MM 7.510 - MM 7.665 DASHED LT, SOLID RT
 MM 7.665 - MM 8.000 SOLID LT & RT
 (WITH CENTERLINE BREAKS AT TOWN HIGHWAYS)

DURABLE 4 INCH YELLOW LINE, POLYUREA
 MM 5.000 - MM 7.325 SOLID LT & RT
 MM 7.325 - MM 7.480 SOLID LT, DASHED RT
 MM 7.480 - MM 7.510 DASHED CL
 MM 7.510 - MM 7.665 DASHED LT, SOLID RT
 MM 7.665 - MM 8.000 SOLID LT & RT
 (WITH CENTERLINE BREAKS AT TOWN HIGHWAYS)

TEMPORARY LETTER OR SYMBOL, PAINT
 MM 5.143 RT - "SCHOOL" (6 EACH)
 MM 5.370 LT - "SCHOOL" (6 EACH)

DURABLE LETTER OR SYMBOL (OPTION ITEM)
 MM 5.143 RT - "SCHOOL" (6 EACH)
 MM 5.370 LT - "SCHOOL" (6 EACH)

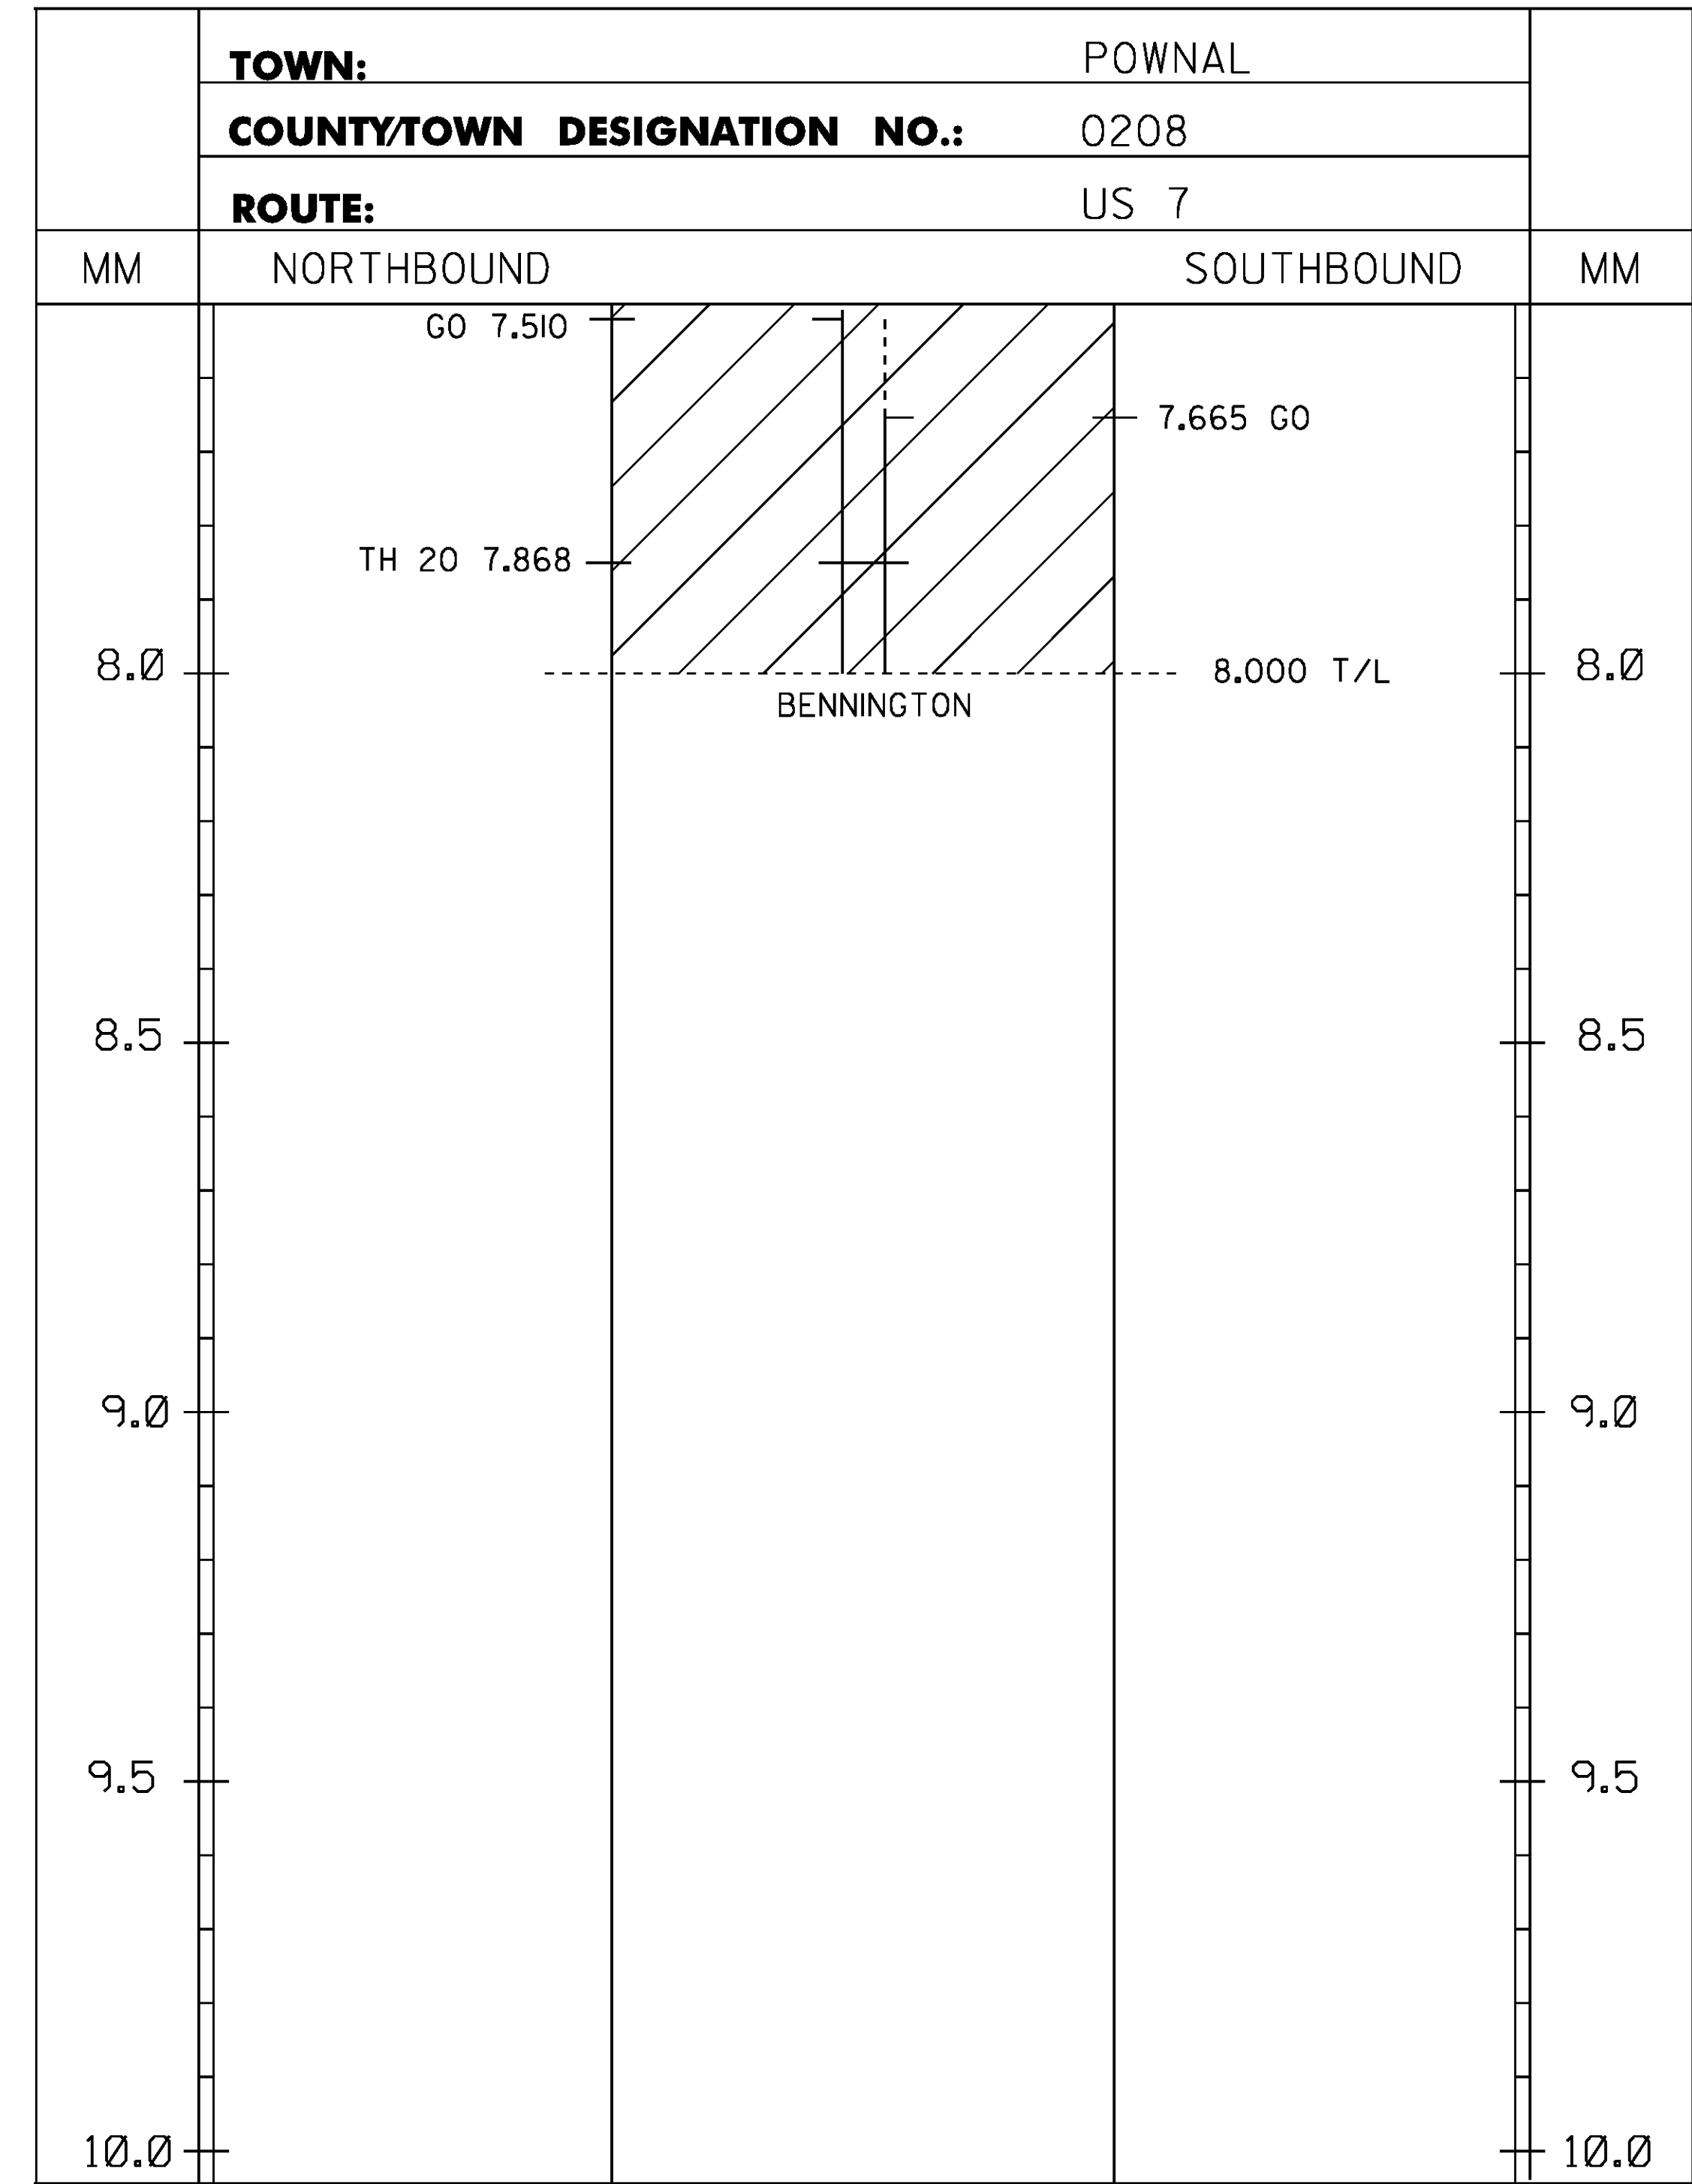

NOTES:
 1. THIS SHEET TO BE USED FOR THE LAYOUT OF ALL CENTERLINE PAVEMENT MARKINGS.
 THE RESIDENT ENGINEER MAY CONTACT KEITH SWEET, PAVEMENT MARKING SUPERVISOR
 AT (802) 828-5573 FOR ASSISTANCE LAYING OUT THE CENTERLINE DURING CONSTRUCTION.

NOT TO SCALE

**PROJECT
 CENTERLINE
 MARKING
 LAYOUT
 SHEET #2**

PROJECT NAME:	POWNA - BENNINGTON		
PROJECT NUMBER:	NH SURF (42)		
FILE NAME:	I3b592\pl3b592.dgn	PLOT DATE:	02-APR-2014
PROJECT LEADER:	FOWLER	DRAWN BY:	LOCKE
DESIGNED BY:	LOCKE	CHECKED BY:	PAVT MGMT
IPARM FILE NAME:	pl3b592_08.t	SHEET	8 OF 23