



**DURABLE 4 INCH WHITE LINE, POLYUREA**  
 MM 4.447 - MM 7.406 LT & RT  
 (WITH BREAKS OR RADII AT TOWN HIGHWAYS)

**DURABLE 4 INCH YELLOW LINE, POLYUREA**  
 MM 4.447 - MM 5.715 SOLID LT & RT  
 MM 5.715 - MM 5.790 SOLID LT & DASHED RT  
 MM 5.790 - MM 5.908 DASHED RT  
 MM 5.908 - MM 6.065 DASHED LT & SOLID RT  
 MM 6.065 - MM 6.127 SOLID LT & RT  
 MM 6.127 - MM 6.261 DASHED RT & SOLID LT  
 MM 6.261 - MM 6.402 DASHED LT & SOLID RT  
 MM 6.402 - MM 6.442 DASHED RT  
 MM 6.442 - MM 6.571 SOLID LT & DASHED RT  
 MM 6.571 - MM 6.635 DASHED RT  
 MM 6.635 - MM 6.757 DASHED LT & SOLID RT  
 MM 6.757 - MM 6.790 DASHED LT & RT  
 MM 6.790 - MM 6.880 SOLID LT & DASHED RT  
 MM 6.880 - MM 6.926 SOLID LT & RT  
 MM 6.926 - MM 7.014 DASHED LT & SOLID RT  
 MM 7.014 - MM 7.040 DASHED LT & RT  
 MM 7.040 - MM 7.185 SOLID LT & DASHED RT  
 MM 7.185 - MM 7.315 DASHED RT  
 MM 7.315 - MM 7.390 DASHED LT & SOLID RT  
 MM 7.390 - MM 7.406 SOLID LT & RT  
 (WITH CENTERLINE BREAKS AT TOWN HIGHWAYS)

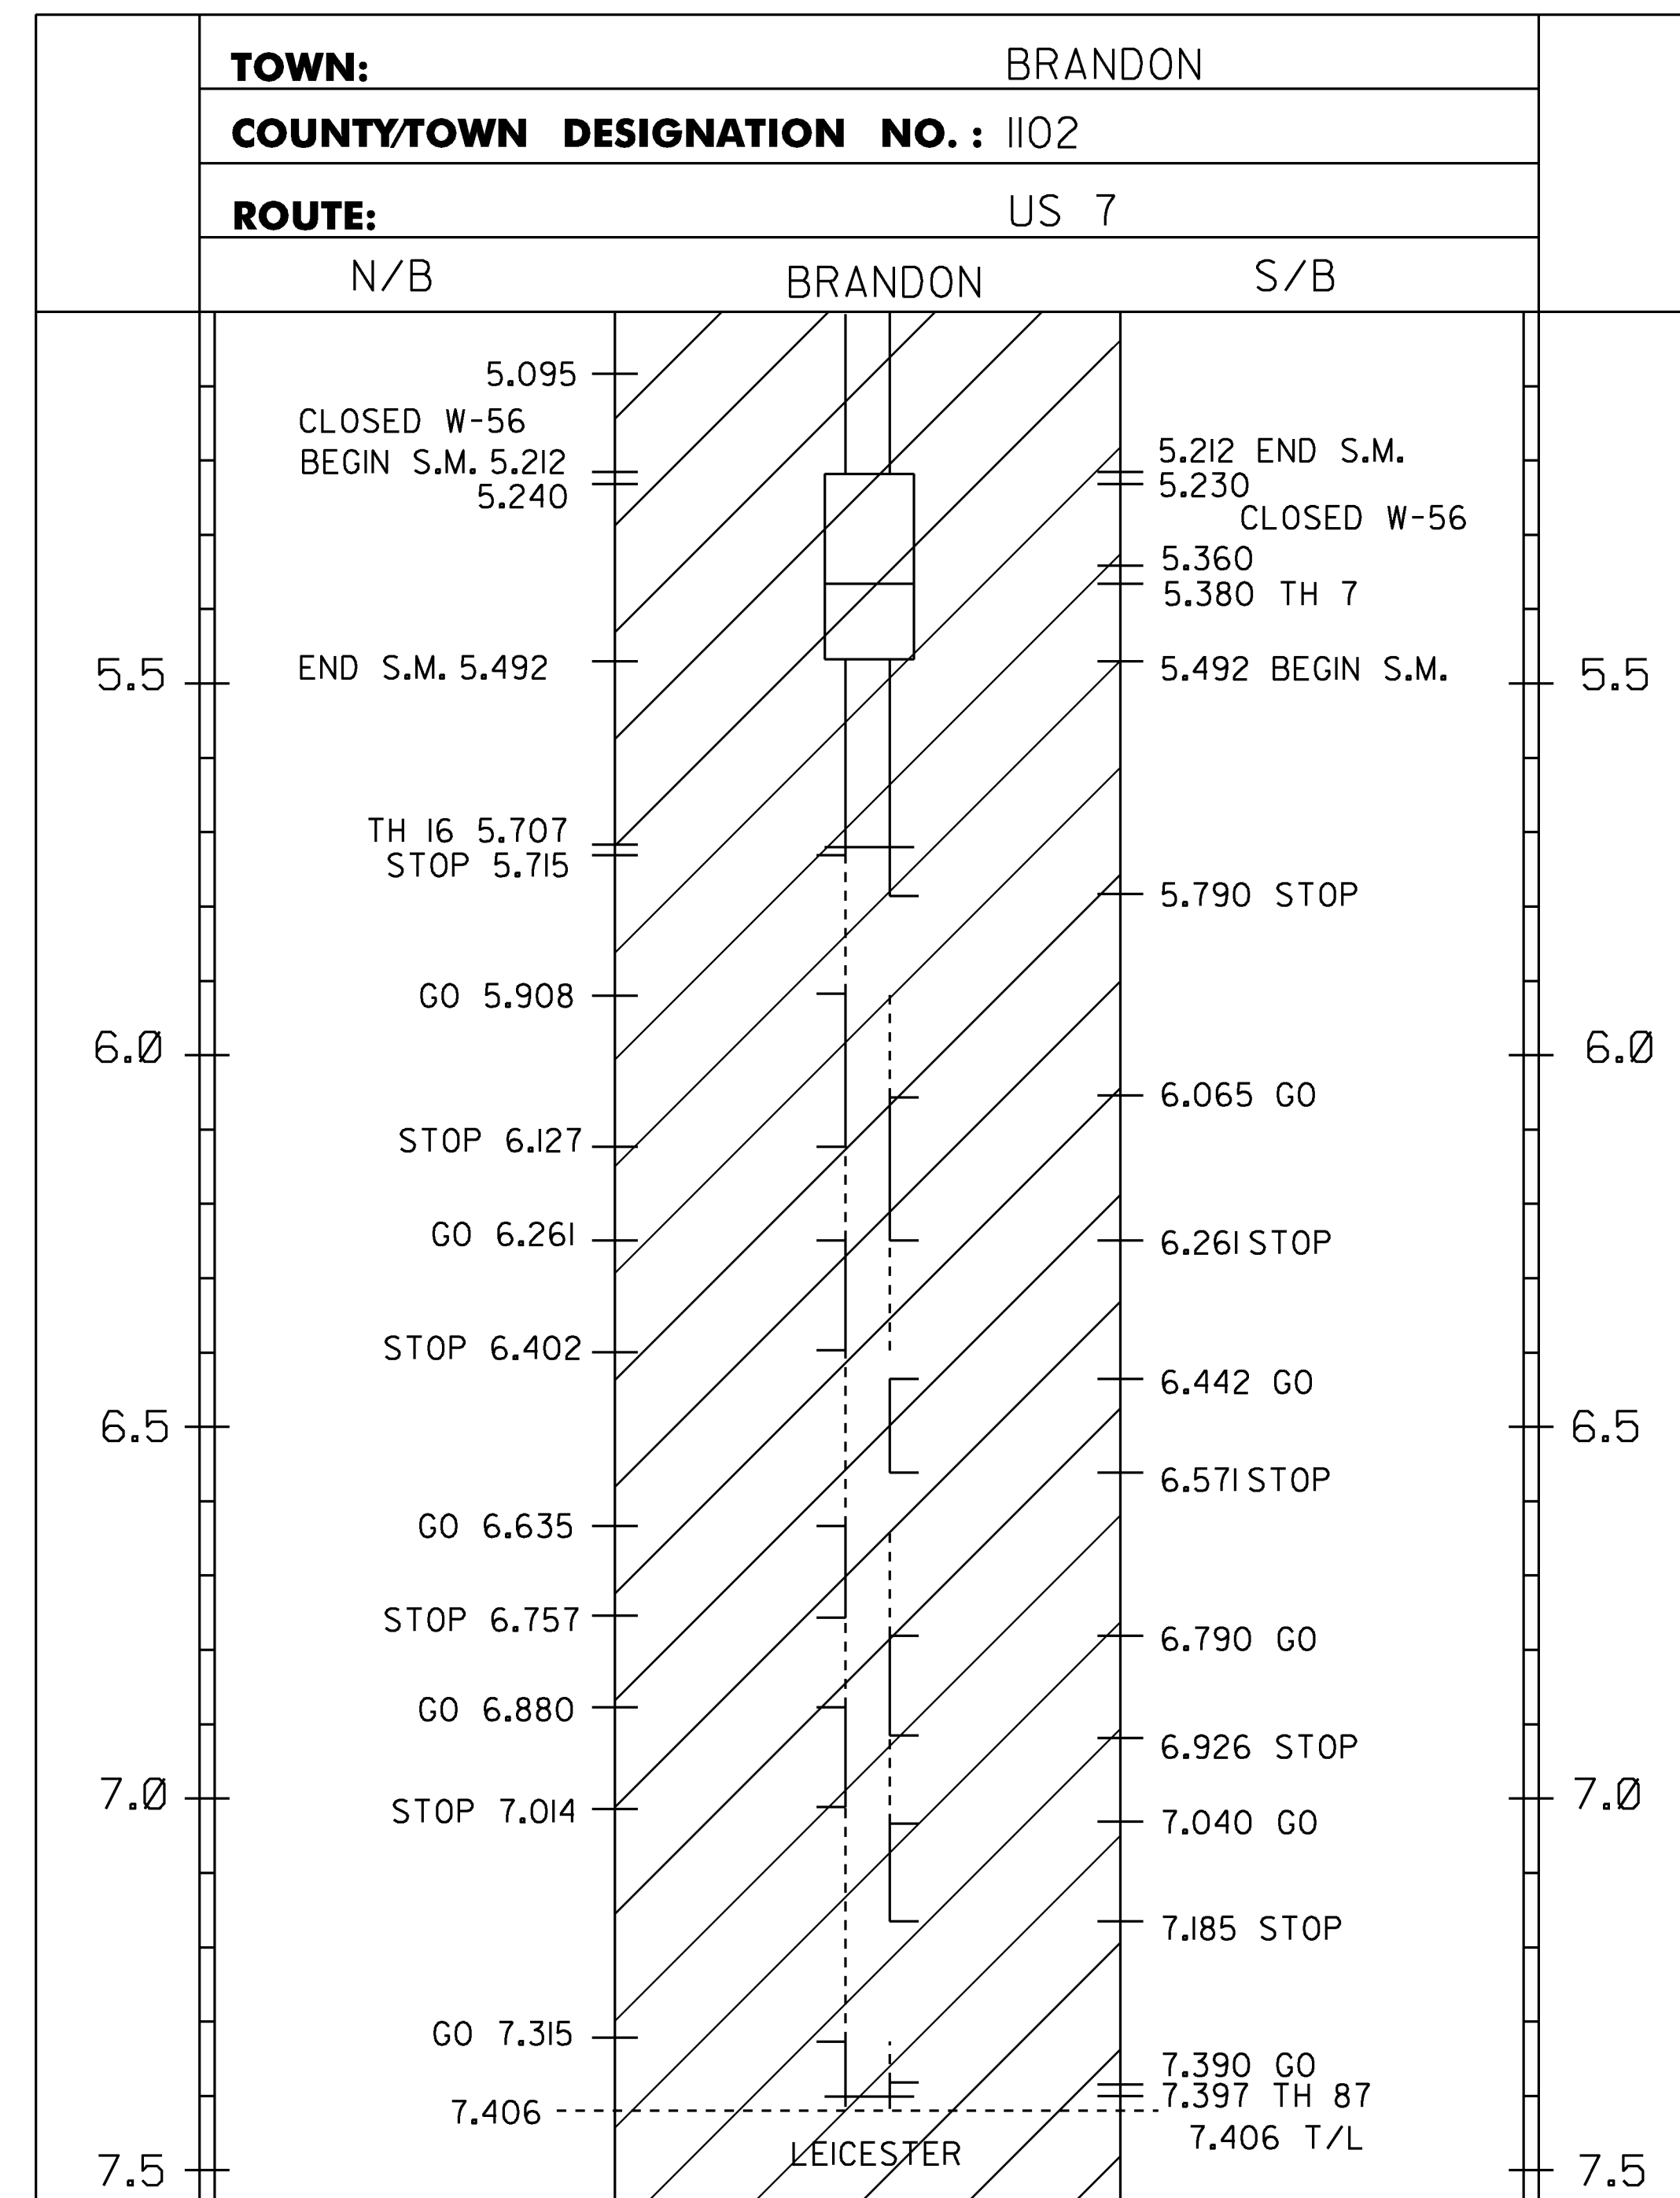

**LEGEND**  
 TWBH-THROUGHWAY BEGINS HERE  
 TWEH-THROUGHWAY ENDS HERE  
 SHB-STATE HIGHWAY BEGINS  
 SHE-STATE HIGHWAY ENDS  
 SL-SPEED LIMIT  
 SM-SPECIAL MARKINGS  
 T/L-TOWN LINE

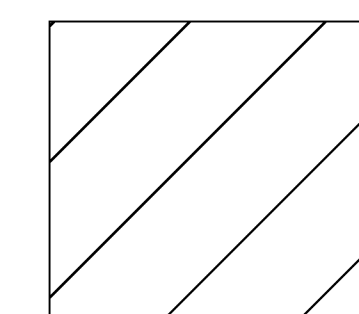

PROJECT AREA

**NOTES:**  
 1. THIS SHEET TO BE USED FOR THE LAYOUT OF ALL CENTERLINE PAVEMENT MARKINGS.  
 THE RESIDENT ENGINEER MAY CONTACT KEITH SWEET, PAVEMENT MARKING SUPERVISOR  
 AT (802) 828-5573 FOR ASSISTANCE LAYING OUT THE CENTERLINE DURING CONSTRUCTION.

**NOT TO SCALE**

PROJECT NAME:	BRANDON - MIDDLEBURY
PROJECT NUMBER:	NH SURF(43)
FILE NAME:	pl3B6I6_Brandon-Middlebury.dgn
PROJECT LEADER:	M. FOWLER
DESIGNED BY:	N. PAPPAS
LAYOUT SHEET 1	
PLLOT DATE:	02-JUN-2014
DRAWN BY:	N. PAPPAS
CHECKED BY:	M. FOWLER
SHEET 8	OF 28