

**TEMPORARY 4 INCH WHITE LINE, PAINT**  
 (ALL LINES WILL INCLUDE EDGE LINE BREAKS AND RADIUS FOR TOWN HIGHWAYS)

BRANDON:  
 MM 5.210 - MM 5.505 LT & RT  
 MM 5.308 - MM 5.339 DOTTED LINE 11' RT  
 MM 5.339 - MM 5.376 LANE LINE 11' RT  
 MM 5.382 - MM 5.466 LANE LINE 12' LT  
 MM 5.466 - MM 5.499 DOTTED LINE 12' LT

**DURABLE 4 INCH WHITE LINE, POLYUREA**  
 (ALL LINES WILL INCLUDE EDGE LINE BREAKS AND RADIUS FOR TOWN HIGHWAYS)

BRANDON:  
 MM 5.210 - MM 5.505 LT & RT  
 MM 5.308 - MM 5.339 DOTTED LINE 11' RT  
 MM 5.339 - MM 5.376 LANE LINE 11' RT  
 MM 5.382 - MM 5.466 LANE LINE 12' LT  
 MM 5.466 - MM 5.499 DOTTED LINE 12' LT

**TEMPORARY 4 INCH YELLOW LINE, PAINT**  
 (ALL LINES WILL INCLUDE C/L BREAKS FOR TOWN HIGHWAYS) S=SOLID, D=DASHED

BRANDON:  
 MM 5.210 - MM 5.212 LT C RT  
 MM 5.210 - MM 5.212 S - S  
 MM 5.339 - MM 5.376 S - S  
 MM 5.492 - MM 5.505 S - S  
 MM 5.212 - MM 5.339 DOUBLE SOLID LINE C/L & RT (MEDIAN TAPER)  
 MM 5.380 DOUBLE SOLID LT, T-7  
 MM 5.384 - MM 5.492 DOUBLE SOLID LINE C/L & RT (MEDIAN TAPER)

**DURABLE 4 INCH YELLOW LINE, POLYUREA**  
 (ALL LINES WILL INCLUDE C/L BREAKS FOR TOWN HIGHWAYS) S=SOLID, D=DASHED

BRANDON:  
 MM 5.210 - MM 5.212 LT C RT  
 MM 5.210 - MM 5.212 S - S  
 MM 5.339 - MM 5.376 S - S  
 MM 5.492 - MM 5.505 S - S  
 MM 5.212 - MM 5.339 DOUBLE SOLID LINE C/L & RT (MEDIAN TAPER)  
 MM 5.380 DOUBLE SOLID LT, T-7  
 MM 5.384 - MM 5.492 DOUBLE SOLID LINE C/L & RT (MEDIAN TAPER)

**TEMPORARY 8 INCH YELLOW LINE, PAINT**

BRANDON:  
 MM 5.210 - MM 5.339 RT, (DIAGONALS MEDIAN)(377 FT)  
 MM 5.384 - MM 5.499 RT, (DIAGONALS MEDIAN)(328 FT)

**DURABLE 8 INCH YELLOW LINE, POLYUREA**

BRANDON:  
 MM 5.210 - MM 5.339 RT, (DIAGONALS MEDIAN)(377 FT)  
 MM 5.384 - MM 5.499 RT, (DIAGONALS MEDIAN)(328 FT)

**TEMPORARY 24 INCH STOP BAR, PAINT**

BRANDON:  
 MM 5.380 LT, T-7

**DURABLE 24 INCH STOP BAR, (OPTION BID ITEM)**


BRANDON:  
 MM 5.380 LT, T-7

**TEMPORARY LETTER OR SYMBOL, PAINT**


BRANDON:  
 MM 5.340 RT, ARROW (1EA)  
 MM 5.349 RT, "O,N,L,Y" (4 EA)  
 MM 5.358 RT, ARROW (1EA)  
 MM 5.367 RT, "O,N,L,Y" (4 EA)  
 MM 5.375 RT, ARROW (1EA)  
 MM 5.380 LT, T-7 "S,T,O,P" (4 EA)  
 MM 5.398 LT, ARROW (1EA)  
 MM 5.414 LT, "O,N,L,Y" (4 EA)  
 MM 5.431 LT, ARROW (1EA)  
 MM 5.448 LT, "O,N,L,Y" (4 EA)  
 MM 5.465 LT, ARROW (1EA)

**DURABLE LETTER OR SYMBOL, (OPTION BID ITEM)**

BRANDON:  
 MM 5.340 RT, ARROW (1EA)  
 MM 5.349 RT, "O,N,L,Y" (4 EA)  
 MM 5.358 RT, ARROW (1EA)  
 MM 5.367 RT, "O,N,L,Y" (4 EA)  
 MM 5.375 RT, ARROW (1EA)  
 MM 5.380 LT, T-7 "S,T,O,P" (4 EA)  
 MM 5.398 LT, ARROW (1EA)  
 MM 5.414 LT, "O,N,L,Y" (4 EA)  
 MM 5.431 LT, ARROW (1EA)  
 MM 5.448 LT, "O,N,L,Y" (4 EA)  
 MM 5.465 LT, ARROW (1EA)

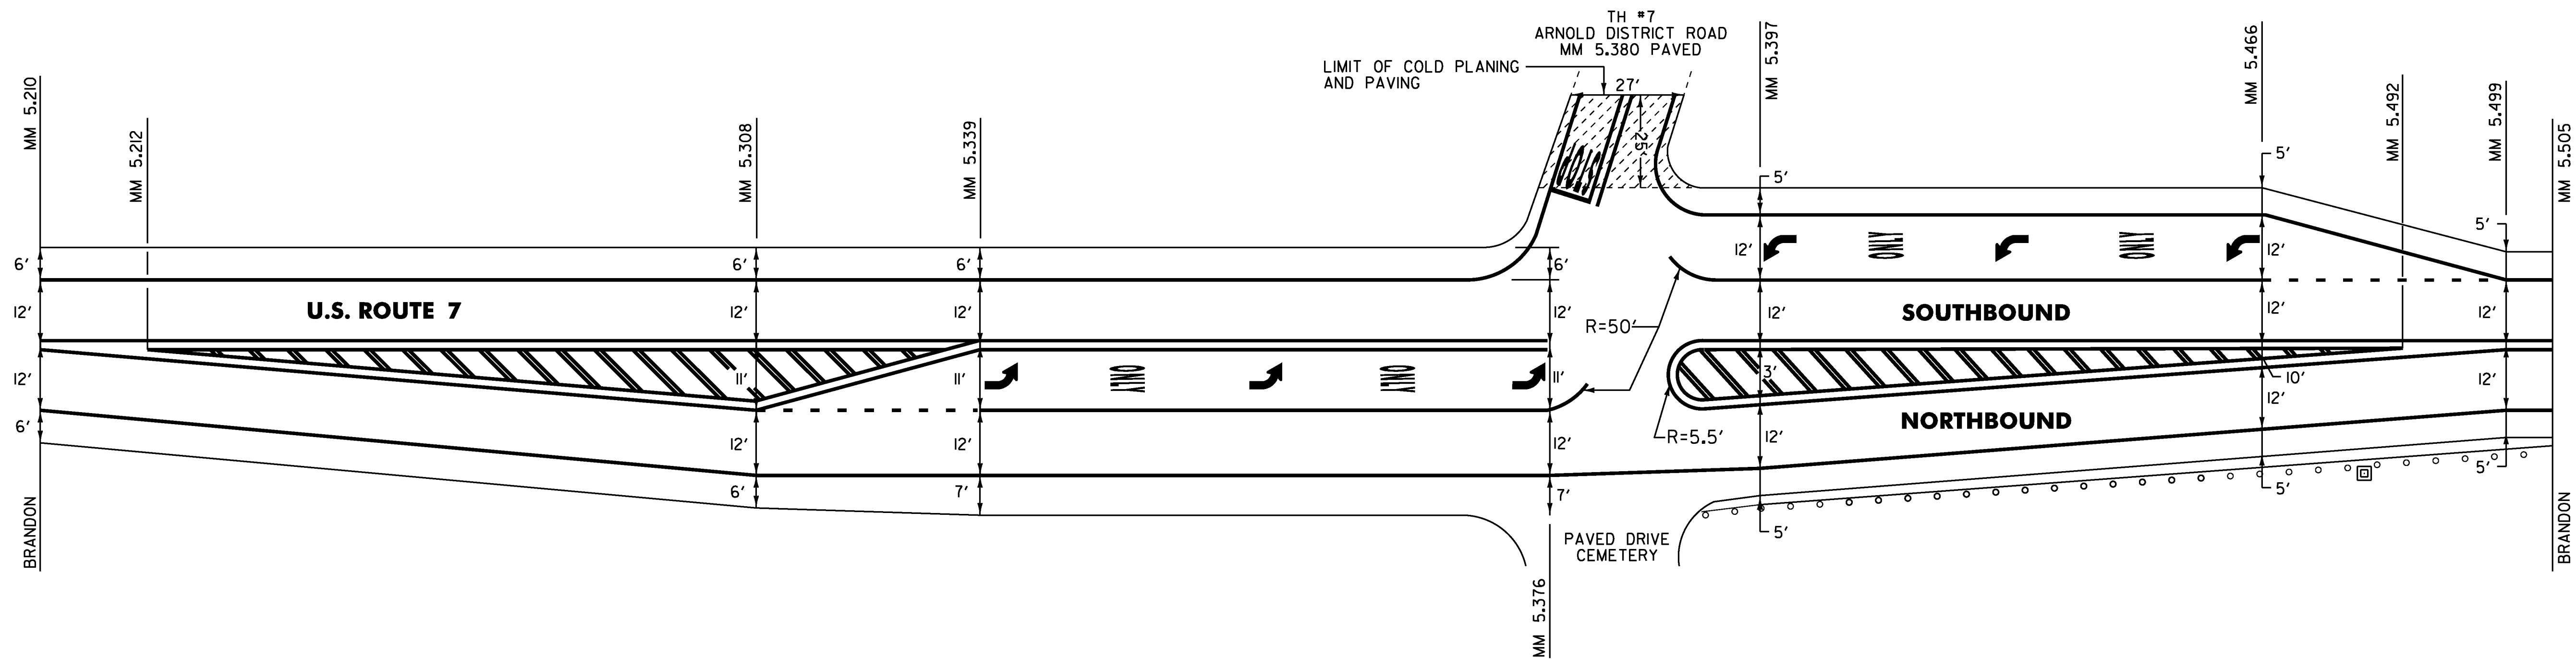

LEGEND: COLD PLANE AREA

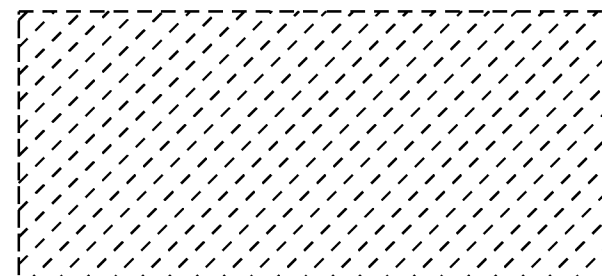

NOT TO SCALE

PROJECT NAME: BRANDON - MIDDLEBURY  
 PROJECT NUMBER: NH SURF(43)

FILE NAME: pl3B6I6\_Brandon-Middlebury.dgn PLOT DATE: 02-JUN-2014  
 PROJECT LEADER: M. FOWLER DRAWN BY: N. PAPPAS  
 DESIGNED BY: N. PAPPAS CHECKED BY: M. FOWLER  
 LAYOUT SHEET 6 SHEET 13 OF 28