

**TEMPORARY 4 INCH WHITE LINE, PAINT**  
 (ALL LINES WILL INCLUDE EDGE LINE BREAKS AND RADIUS FOR TOWN HIGHWAYS)

MIDDLEBURY:  
 MM 1,131 - MM 1,454 LT & RT  
 MM 1,232 - MM 1,300 LANE LINE 12' LT  
 MM 1,237 - MM 1,274 12' RT  
 MM 1,237 (ALONG VT 125 EDGE OF ISLAND)  
 MM 1,274 - MM 1,300 DASHED LINE 12' RT  
 MM 1,300 - MM 1,305 DOTTED LINE 12' LT

**DURABLE 4 INCH WHITE LINE, POLYUREA**  
 (ALL LINES WILL INCLUDE EDGE LINE BREAKS AND RADIUS FOR TOWN HIGHWAYS)

MIDDLEBURY:  
 MM 1,131 - MM 1,454 LT & RT  
 MM 1,232 - MM 1,300 LANE LINE 12' LT  
 MM 1,237 - MM 1,274 12' RT  
 MM 1,237 (ALONG VT 125 EDGE OF ISLAND)  
 MM 1,274 - MM 1,300 DASHED LINE 12' RT  
 MM 1,300 - MM 1,305 DOTTED LINE 12' LT

**TEMPORARY 4 INCH YELLOW LINE, PAINT**  
 (ALL LINES WILL INCLUDE C/L BREAKS FOR TOWN HIGHWAYS) S=SOLID, D=DASHED

MIDDLEBURY:  
 LT C RT  
 MM 1,131 - MM 1,136 S - S  
 MM 1,448 - MM 1,454 S - S  
 MM 1,136 - MM 1,176 DOUBLE SOLID LT & RT, (EDGE OF MEDIAN)  
 MM 1,176 - MM 1,220 LT & RT, (RAISED ISLAND)  
 MM 1,232 DOUBLE SOLID RT, VT-ROUTE 125  
 MM 1,237 - MM 1,305 SOLID LINE LT & RT  
 MM 1,239 - MM 1,249 (LT EDGE OF RAMP VT 125)  
 MM 1,305 - MM 1,341 SOLID LINE LT & RT (RAISED ISLAND)  
 MM 1,336 - MM 1,356 LT & RT (DASHED LINE BETWEEN ISLANDS)  
 MM 1,355 - MM 1,397 SOLID LINE LT & RT (RAISED ISLAND)  
 MM 1,397 - MM 1,448 DOUBLE SOLID LT & RT (EDGE OF MEDIAN)

**DURABLE 4 INCH YELLOW LINE, POLYUREA**  
 (ALL LINES WILL INCLUDE C/L BREAKS FOR TOWN HIGHWAYS) S=SOLID, D=DASHED

MIDDLEBURY:  
 LT C RT  
 MM 1,131 - MM 1,136 S - S  
 MM 1,448 - MM 1,454 S - S  
 MM 1,136 - MM 1,176 DOUBLE SOLID LT & RT, (EDGE OF MEDIAN)  
 MM 1,176 - MM 1,220 LT & RT, (RAISED ISLAND)  
 MM 1,232 DOUBLE SOLID RT, VT-ROUTE 125  
 MM 1,237 - MM 1,305 SOLID LINE LT & RT  
 MM 1,239 - MM 1,249 (LT EDGE OF RAMP VT 125)  
 MM 1,305 - MM 1,341 SOLID LINE LT & RT (RAISED ISLAND)  
 MM 1,336 - MM 1,356 LT & RT (DASHED LINE BETWEEN ISLANDS)  
 MM 1,355 - MM 1,397 SOLID LINE LT & RT (RAISED ISLAND)  
 MM 1,397 - MM 1,448 DOUBLE SOLID LT & RT (EDGE OF MEDIAN)

**TEMPORARY 24 INCH STOP BAR, PAINT**  
 MIDDLEBURY:  
 MM 1,235 RT, VT. ROUTE 125


**DURABLE 24 INCH STOP BAR (OPTION BID ITEM)**  
 MIDDLEBURY:  
 MM 1,235 RT, VT. ROUTE 125

**TEMPORARY LETTER OR SYMBOL, PAINT**

MIDDLEBURY:  
 MM 1,235 RT, VT. ROUTE 125, "S,T,O,P" (4 EA)  
 MM 1,237 - MM 1,239 LT, ARROW (1EA)  
 MM 1,252 - MM 1,254 LT, "O,N,L,Y" (4 EA)  
 MM 1,267 - MM 1,269 LT, ARROW (1EA)  
 MM 1,282 - MM 1,284 LT, "O,N,L,Y" (4 EA)  
 MM 1,297 - MM 1,299 LT, ARROW (1EA)

**DURABLE LETTER OR SYMBOL (OPTION BID ITEM)**

MIDDLEBURY:  
 MM 1,235 RT, VT. ROUTE 125, "S,T,O,P" (4 EA)  
 MM 1,237 - MM 1,239 LT, ARROW (1EA)  
 MM 1,252 - MM 1,254 LT, "O,N,L,Y" (4 EA)  
 MM 1,267 - MM 1,269 LT, ARROW (1EA)  
 MM 1,282 - MM 1,284 LT, "O,N,L,Y" (4 EA)  
 MM 1,297 - MM 1,299 LT, ARROW (1EA)

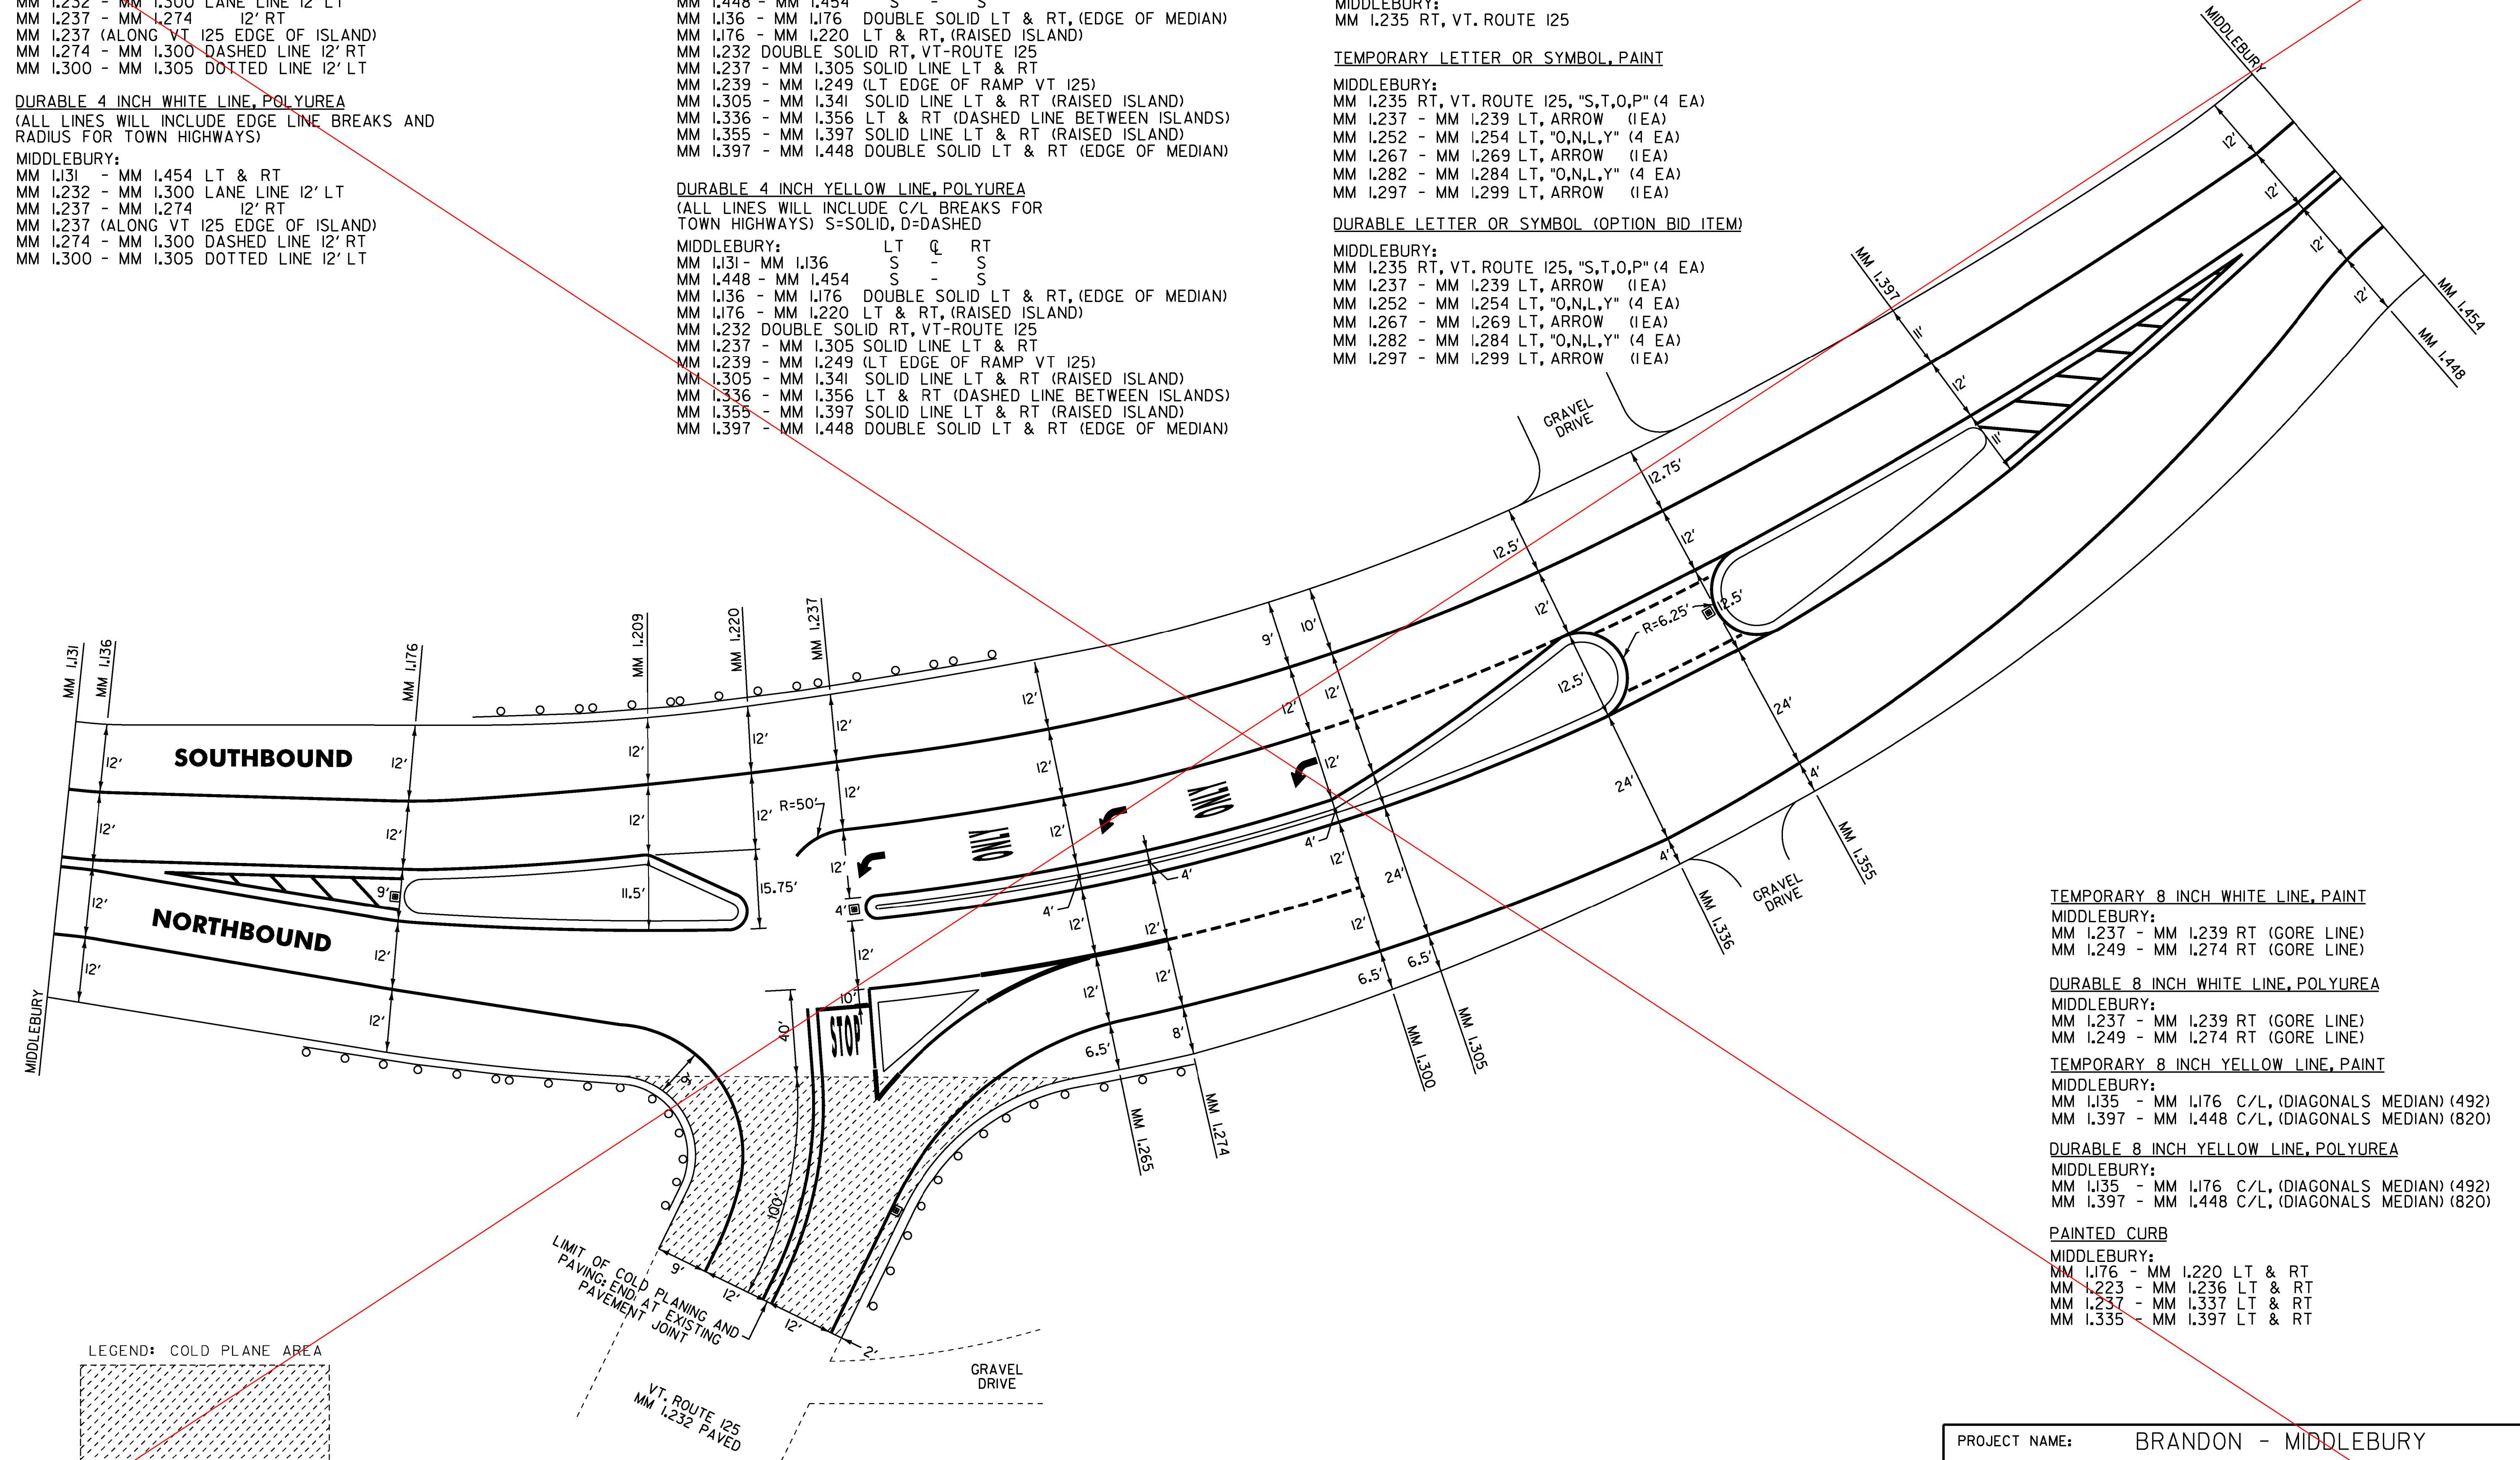


**TEMPORARY 8 INCH WHITE LINE, PAINT**  
 MIDDLEBURY:  
 MM 1,237 - MM 1,239 RT (GORE LINE)  
 MM 1,249 - MM 1,274 RT (GORE LINE)

**DURABLE 8 INCH WHITE LINE, POLYUREA**  
 MIDDLEBURY:  
 MM 1,237 - MM 1,239 RT (GORE LINE)  
 MM 1,249 - MM 1,274 RT (GORE LINE)

**TEMPORARY 8 INCH YELLOW LINE, PAINT**  
 MIDDLEBURY:  
 MM 1,135 - MM 1,176 C/L, (DIAGONALS MEDIAN) (492)  
 MM 1,397 - MM 1,448 C/L, (DIAGONALS MEDIAN) (820)

**DURABLE 8 INCH YELLOW LINE, POLYUREA**  
 MIDDLEBURY:  
 MM 1,135 - MM 1,176 C/L, (DIAGONALS MEDIAN) (492)  
 MM 1,397 - MM 1,448 C/L, (DIAGONALS MEDIAN) (820)

**PAINTED CURB**  
 MIDDLEBURY:  
 MM 1,176 - MM 1,220 LT & RT  
 MM 1,223 - MM 1,236 LT & RT  
 MM 1,237 - MM 1,337 LT & RT  
 MM 1,335 - MM 1,397 LT & RT

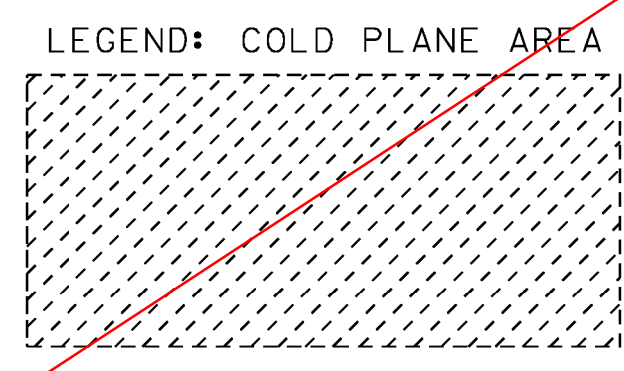

LIMIT OF COLD PLANING AND PAVING END AT EXISTING PAVEMENT JOINT

VT-ROUTE 125 MM 1,232 PAVED

GRAVEL DRIVE

**NOT TO SCALE**  
**NOTE: SEE TYPICAL MARKINGS FOR TURN LANES ON LAYOUT SHEET 13.**

PROJECT NAME:	BRANDON - MIDDLEBURY		
PROJECT NUMBER:	NH SURF(43)		
FILE NAME:	pi3B616_Brandon-Middlebury.dgn	PLOT DATE:	02-JUN-2014
PROJECT LEADER:	M. FOWLER	DRAWN BY:	N. PAPPAS
DESIGNED BY:	N. PAPPAS	CHECKED BY:	M. FOWLER
LAYOUT SHEET	9	SHEET	16 OF 28