

TEMPORARY 4 INCH WHITE LINE, PAINT
 (ALL LINES WILL INCLUDE EDGE LINE BREAKS AND RADIUS FOR TOWN HIGHWAYS)

MIDDLEBURY:
 MM 3.818 - MM 4.002 LT & RT
 MM 3.899 - MM 3.933 RT, DOTTED LINE
 MM 3.933 - MM 3.973 RT, SOLID LINE (LANE LINE)
 MM 4.000 - MM 4.002 LT, SOLID LINE (LANE LINE)
 MM 4.000 - MM 4.002 LT, SOLID LINE (LANE LINE)
 RITE AID PHARMACY ENTRANCE - SOLID EDGELINE LT & RT
 HANNAFORDS/CENTER PLAZA ENTRANCE - SOLID EDGELINE LT & RT

DURABLE 4 INCH WHITE LINE, POLYUREA
 (ALL LINES WILL INCLUDE EDGE LINE BREAKS AND RADIUS FOR TOWN HIGHWAYS)

MIDDLEBURY:
 MM 3.818 - MM 4.002 LT & RT
 MM 3.899 - MM 3.933 RT, DOTTED LINE
 MM 3.933 - MM 3.973 RT, SOLID LINE (LANE LINE)
 MM 4.000 - MM 4.002 LT, SOLID LINE (LANE LINE)
 MM 4.000 - MM 4.002 LT, SOLID LINE (LANE LINE)
 RITE AID PHARMACY ENTRANCE - SOLID EDGELINE LT & RT
 HANNAFORDS/CENTER PLAZA ENTRANCE - SOLID EDGELINE LT & RT

TEMPORARY 4 INCH YELLOW LINE, PAINT
 (ALL LINES WILL INCLUDE C/L BREAKS FOR TOWN HIGHWAYS) S=SOLID, D=DASHED

MIDDLEBURY:
 MM 3.818 - MM 3.933 DOUBLE SOLID LT & RT (MEDIAN)
 MM 3.933 - MM 3.973 DOUBLE SOLID LT
 MM 3.994 - MM 4.002 DOUBLE SOLID LT & RT
 RITE AID PHARMACY ENTRANCE DOUBLE SOLID RT
 HANNAFORDS/CENTER PLAZA ENTRANCE (BOTH SIDES OF RAISED ISLAND)

DURABLE 4 INCH YELLOW LINE, POLYUREA
 (ALL LINES WILL INCLUDE C/L BREAKS FOR TOWN HIGHWAYS) S=SOLID, D=DASHED

MIDDLEBURY:
 MM 3.818 - MM 3.933 DOUBLE SOLID LT & RT (MEDIAN)
 MM 3.933 - MM 3.973 DOUBLE SOLID LT
 MM 3.994 - MM 4.002 DOUBLE SOLID LT & RT
 RITE AID PHARMACY ENTRANCE DOUBLE SOLID RT
 HANNAFORDS/CENTER PLAZA ENTRANCE (BOTH SIDES OF RAISED ISLAND)

TEMPORARY 8 INCH YELLOW LINE, PAINT

MIDDLEBURY:
 MM 3.818 - MM 3.933 C/L (DIAGONALS MEDIAN) (820 FT)

DURABLE 8 INCH YELLOW LINE

MIDDLEBURY:
 MM 3.818 - MM 3.933 C/L (DIAGONALS MEDIAN) (820 FT)

TEMPORARY LETTER OR SYMBOL

MIDDLEBURY:
 MM 3.858 RT, "S,I,G,N,A,L A,H,E,A,D" (11EA)
 MM 3.934 RT, ARROW (1EA)
 MM 3.934 RT, DOUBLE ARROW (2 EA)
 MM 3.943 RT, "O,N,L,Y" (4 EA)
 MM 3.953 RT, ARROW (1EA)
 MM 3.953 RT, DOUBLE ARROW (2 EA)
 MM 3.963 RT, "O,N,L,Y" (4 EA)
 MM 3.972 RT, ARROW (1EA)
 MM 3.972 RT, DOUBLE ARROW (2 EA)
 MM 4.001 LT, ARROW (1EA)
 MM 4.001 LT, ARROW (1EA)

DURABLE LETTER OR SYMBOL (OPTION BID ITEM)


MIDDLEBURY:
 MM 3.858 RT, "S,I,G,N,A,L A,H,E,A,D" (11EA)
 MM 3.934 RT, ARROW (1EA)
 MM 3.934 RT, DOUBLE ARROW (2 EA)
 MM 3.943 RT, "O,N,L,Y" (4 EA)
 MM 3.953 RT, ARROW (1EA)
 MM 3.953 RT, DOUBLE ARROW (2 EA)
 MM 3.963 RT, "O,N,L,Y" (4 EA)
 MM 3.972 RT, ARROW (1EA)
 MM 3.972 RT, DOUBLE ARROW (2 EA)
 MM 4.001 LT, ARROW (1EA)
 MM 4.001 LT, ARROW (1EA)

TEMPORARY CROSSWALK MARKING, PAINT


MIDDLEBURY:
 MM 3.967 HANNAFORDS/ENTRANCE CENTER PLAZA - LT
 MM 3.967 RITE AID PHARMACY ENTRANCE - RT
 MM 3.999

DURABLE CROSSWALK MARKING (OPTION BID ITEM)

MIDDLEBURY:
 MM 3.967 HANNAFORDS/ENTRANCE CENTER PLAZA - LT
 MM 3.967 RITE AID PHARMACY ENTRANCE - RT
 MM 3.999

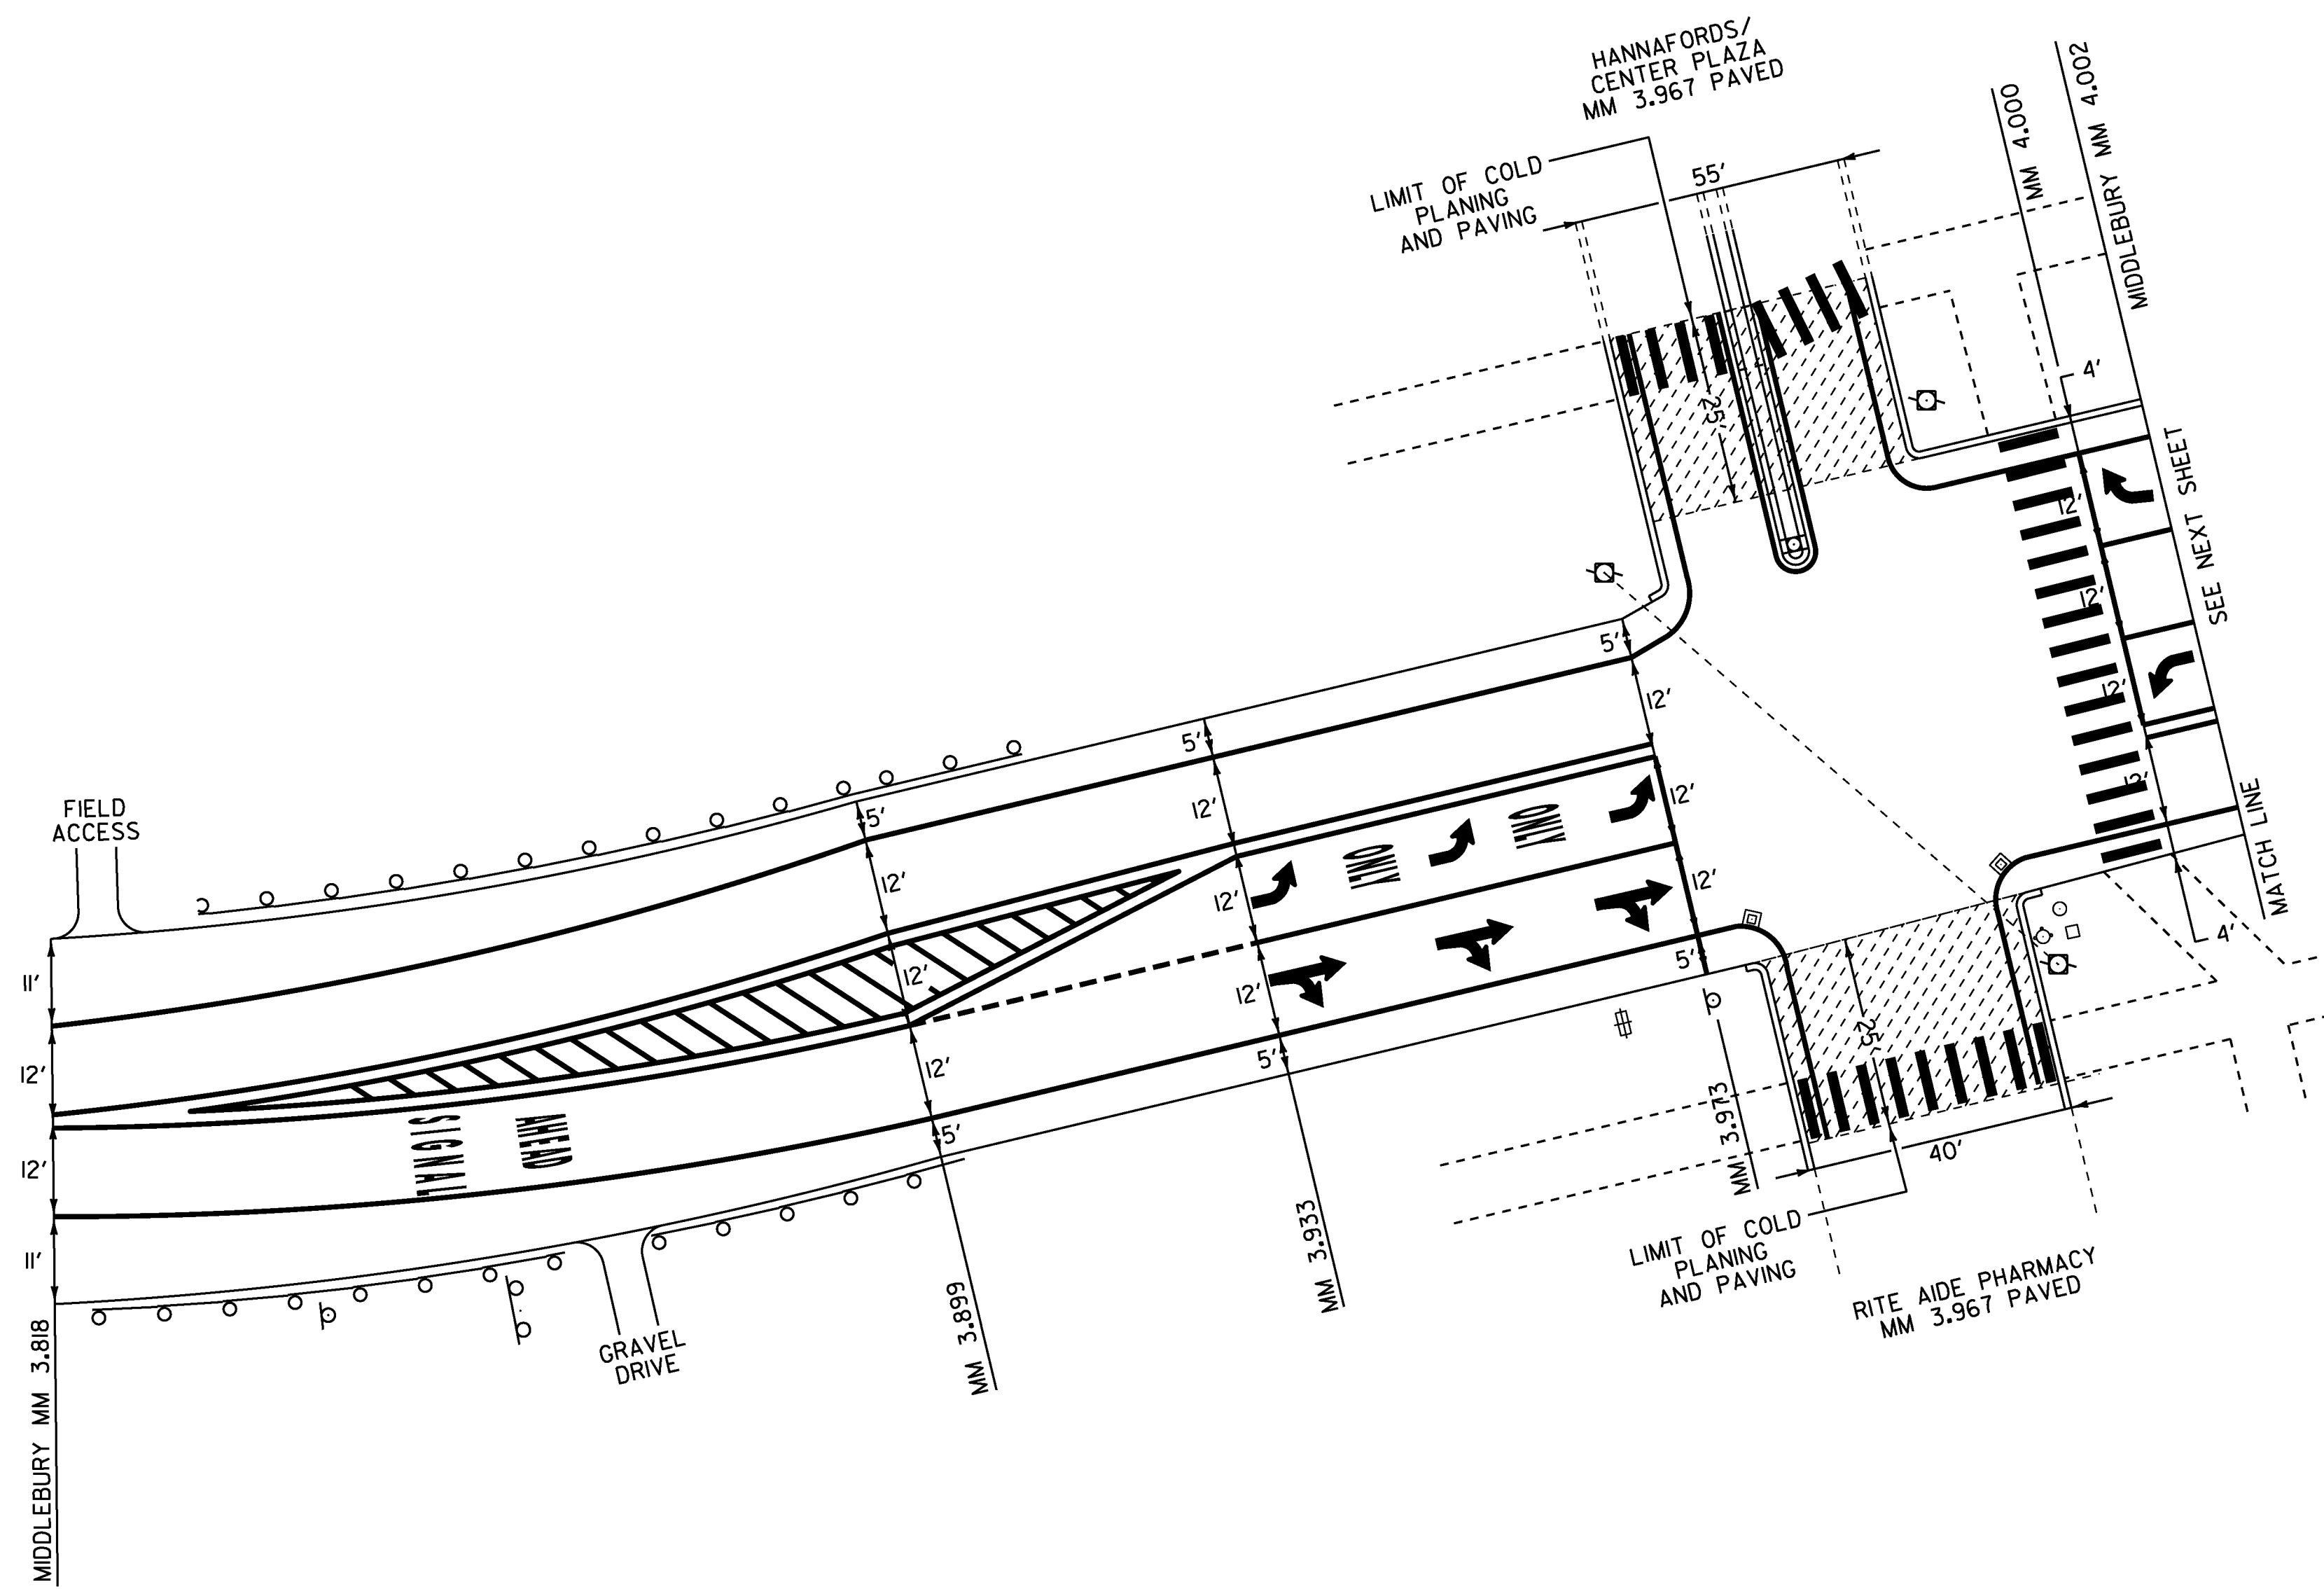

LEGEND: COLD PLANE AREA

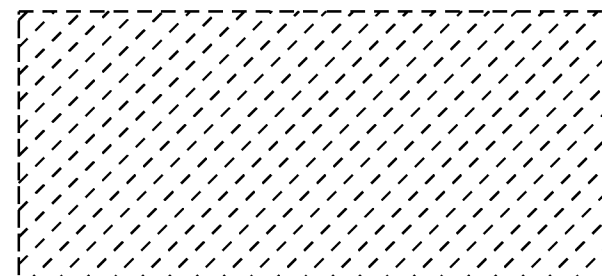

NOTES:

- 1) SEE TYPICAL MARKINGS FOR TURN LANES ON LAYOUT SHEET 13.
- 2) SEE TRAFFIC SIGNAL SYSTEMS SHEET 21 NOTE 6 BEFORE COLD PLANING.

NOT TO SCALE

PROJECT NAME:	BRANDON - MIDDLEBURY
PROJECT NUMBER:	NH SURF(43)
FILE NAME:	pl3B6I6_Brandon-Middlebury.dgn
PROJECT LEADER:	M. FOWLER
DESIGNED BY:	N. PAPPAS
LAYOUT SHEET 10	
PLLOT DATE:	02-JUN-2014
DRAWN BY:	N. PAPPAS
CHECKED BY:	M. FOWLER
SHEET 17	OF 28