
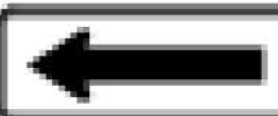








DIRECTION	MILEPOINT	LOCATION CODE (SHEET 2)	SIGN CODE	WIDTH (IN)	HEIGHT (IN)	SHEETING REMARKS	SIGN LEGEND	NEW SIGNS		EXISTING SIGNS			EXIST POST		NUMBER OF NEW POSTS	SQUARE STEEL (IN)			TUBULAR STEEL Ø (IN)				SIGN FRAME REQUIRED	REMARKS	SIGN DETAIL LOCATION				
								"A"	"B"	RETAIN	SALVAGE FROM	SALVAGE TO	REMOVE	RETAIN		REMOVE	1.75	2.00	2.50	FOUNDATION	3.00	3.50			4.00	5.00	SHSM	PROJECT SHEET #	STANDARD SHEET #
																	(LB / FT)				(LB / FT)								
STOWE VT-108 NB							FY-FLUORESCENT YELLOW FYG-FLUORESCENT YELLOW GREEN	6/17														"SHSM"-STANDARD HIGHWAY SIGNS AND MARKINGS							
NB	1.108	A	R2-1	24	30		SPEED LIMIT 30	6/17																					
		A	R2-1	24	30			6/17	5.00																		X		
NB	1.178	A	W1-6	48	24		<=== LEFT LARGE ARROW	6/17																					
		A	W1-6L	48	24			6/17	8.00																		X		
NB	1.178	B	W1-6	48	24		RIGHT ===> LARGE ARROW	6/17																					
		B	W1-6R	48	24			6/17	8.00																		X		
NB	1.188	A/B	D3-1	UNK.	UNK.		TOWN FARM LN	6/17																					
		A/B	D3-1	70	12			6/17	5.83																		11		
NB	1.198	A	W1-6	48	24		<=== LEFT LARGE ARROW	6/17																					
		A	VD-700	6	10		MILE MARKER	6/17																			SALVAGE AND MOUNT ON NEW POST BELOW ARROW		
		A	W1-6L	48	24			6/17	8.00																		X		
NB	1.200	B	W1-6R	48	24			6/17	8.00																		X		
NB	1.267	A	W1-8L	18	24			TRIM 6/17	3.00																		X		
		B	W1-8R	18	24			6/17	3.00																		X		
NB	1.272	B	W1-6	48	24		RIGHT ===> LARGE ARROW	6/17																					
SIGN SUMMARY SHEET							SHEET TOTALS			48.83	0.00	0	1	1	7	0	0	12	154.5	0	0.0	0.0	0.0	0.0	PROJECT NAME: STOWE - BERKSHIRE				
										SF	SF	EA	EA	EA	EA	EA	EA	EA	EA	EA	EA	EA	EA	PROJECT NUMBER: STPG SIGN (49)					
VERMONT AGENCY OF TRANSPORTATION							TOWN DIRECTIONAL TOTALS			418.6	0.0	36	15	6	85	0	0	79	1185.0	0		0.0			FILE NAME: 01 STOWE VT-108 NB TSS.xls PLOT DATE: 6/24/2015				
																								PROJECT MANAGER: D. BRYANT DRAWN BY: J. BLANCHARD					
																								DESIGNED BY: J. BLANCHARD CHECKED: K. KERN					
																								STOWE NB SHEET 4 SHEET 18 OF 131					