

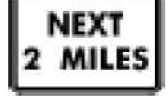



DIRECTION	MILEPOINT	LOCATION CODE (SHEET 2)	SIGN CODE	WIDTH (IN)	HEIGHT (IN)	SHEETING REMARKS	SIGN LEGEND	NEW SIGNS		EXISTING SIGNS			EXIST POST		NUMBER OF NEW POSTS	SQUARE STEEL (IN)			TUBULAR STEEL Ø (IN)				SIGN FRAME REQUIRED	REMARKS	SIGN DETAIL LOCATION				
								"A"	"B"	RETAIN	SALVAGE FROM	SALVAGE TO	REMOVE	RETAIN		REMOVE	1.75	2.00	2.50	FOUNDATION	3.00	3.50			4.00	5.00	SHSM	PROJECT SHEET #	STANDARD SHEET #
																	(LB / FT)				(LB / FT)								
STOWE VT-108 NB							FY-FLUORESCENT YELLOW FYG-FLUORESCENT YELLOW GREEN															"SHSM"-STANDARD HIGHWAY SIGNS AND MARKINGS							
		A/B	D3-1	56	12		 Liftline Dr PVT 6/24	4.67							2									LIFTLINE DRIVE PVT		11			
NB	7.523	A	R2-1	30	36		SPEED LIMIT 40 6/24			1																			
NB	7.578	A	VW-400	48	48	FY	SMUGGLERS NOTCH NOT RECOMMENDED FOR TRUCKS BUSES OR RVS TRIM 7/8			1																			
NB	7.620	A	W11-2	30	30	FYG	TRIM 7/8  6/24	6.25							1									INSTALL 222 FT NORTH OF SMUGGLERS NOTCH VW-400 SIGN	X				
		A	W7-3aP	24	18	FYG	 6/24	3.00																	X				
NB	7.689	A	W20-3	48	48		HINGED ROAD CLOSED 1000 FT						1																
		A	W20-3H	48	48	ORG	 8/24	16.00							2											X	9		
NB	7.667	A	M4-5	24	12		BEGIN STATE TRIM 7/8 6/24			1																			
		A	VM-064	24	12		SCENIC STATE 6/24			1																			
		A	M1-5A	30	24		VERMONT 108 6/24			1																			
NB	7.722	A	W16-18P	48	12		NOTICE 6/24			1																			
		A	VR5-2M	48	48		NO TRACTOR TRAILER SYMBOL 6/24			1																			
		A	VR-472	48	48		TRACTOR TRAILERS PROHIBITED 6/24			1																			
NB	7.795	A	VM-607	24	30		*10TH MTN DIV WW II MEMORIAL HIGHWAY 6/24			1																			
NB	7.810	A	OM4-1	18	18		RED CLUSTER TRIM 7/8 7/8						1												EXISTING SIGNS MOUNTED TO GATE				
SIGN SUMMARY SHEET							SHEET TOTALS	29.92	0.00	9	0	0	2	0	0	5	66.25	0	0.0	0.0	0.0	0.0							
							SF	SF	EA	EA	EA	EA	EA	EA	EA	EA	FT	EA	LB	LB	LB	LB							
VERMONT AGENCY OF TRANSPORTATION							TOWN DIRECTIONAL TOTALS	418.6	0.0	36	15	6	85	0	0	79	1185.0	0		0.0									
																					PROJECT NAME:	STOWE - BERKSHIRE							
																					PROJECT NUMBER:	STPG SIGN (49)							
																					FILE NAME:	01 STOWE VT-108 NB TSS.xls							
																					PLOT DATE:	6/24/2015							
																					PROJECT MANAGER:	D. BRYANT							
																					DRAWN BY:	J. BLANCHARD							
																					DESIGNED BY:	J. BLANCHARD							
																					CHECKED:	K. KERN							
																					SHEET	27							
																					OF	131							