

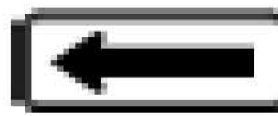





DIRECTION	MILEPOINT	LOCATION CODE (SHEET 2)	SIGN CODE	WIDTH (IN)	HEIGHT (IN)	SHEETING REMARKS	SIGN LEGEND	NEW SIGNS		EXISTING SIGNS			EXIST POST		NUMBER OF NEW POSTS	SQUARE STEEL (IN)			TUBULAR STEEL Ø (IN)				SIGN FRAME REQUIRED	REMARKS	SIGN DETAIL LOCATION				
								"A"	"B"	RETAIN	SALVAGE FROM	SALVAGE TO	REMOVE	RETAIN		REMOVE	1.75	2.00	2.50	FOUNDATION	3.00	3.50			4.00	5.00	SHSM	PROJECT SHEET #	STANDARD SHEET #
																	(LB / FT)				(LB / FT)								
STOWE VT-108 SB							FY-FLUORESCENT YELLOW FYG-FLUORESCENT YELLOW GREEN															"SHSM"-STANDARD HIGHWAY SIGNS AND MARKINGS							
SB	3.180	F	UNK.	UNK.	UNK.		EMPTY POST						X											REMOVE EMPTY POSTS IN THIS LOCATION					
		F	R2-1	24	30			6/13	5.00					1	14.75	X							X						
SB	2.779	F	R2-1	24	30		SPEED LIMIT 40	6/13				1	X																
		F	R2-1	24	30			6/13	5.00					1	13.75	X								REQUIRES VEGETATION CLEARING	X				
SB	2.727	F	W1-6	48	24		<=== LEFT LARGE ARROW	6/13				1	X																
		F	W1-6L	48	24		TRIM 7/7 	6/13	8.00					2	29.25	X							X						
SB	2.714	E	W1-6	48	24		RIGHT ===> LARGE ARROW	6/13				1	X																
		E	W1-6R	48	24		TRIM 7/7 	6/13	8.00					2	30.00	X							X						
SB	2.576	F	W1-4R	30	30		RIGHT REVERSE CURVE	6/14				1	X																
		F	VD-700	6	10		MILE MARKER	6/14				1																	
SB	2.505	F	W1-4R	30	30			6/14	6.25					1	14.50	X							X	INSTALL 375 FT SOUTH OF EXISTING					
SB	2.476	F	R2-1	24	30		SPEED LIMIT 40	6/14				1	X																
SB	2.466	F	R2-1	24	30			6/14	5.00					1	14.50	X							X	INSTALL 53 FT SOUTH OF EXISTING					
SB	2.380	F	W1-8	18	24		CHEVRON	6/14				1	X																
		F	VD-700	6	10		MILE MARKER	6/14				1																	
SIGN SUMMARY SHEET							SHEET TOTALS			37.25	0.00	0	0	0	8	0	0	8	116.75	0	0.0	0.0	0.0	0.0	PROJECT NAME: STOWE - BERKSHIRE PROJECT NUMBER: STPG SIGN (49)				
VERMONT AGENCY OF TRANSPORTATION							SF	SF	EA	EA	EA	EA	EA	EA	EA	EA	EA	FT	EA	LB	LB	LB	LB	FILE NAME: 02 STOWE VT-108 SB TSS.xls PLOT DATE: 6/24/2015 PROJECT MANAGER: D. BRYANT DRAWN BY: J. BLANCHARD DESIGNED BY: J. BLANCHARD CHECKED: K. KERN STOWE SB SHEET 6 SHEET 34 OF 131					
TOWN DIRECTIONAL TOTALS							515.2	0.0	18	11	9	110	0	0	85	1275.0	0	0.0											