





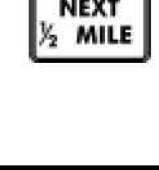


DIRECTION	MILEPOINT	LOCATION CODE (SHEET 2)	SIGN CODE	WIDTH (IN)	HEIGHT (IN)	SHEETING REMARKS	SIGN LEGEND	NEW SIGNS		EXISTING SIGNS			EXIST POST		NUMBER OF NEW POSTS	SQUARE STEEL (IN)			TUBULAR STEEL Ø (IN)				SIGN FRAME REQUIRED	REMARKS	SIGN DETAIL LOCATION				
								"A"	"B"	RETAIN	SALVAGE FROM	SALVAGE TO	REMOVE	RETAIN		REMOVE	1.75	2.00	2.50	FOUNDATION	3.00	3.50			4.00	5.00	SHSM	PROJECT SHEET #	STANDARD SHEET #
																	(LB / FT)				(LB / FT)								
<b>CAMBRIDGE VT-108 NB</b>							FY-FLUORESCENT YELLOW FYG-FLUORESCENT YELLOW GREEN															"SHSM"-STANDARD HIGHWAY SIGNS AND MARKINGS							
		B	W1-6R	48	24		 5/24	8.00							2	21.50 X							INSTALL 10 FT CLOSER TO VT108	X					
NB	2.731	A	VR-020	24	30		NO PARKING ON TRAVELED LANE 5/24					1		X															
		A	VR-020	24	30		 TRIM 7/6 5/24	5.00							1	14.25 X									9				
NB	2.822	A	VR-020	24	30		NO PARKING ON TRAVELED LANE 5/24					1		X															
		A	VR-020	24	30		 5/24	5.00							1	14.00 X									9				
NB	3.470	A	W3-5	36	36		 5/24	9.00							2	26.75 X							INSTALL 127 FT SOUTH OF EXISTING	X					
NB	3.494	A	W3-5	36	36		SPEED REDUCTION SPEED LIMIT 40 5/24					1		X															
NB	3.565	A	R2-1	24	30		SPEED LIMIT 40 5/24					1		X															
		A	R2-1	30	36		TRIM  5/24	7.50							1	15.75 X								X					
NB	3.627	A	R2-1	24	30		SPEED LIMIT 40 5/24					1		X															
NB	3.684	A	W11-2	30	30	FYG	PEDESTRIAN SYMBOL 5/24					1		X															
		A	W7-3aP	24	18	FYG	NEXT 1/2 MILE 5/24					1																	
		A	W11-2	30	30	FYG	TRIM  5/24	6.25							1	15.75 X								X					
		A	W7-3aP	24	18	FYG	 5/24	3.00																X					
NB	3.725	A	VW-205	36	36		WATCH FOR TURNING VEHICLES 5/24					1		X															
<b>SIGN SUMMARY SHEET</b>							SHEET TOTALS		43.75	0.00	0	0	0	8	0	0	8	108.00 <del>120.0</del>	0	0.0	0.0	0.0	0.0	PROJECT NAME: <b>STOWE - BERKSHIRE</b> PROJECT NUMBER: <b>STPG SIGN (49)</b>					
VERMONT AGENCY OF TRANSPORTATION							SF	SF	EA	EA	EA	EA	EA	EA	EA	EA	EA	EA	EA	EA	EA	EA	EA	EA	EA	EA	EA		
TOWN DIRECTIONAL TOTALS							611.0	0.0	29	13	10	140	0	0	110	1650.0	0	0.0	0.0	0.0	0.0	FILE NAME: <b>03 CAMBRIDGE VT-108 NB TS</b> PLOT DATE: <b>4/15/2015</b> PROJECT MANAGER: <b>D. BRYANT</b> DRAWN BY: <b>J. BLANCHARD</b> DESIGNED BY: <b>J. BLANCHARD</b> CHECKED: <b>K. KERN</b> CAMBRIDGE NB SHEET 5 SHEET <b>49</b> OF <b>131</b>							