


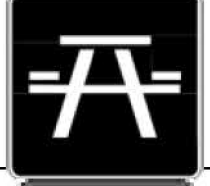


DIRECTION	MILEPOINT	LOCATION CODE (SHEET 2)	SIGN CODE	WIDTH (IN)	HEIGHT (IN)	SHEETING REMARKS	SIGN LEGEND	NEW SIGNS		EXISTING SIGNS			EXIST POST		NUMBER OF NEW POSTS	SQUARE STEEL (IN)			TUBULAR STEEL Ø (IN)				SIGN FRAME REQUIRED	REMARKS	SIGN DETAIL LOCATION				
								"A"	"B"	RETAIN	SALVAGE FROM	SALVAGE TO	REMOVE	RETAIN		REMOVE	1.75	2.00	2.50	FOUNDATION	3.00	3.50			4.00	5.00	SHSM	PROJECT SHEET #	STANDARD SHEET #
																	(LB / FT)				(LB / FT)								
CAMBRIDGE VT-108 NB							FY-FLUORESCENT YELLOW FYG-FLUORESCENT YELLOW GREEN															"SHSM"-STANDARD HIGHWAY SIGNS AND MARKINGS							
NB	5.440	A	D5-5a	24	24		PICNIC TABLE SYMBOL 5/26					1		X															
		A	VD9-2A	24	6		RIGHT ----> SERVICE 5/26					1																	
		A	D5-5a	24	24	WHT/ BLU	 5/27	4.00							1		13.50	X							X				
		A	M6-1R	21	15	WHT/ BLU	 5/27	2.19																X					
NB	5.808	A	VD-062B	72	16		BUSINESS SIGN 5/27			1			X																
NB	5.859	C/D	D3-1	UNK.	UNK.		VT RTE 108 S 5/27					1		X															
		A/B	D3-1	UNK.	UNK.		EDWARDS RD 5/27					1																	
NB	5.860	C	VR-017	24	30		LLL 24,000 LBS 5/27					1		X															
		C	VR-017	24	30		 5/27	5.00							1		13.50	X								EDWARDS RD (TH-78); INSTALL ADJACENT TO NEW LOCATION FOR NARROW BRIDGE SIGN	9		
NB	5.860	C	W5-3	UNK.	UNK.		NARROW BRIDGE 5/27			1		1		X															
		C	UNK.	UNK.	UNK.		SLOW 5/27					1																	
NB	5.860	C	W5-3	UNK.	UNK.		NARROW BRIDGE 5/27					1			1		13.25	X											
							EDWARDS RD (TH-78); INSTALL SAVAGED SIGN ON NEW POST AT END OF CONCRETE BARRIER																						
NB	5.866	D	R1-1	30	30		STOP 5/27					1		X															
		C	VD-700	6	10		MILE MARKER 5/27			1	1	1																	
		D	R1-1	30	30		TRIM 7/6  5/27	6.25							1		14.00	X							X				
SIGN SUMMARY SHEET							SHEET TOTALS	17.44	0.00	1	2	2	9	0	0	4		54.25		0	0.0	0.0	0.0	0.0	PROJECT NAME: STOWE - BERKSHIRE PROJECT NUMBER: STPG SIGN (49)				
VERMONT AGENCY OF TRANSPORTATION							TOWN DIRECTIONAL TOTALS	611.0	0.0	29	13	10	140	0	0	110		1650.0		0		0.0			FILE NAME: 03 CAMBRIDGE VT-108 NB TS PLOT DATE: 4/15/2015 PROJECT MANAGER: D. BRYANT DRAWN BY: J. BLANCHARD DESIGNED BY: J. BLANCHARD CHECKED: K. KERN CAMBRIDGE NB SHEET 9 SHEET 53 OF 131				