
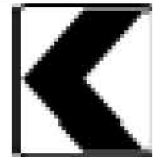








DIRECTION	MILEPOINT	LOCATION CODE (SHEET 2)	SIGN CODE	WIDTH (IN)	HEIGHT (IN)	SHEETING REMARKS	SIGN LEGEND	NEW SIGNS		EXISTING SIGNS			EXIST POST		NUMBER OF NEW POSTS	SQUARE STEEL (IN)			TUBULAR STEEL Ø (IN)				SIGN FRAME REQUIRED	REMARKS	SIGN DETAIL LOCATION				
								"A"	"B"	RETAIN	SALVAGE FROM	SALVAGE TO	REMOVE	RETAIN		REMOVE	1.75	2.00	2.50	FOUNDATION	3.00	3.50			4.00	5.00	SHSM	PROJECT SHEET #	STANDARD SHEET #
																	(LB / FT)				(LB / FT)								
CAMBRIDGE VT-108 NB							FY-FLUORESCENT YELLOW FYG-FLUORESCENT YELLOW GREEN															"SHSM"-STANDARD HIGHWAY SIGNS AND MARKINGS							
NB	8.300	A	VW-054L	30	30		HIDDEN DRIVE LEFT 6/6																						
		A	VW-133L	30	30		 6/6	6.25																10					
NB	8.342	A	R2-1	24	30		SPEED LIMIT 35 6/6																						
NB	8.347	A	W1-8L	18	24		TRIM 7/7  6/7	3.00															INSTALL 26 FT NORTH OF EXISTING SPEED LIMIT 35	X					
		B	W1-8R	18	24		 6/7	3.00																X					
NB	8.356	A	W1-6	48	24		<=== LEFT LARGE ARROW 6/7																						
NB	8.363	A	W1-8L	18	24		 6/7	3.00															INSTALL 37 FT NORTH OF FIRST EXISTING LARGE LEFT ARROW AT M.P. 8.356	X					
		B	W1-8R	18	24		 6/7	3.00																X					
NB	8.364	A	W1-6	48	24		<=== LEFT LARGE ARROW 6/7																						
NB	8.364	B	W1-6	48	24		RIGHT ===> LARGE ARROW 6/7																						
NB	8.373	A	W1-6	48	24		<=== LEFT LARGE ARROW 6/7																						
NB	8.373	B	W1-6	48	24		RIGHT ===> LARGE ARROW 6/7																						
NB	8.376	A	W1-8L	18	24		 6/7	3.00															INSTALL AT END OF GUARDRAIL	X					
		B	W1-8R	18	24		 6/7	3.00																X					
NB	8.392	A	W1-8L	18	24		TRIM 7/7  6/7	3.00															INSTALL 85 FT NORTH OF PREVIOUS CHEVRON AT M.P. 8.376 (NORTH OF DRIVEWAY)	X					
SIGN SUMMARY SHEET							SHEET TOTALS	27.25	0.00	0	0	0	9 7	0	0	5	66.50 75.0	0	0.0	0.0	0.0	0.0	PROJECT NAME: STOWE - BERKSHIRE PROJECT NUMBER: STPG SIGN (49)						
VERMONT AGENCY OF TRANSPORTATION							TOWN DIRECTIONAL TOTALS	611.0	0.0	29	13	10	140	0	0	110	1650.0	0		0.0			FILE NAME: 03 CAMBRIDGE VT-108 NB TS PLOT DATE: 4/15/2015 PROJECT MANAGER: D. BRYANT DRAWN BY: J. BLANCHARD DESIGNED BY: J. BLANCHARD CHECKED: K. KERN CAMBRIDGE NB SHEET 13 SHEET 67 OF 131						