
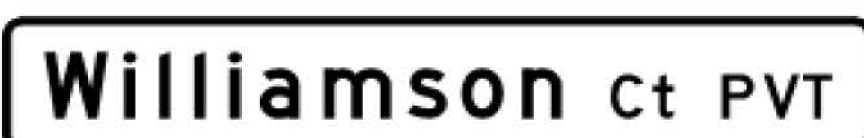







DIRECTION	MILEPOINT	LOCATION CODE (SHEET 2)	SIGN CODE	WIDTH (IN)	HEIGHT (IN)	SHEETING REMARKS	SIGN LEGEND	NEW SIGNS		EXISTING SIGNS			EXIST POST		NUMBER OF NEW POSTS	SQUARE STEEL (IN)			TUBULAR STEEL Ø (IN)				SIGN FRAME REQUIRED	REMARKS	SIGN DETAIL LOCATION				
								"A"	"B"	RETAIN	SALVAGE FROM	SALVAGE TO	REMOVE	RETAIN		REMOVE	1.75	2.00	2.50	FOUNDATION	3.00	3.50			4.00	5.00	SHSM	PROJECT SHEET #	STANDARD SHEET #
																	(LB / FT)				(LB / FT)								
<b>CAMBRIDGE VT-108 NB</b>							FY-FLUORESCENT YELLOW FYG-FLUORESCENT YELLOW GREEN															"SHSM"-STANDARD HIGHWAY SIGNS AND MARKINGS							
		A	W11-2	30	30	FYG		6/6	6.25						1	15.25 X								X					
NB	8.655	A/B	D3-1	UNK.	UNK.		WILLIAMSON CT	6/7					1		X														
		A/B	D3-1	70	12			6/7	5.83						2	24.75 X									12				
NB	8.660	A	W16-2aP	24	18		400 FEET	6/7					1		X														
		A	VW-054L	30	30		HIDDEN DRIVE LEFT	6/7					1																
		B	UNK.	UNK.	UNK.		911 EMERGENCY CALL BOX AHEAD AT RESCUE STATION	6/7					1																
		A	VW-133L	30	30		TRIM 7/7 	6/7	6.25						1	16.50 X									10				
		A	W16-2aP	24	12		TRIM 7/7 	6/7	2.00															X					
NB	8.668	A	D1-1A	72	10		MORRISVILLE 17 --->						1		X														
		A	D1-1A	72	10		ENOSBURG 20 --->						1																
		A	D1-1A	72	10		ST ALBANS 25 ^UP						1																
		B	VR-493H	48	60		VT 108 OPEN TO SKI AREA CLOSED THRU SMUG NOTCH VT 108 NOT A THRU ROUTE FOR TRACTOR TRAILERS						1																
		A	VD1-1a	72	12		TRIM 7/7 	8/24	6.00						2	30.25 X									7				
		A	VD1-1a	72	12			8/24	6.00																7				
		A	VD1-1a	72	12			8/24	6.00																7				
<b>SIGN SUMMARY SHEET</b>							SHEET TOTALS	38.33	0.00	0	0	0	8	0	0	6	86.75 <del>90.0</del>	0	0.0	0.0	0.0	0.0	PROJECT NAME: STOWE - BERKSHIRE PROJECT NUMBER: STPG SIGN (49)						
VERMONT AGENCY OF TRANSPORTATION							TOWN DIRECTIONAL TOTALS	611.0	0.0	29	13	10	140	0	0	110	1650.0	0		0.0			FILE NAME: 03 CAMBRIDGE VT-108 NB TS PROJECT MANAGER: D. BRYANT DESIGNED BY: J. BLANCHARD CAMBRIDGE NB SHEET 15	PLOT DATE: 7/29/2015 DRAWN BY: J. BLANCHARD CHECKED: K. KERN SHEET 59 OF 131					