

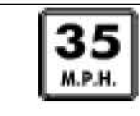

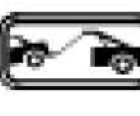


DIRECTION	MILEPOINT	LOCATION CODE (SHEET 2)	SIGN CODE	WIDTH (IN)	HEIGHT (IN)	SHEETING REMARKS	SIGN LEGEND	NEW SIGNS		EXISTING SIGNS			EXIST POST		NUMBER OF NEW POSTS	SQUARE STEEL (IN)			TUBULAR STEEL Ø (IN)				SIGN FRAME REQUIRED	REMARKS	SIGN DETAIL LOCATION				
								"A"	"B"	RETAIN	SALVAGE FROM	SALVAGE TO	REMOVE	RETAIN		REMOVE	1.75	2.00	2.50	FOUNDATION	3.00	3.50			4.00	5.00	SHSM	PROJECT SHEET #	STANDARD SHEET #
																	(LB / FT)				(LB / FT)								
CAMBRIDGE VT-108 SB							FY-FLUORESCENT YELLOW FYG-FLUORESCENT YELLOW GREEN															"SHSM"-STANDARD HIGHWAY SIGNS AND MARKINGS							
		F	VR-020	24	30		TRIM  5/13	5.00						1	15.00 X											9			
SB	2.429	E	VW-060	30	30		HIDDEN DRIVES TRIM 5/13						1																
SB	2.354	F	W1-10	36	36		MODIFIED LEFT CURVE						1																
		F	W13-1P	24	18		35 MPH						1																
		F	W1-10ML	36	36			9.00						2	30.75 X										X				
		F	W13-1P	18	18			2.25																	X				
SB	2.315	F	VW-400	48	48		SMUGGLERS NOTCH NOT RECOMMENDED FOR TRUCKS BUSES OR RVS 8/24	16.00		1				X	X	2	31.50 X												
SB	2.278	F	W16-18P	48	12		NOTICE 5/13			1				X															
		F	VR-472	48	48		TRACTOR TRAILERS PROHIBITED 5/13			1																			
		F	VR5-2M	48	48		NO TRACTOR TRAILER SYMBOL 5/13			1																			
		F	VD-700	6	10		MILE MARKER 5/13			1																			
SB	2.274	F	R8-3	24	24		NO PARKING SYMBOL 5/13						1																
		F	R7-201P	12	6		TOW-AWAY SYMBOL 5/13						1																
		G	R8-3	24	24			4.00						1	13.50 X										X				
		G	R7-201P	12	6	BLK/ WHT	 5/13	0.50																	X				
SIGN SUMMARY SHEET							SHEET TOTALS	36.75 20.75	0.00	5	0	0	5	0	0	6 4	90.75 60.0	0	0.0	0.0	0.0	0.0							
VERMONT AGENCY OF TRANSPORTATION							TOWN DIRECTIONAL TOTALS	624.4	0.0	23	7	7	134	0	0	99	1485.0	2			324.0								
																					PROJECT NAME:	STOWE - BERKSHIRE							
																					PROJECT NUMBER:	STPG SIGN (49)							
																					FILE NAME:	04 CAMBRIDGE VT-108 SB TS							
																					PROJECT MANAGER:	D. BRYANT							
																					DESIGNED BY:	J. BLANCHARD							
																					PLOT DATE:	6/25/2015							
																					DRAWN BY:	J. BLANCHARD							
																					CHECKED:	K. KERN							
																					SHEET	81							
																					OF	131							