

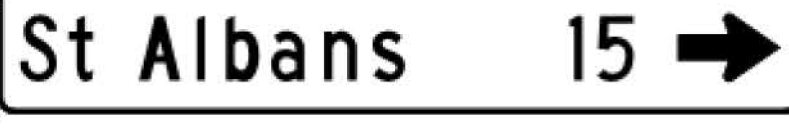





DIRECTION	MILEPOINT	LOCATION CODE (SHEET 2)	SIGN CODE	WIDTH (IN)	HEIGHT (IN)	SHEETING REMARKS	SIGN LEGEND	NEW SIGNS		EXISTING SIGNS			EXIST POST		NUMBER OF NEW POSTS	SQUARE STEEL (IN)			TUBULAR STEEL Ø (IN)				SIGN FRAME REQUIRED	REMARKS	SIGN DETAIL LOCATION				
								"A"	"B"	RETAIN	SALVAGE FROM	SALVAGE TO	REMOVE	RETAIN		REMOVE	1.75	2.00	2.50	FOUNDATION	3.00	3.50			4.00	5.00	SHSM	PROJECT SHEET #	STANDARD SHEET #
																	(LB / FT)				(LB / FT)								
<b>BAKERSFIELD VT-108 SB</b>							FY-FLUORESCENT YELLOW FYG-FLUORESCENT YELLOW GREEN															"SHSM"-STANDARD HIGHWAY SIGNS AND MARKINGS							
SB	3.721	F	D1-1a	72	10		^UP JEFFERSONVILLE 11 8/16					1		X															
		F	D1-1a	72	10		FAIRFIELD 8 ----> 8/16					1																	
		F	D1-1a	72	10		ST ALBANS 15 ----> 8/16					1																	
		F	M3-3	24	12		SOUTH STATE 8/16					1																	
		F	M1-5	30	24		VERMONT 108 8/16					1																	
		F	M6-3	21	15		^UP ARROW STATE 8/16					1																	
		F	M3-4	24	12		WEST STATE 8/16					1																	
		F	M1-5	24	24		VERMONT 36 8/16					1																	
		F	M6-1	21	15		RIGHT ----> STATE 8/16					1																	
		F	VD1-1a	72	12		 8/16	6.00							2			33.00 X							SLIP BASE REQUIRED - SEE SHEET 2	7			
		F	VD1-1a	72	12		 8/16	6.00																		7			
		F	VD1-1a	72	12		 8/16	6.00																		7			
SB	3.691	F	M3-3	24	12	GRN/ WHT	 6/30	2.00							2			30.75 X					2B		INSTALL IN SOUTH CORNER OF VT 36 INTERSECTION, AT LEAST 10 FT FROM STOP SIGN	X			
		F	M1-5	30	24	GRN/ WHT	 6/30	5.00																			E-136B		
		F	M6-3	21	15	GRN/ WHT	 6/30	2.19																					
<b>SIGN SUMMARY SHEET</b>							SHEET TOTALS		27.19	0.00	0	0	0	9	0	0	4	63.75 <del>60.0</del>	0	0.0	0.0	0.0	0.0	PROJECT NAME: <b>STOWE - BERKSHIRE</b> PROJECT NUMBER: <b>STPG SIGN (49)</b>					
VERMONT AGENCY OF TRANSPORTATION							TOWN DIRECTIONAL TOTALS		235.0	0.0	6	11	11	58	0	0	43	645.0	0		0.0			FILE NAME: <b>06 BAKERSFIELD VT-108 SB T</b> PLOT DATE: <b>7/29/2015</b> PROJECT MANAGER: <b>D. BRYANT</b> DRAWN BY: <b>J. BLANCHARD</b> DESIGNED BY: <b>J. BLANCHARD</b> CHECKED: <b>K. KERN</b> BAKERSFIELD SB SHEET 7 SHEET <b>98</b> OF <b>131</b>					