




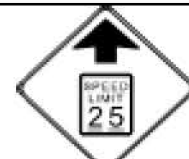


DIRECTION	MILEPOINT	LOCATION CODE (SHEET 2)	SIGN CODE	WIDTH (IN)	HEIGHT (IN)	SHEETING REMARKS	SIGN LEGEND	NEW SIGNS		EXISTING SIGNS			EXIST POST		NUMBER OF NEW POSTS	SQUARE STEEL (IN)			TUBULAR STEEL Ø (IN)				SIGN FRAME REQUIRED	REMARKS	SIGN DETAIL LOCATION				
								"A"	"B"	RETAIN	SALVAGE FROM	SALVAGE TO	REMOVE	RETAIN		REMOVE	1.75	2.00	2.50	FOUNDATION	3.00	3.50			4.00	5.00	SHSM	PROJECT SHEET #	STANDARD SHEET #
																	(LB / FT)				(LB / FT)								
ENOSBURG VT-108 NB							FY-FLUORESCENT YELLOW FYG-FLUORESCENT YELLOW GREEN															"SHSM"-STANDARD HIGHWAY SIGNS AND MARKINGS							
NB	3.542	A	S3-1	30	30		SCHOOL BUS STOP AHEAD																						
		A	S3-1	36	36	FYG		4/29	9.00															REQUIRES VEGETATION CLEARING	X				
NB	3.817	A	VW-054L	30	30		HIDDEN DRIVE LEFT																						
		A	S3-1	30	30		SCHOOL BUS STOP AHEAD																						
		A	VW-133L	30	30			4/29	6.25																	10			
NB	4.016	A	W3-5	36	36		SPEED REDUCTION SPEED LIMIT 40																						
NB	4.056	A	W3-5	36	36		TRIM 	5/2	9.00															INSTALL 210 FT NORTH OF EXISTING	X				
NB	4.153	A	R2-1	24	30		SPEED LIMIT 40																						
		A	VD-700	6	10		MILE MARKER				1	1	1											SALVAGE AND MOUNT ON NEW POST BELOW SPEED LIMIT SIGN					
		A	R2-1	30	36			5/2	7.50																	X			
NB	4.371	A	R2-1	24	30		SPEED LIMIT 40																						
NB	4.400	A	W11-7	30	30		EQUESTRIAN SYMBOL																						
		A	W11-7	30	30			4/29	6.25																	X			
NB	4.462	A	W3-5	36	36		SPEED REDUCTION SPEED LIMIT 25																						
		A	W3-5	36	36			5/2	9.00																	X			
SIGN SUMMARY SHEET							SHEET TOTALS	47.00	0.00	0	1	1	9	0	0	9	128.50	0	0.0	0.0	0.0	0.0	PROJECT NAME: STOWE - BERKSHIRE PROJECT NUMBER: STPG SIGN (49)						
VERMONT AGENCY OF TRANSPORTATION							TOWN DIRECTIONAL TOTALS	198.6	0.0	2	5	5	42	0	0	38	570.0	0		0.0				FILE NAME: 07 ENOSBURG VT-108 NB TSS PROJECT MANAGER: D. BRYANT DESIGNED BY: J. BLANCHARD ENOSBURG NB SHEET 5	PLOT DATE: 4/15/2015 DRAWN BY: J. BLANCHARD CHECKED: K. KERN SHEET 104 OF 131				