





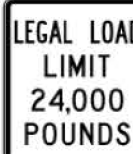


DIRECTION	MILEPOINT	LOCATION CODE (SHEET 2)	SIGN CODE	WIDTH (IN)	HEIGHT (IN)	SHEETING REMARKS	SIGN LEGEND	NEW SIGNS		EXISTING SIGNS			EXIST POST		NUMBER OF NEW POSTS	SQUARE STEEL (IN)			TUBULAR STEEL Ø (IN)				SIGN FRAME REQUIRED	REMARKS	SIGN DETAIL LOCATION					
								"A"	"B"	RETAIN	SALVAGE FROM	SALVAGE TO	REMOVE	RETAIN		REMOVE	1.75	2.00	2.50	FOUNDATION	3.00	3.50			4.00	5.00	SHSM	PROJECT SHEET #	STANDARD SHEET #	
																	(LB / FT)				(LB / FT)									
ENOSBURG VT-108 SB							FY-FLUORESCENT YELLOW FYG-FLUORESCENT YELLOW GREEN															"SHSM"-STANDARD HIGHWAY SIGNS AND MARKINGS								
SB	2.382	G/H	D3-1	UNK.	UNK.		W ENOSBURG RD					1		X																
		E/F	D3-1	UNK.	UNK.		TYLER BRANCH RD					1																		
		H	R1-1	30	30		STOP					1																		
		G	VD-700	6	10					1	1	1																		
		H	R1-1	30	30			4/28	6.25						1		14.25	X									X			
SB	2.382	E/F	D3-1	66	12			5/3	5.50						2		22.75	X											14	
SB	2.372	F	M3-3	24	14		SOUTH	4/28				1		X																
		F	M1-5A	30	24		VERMONT 108	4/28				1																		
		F	M3-3	24	14	GRN/WHT		4/28	2.33						1		13.50	X									X			
		F	M1-5	30	24	GRN/WHT		4/28	5.00																					E-136B
SB	2.346	F	R2-1	24	30		SPEED LIMIT 40	4/28				1		X																
		F	R2-1	24	30			4/28	5.00						1		13.50	X									X			
SB	2.207	F	R2-1	24	30		SPEED LIMIT 50	4/28				2		X																
		F	R2-1	24	30			4/28	5.00						1		13.50	X									X			
SB	1.618	G	VR-017	24	30			4/28	5.00						1		14.25	X											9	
SIGN SUMMARY SHEET							SHEET TOTALS		34.08	0.00	0	1	1	9	0	0	7	91.75		0	0.0	0.0	0.0	0.0	PROJECT NAME: STOWE - BERKSHIRE					
									SF	SF	EA	EA	EA	EA	EA	EA	EA	FT		EA	LB	LB	LB	LB	PROJECT NUMBER: STPG SIGN (49)					
VERMONT AGENCY OF TRANSPORTATION							TOWN DIRECTIONAL TOTALS		153.5	0.0	2	2	2	39	0	0	30	450.0		0		0.0			FILE NAME: 08 ENOSBURG VT-108 SB TSS PLOT DATE: 4/15/2015					
																								PROJECT MANAGER: D. BRYANT DRAWN BY: J. BLANCHARD						
																								DESIGNED BY: J. BLANCHARD CHECKED: K. KERN						
																								ENOSBURG SB SHEET 3 SHEET 108 OF 131						