
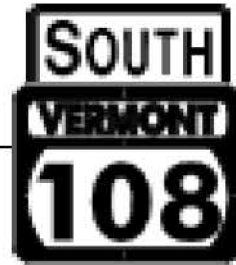







DIRECTION	MILEPOINT	LOCATION CODE (SHEET 2)	SIGN CODE	WIDTH (IN)	HEIGHT (IN)	SHEETING REMARKS	SIGN LEGEND	NEW SIGNS		EXISTING SIGNS			EXIST POST		NUMBER OF NEW POSTS	SQUARE STEEL (IN)			TUBULAR STEEL Ø (IN)				SIGN FRAME REQUIRED	REMARKS	SIGN DETAIL LOCATION						
								"A"	"B"	RETAIN	SALVAGE FROM	SALVAGE TO	REMOVE	RETAIN		REMOVE	1.75	2.00	2.50	FOUNDATION	3.00	3.50			4.00	5.00	SHSM	PROJECT SHEET #	STANDARD SHEET #		
																	(LB / FT)				(LB / FT)										
BERKSHIRE VT-108 SB							FY-FLUORESCENT YELLOW FYG-FLUORESCENT YELLOW GREEN															"SHSM"-STANDARD HIGHWAY SIGNS AND MARKINGS									
SB	6.818	E	VR-038	24	18		STATE HIGHWAY ENDS 4/25					1		X																	
		F	VR-041	24	24		THROUGH WAY BEGINS HERE 4/25					1																			
		F	M3-3	24	12		SOUTH 4/25					1																			
		F	VM1-5A	24	24		ROUTE 108 4/25					1																			
		F	VR-039	24	18		 5/3	3.00							1											9					
SB	6.780	F	M3-3	24	12	GRN/WHT	 TRIM 4/25	2.00							1													INSTALL 200 FT SOUTH OF EXISTING ROUTE MARKER ASSEMBLY	X		
		F	M1-5	30	24	GRN/WHT	 4/25	5.00																						E-136B	
SB	6.740	F	VD-421A	60	48		WELCOME TO VERMONT THE GREEN MOUNTAIN STATE 5/3					1		X																	
		F	VD-421	30	24		 TRIM 5/3	5.00							1												6				
SB	6.702	F	VR-114F	48	60		STATE OF VT SL VITESSE MAXIMUM 50 UNLESS OTHERWISE POSTED 5/3					1		X																	
		F	W16-18P	24	12		 TRIM 5/3	2.00							1																
		F	R2-1	24	30		 5/3	5.00																							
		F	R2-5P	24	18		 5/3	3.00																							
SB	6.617	F	VR-128B	UNK.	UNK.		BUCKLE UP IT'S THE LAW/CENTURE DE SECURITE OBLIGATOIRE 5/3					1		X																	
		F	VD-700	6	10		MILE MARKER 5/3					1																			SALVAGE AND MOUNT ON NEW POST BELOW SEAT BELT SIGN
SIGN SUMMARY SHEET							SHEET TOTALS	25.00	0.00	0	1	1	8	0	0	4	57.50	0	0.0	0.0	0.0	0.0	PROJECT NAME: STOWE - BERKSHIRE PROJECT NUMBER: STPG SIGN (49)								
VERMONT AGENCY OF TRANSPORTATION							TOWN DIRECTIONAL TOTALS	328.8	0.0	6	4	4	66	0	0	56	840.0	0	0.0				FILE NAME: 10 BERKSHIRE VT-108 SB TSS PLOT DATE: 6/25/2015 PROJECT MANAGER: D. BRYANT DRAWN BY: J. BLANCHARD DESIGNED BY: J. BLANCHARD CHECKED: K. KERN BERKSHIRE SB SHEET 1 SHEET 121 OF 131								