

# STATE OF VERMONT AGENCY OF TRANSPORTATION






## PROPOSED IMPROVEMENT TOWNS OF CALAIS, WOODBURY, HARDWICK, AND GREENSBORO COUNTIES OF WASHINGTON, CALEDONIA AND ORLEANS VT ROUTE 14 (MINOR ARTERIAL; MAJOR COLLECTOR)

CALAIS TO GREENSBORO SIGN REPLACEMENT - 22.524 MILES:  
CALAIS (VT-14) MP 0.000-6.902, WOODBURY (VT-14) MP 0.000-7.691  
HARDWICK (VT-14) MP 0.000-6.028, GREENSBORO (VT-14) MP 0.000-1.903

LENGTH OF ROADWAY = 22.524 MI  
LENGTH OF PROJECT = 21.524 MI

WORK TO BE PERFORMED INCLUDES THE REMOVAL OF EXISTING SIGNS AND POSTS  
AND THE INSTALLATION OF NEW SIGNS AND POSTS AND OTHER RELATED HIGHWAY ITEMS.

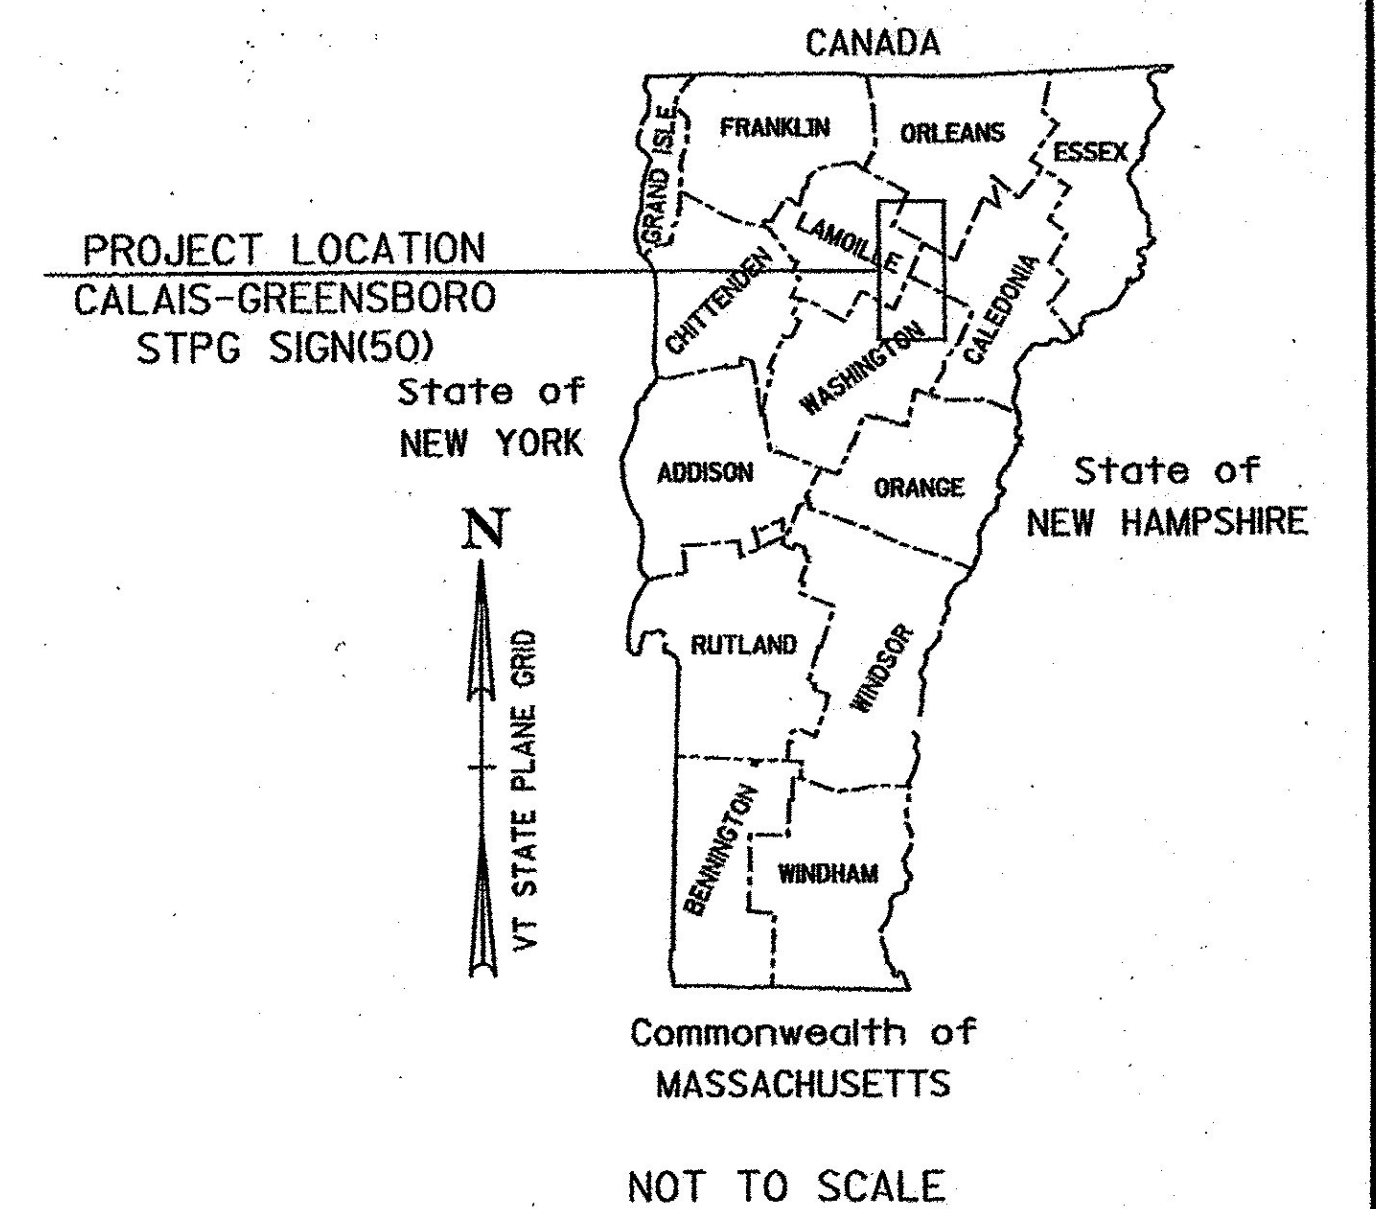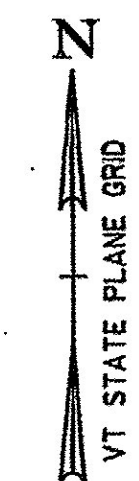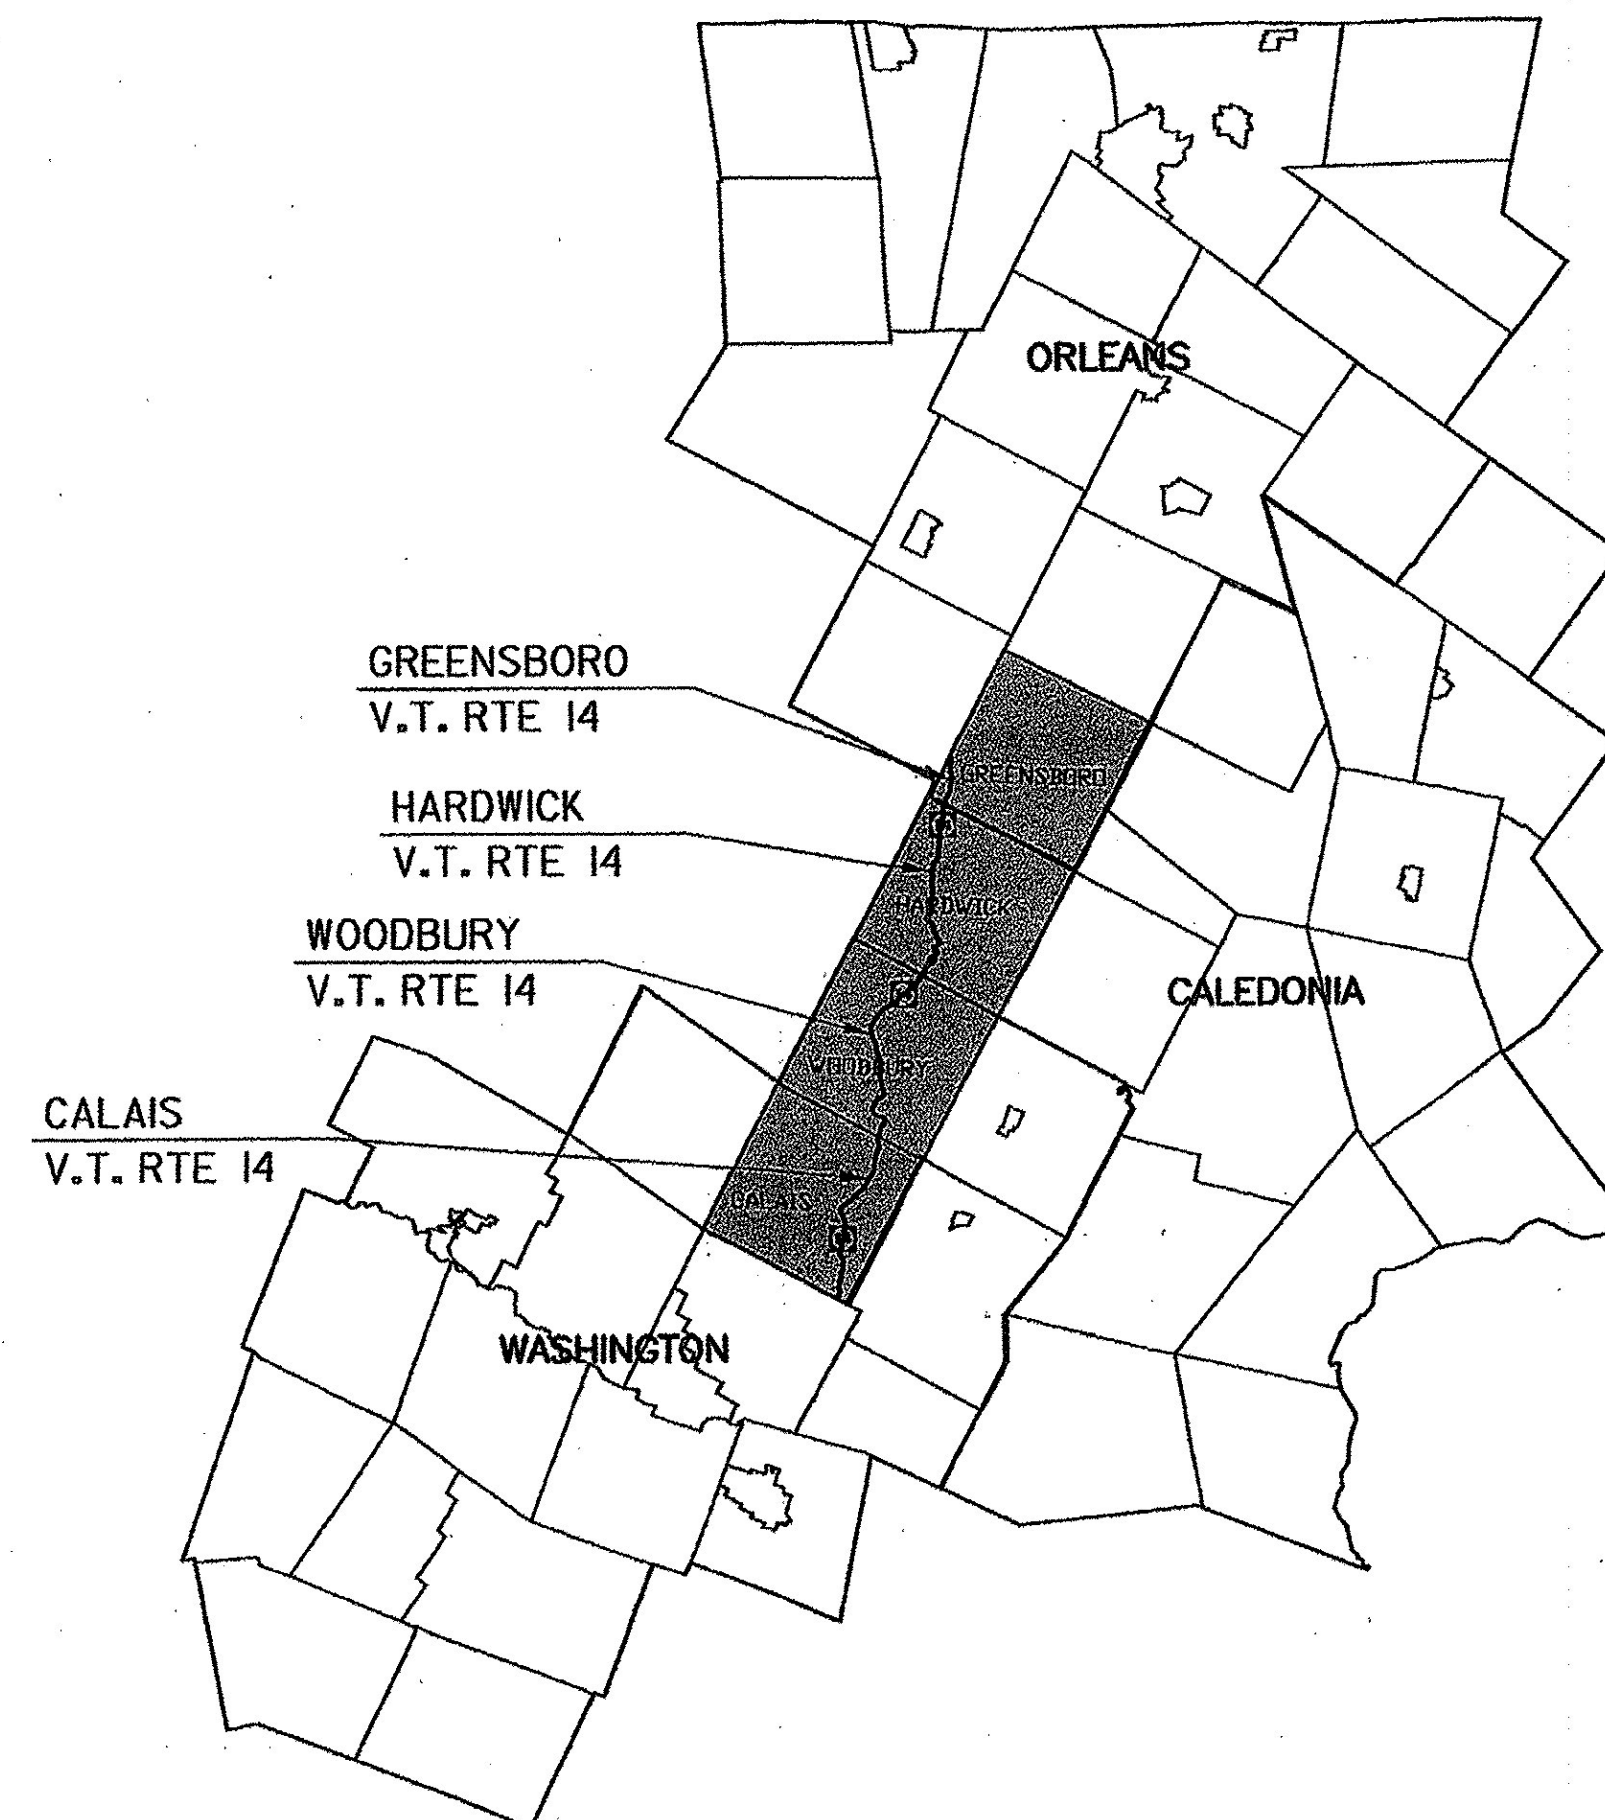

RECORD PLANS	
CONTRACTOR:	F. R. LAFAYETTE, INC. - ESSEX JUNCTION, VT
RESIDENT ENGINEER:	WILLIAM CROWTHER
CONSTRUCTION BEGAN:	JULY 15, 2016
CONSTRUCTION COMPLETE:	OCTOBER 26, 2016
RECORD PLANS BY:	WILLIAM CROWTHER & JESSE IVES
I HEREBY CERTIFY THAT ALL THE CONSTRUCTION REQUIRED BY THIS SET OF DRAWINGS HAS BEEN ACCOMPLISHED AS INDICATED HEREIN.	
BY	RESIDENT ENGINEER
DATE	11/7/17
NOTE: Any further information concerning final quantities, amounts or other details relative to this project may be found by contacting Vtrans Records Management.	

CONSTRUCTION IS TO BE CARRIED ON IN ACCORDANCE WITH THESE PLANS AND THE STANDARD SPECIFICATIONS FOR CONSTRUCTION DATED 2011, AS APPROVED BY THE FEDERAL HIGHWAY ADMINISTRATION ON JULY 20, 2011 FOR USE ON THIS PROJECT, INCLUDING ALL SUBSEQUENT REVISIONS AND SUCH REVISED SPECIFICATIONS AND SPECIAL PROVISIONS AS ARE INCORPORATED IN THESE PLANS.

QUALITY ASSURANCE PROGRAM : LEVEL 3	
SURVEYED BY :	N/A
SURVEYED DATE :	N/A
DATUM	
VERTICAL	N/A
HORIZONTAL	N/A

	NOT TO SCALE
	DIRECTOR OF PROJECT DELIVERY APPROVED  DATE 5/26/2015 PROJECT MANAGER : PATTI COBURN, P.E.
	PROJECT NAME : CALAIS-GREENSBORO PROJECT NUMBER : STPG SIGN (50) SHEET 1 OF 66 SHEETS