





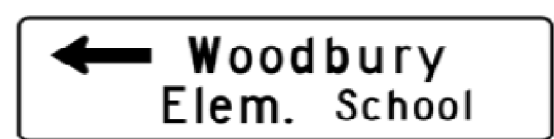


DIRECTION	MILEPOINT	LOCATION CODE (SHEET 2)	SIGN CODE	WIDTH (IN)	HEIGHT (IN)	SHEETING REMARKS	SIGN LEGEND	NEW SIGNS		EXISTING SIGNS			EXIST POST		NUMBER OF NEW POSTS	SQUARE STEEL (IN)			TUBULAR STEEL Ø (IN)				SIGN FRAME REQUIRED	REMARKS	SIGN DETAIL LOCATION				
								"A"	"B"	RETAIN	SALVAGE FROM	SALVAGE TO	REMOVE	RETAIN		REMOVE	1.75	2.00	2.50	FOUNDATION	3.00	3.50			4.00	5.00	SHSM	PROJECT SHEET #	STANDARD SHEET #
																	(LB / FT)				(LB / FT)								
WOODBURY VT-14 NB							FY-FLUORESCENT YELLOW FYG-FLUORESCENT YELLOW GREEN															"SHSM"-STANDARD HIGHWAY SIGNS AND MARKINGS							
NB	3.397	A/B	D3-1	42	12			4.33							1									BLAKE HILL RD (NORTH) (TH-27); INSTALL 50 FT NORTH OF VILLAGE SIGN		8			
NB	3.401	C	R2-1	24	30		SPEED LIMIT 35			1																			
NB	3.404	D	R1-1	30	30		STOP																						
NB	3.409	D	R1-1	30	30			6.25							1										BLAKE HILL RD (NORTH) (TH-27); INSTALL 25 FT CLOSER TO VT-14 FROM EXISTING	X			
NB	3.446	A	R2-1	30	36		SPEED LIMIT 35																						
		A	R2-1	30	36			7.50							1												X		
NB	3.529	A	W11-8	30	30		FIRE ENGINE SYMBOL																						
		A	W11-8	30	30			6.25							1												X		
NB	3.559	A	S1-1	36	36		SCHOOL SYMBOL																						
		A	W16-9P	30	18		AHEAD WARNING																						
		A	VD-700	6	8		MILE MARKER			1	1	1													SALVAGE AND MOUNT ON NEW POST BELOW SCHOOL SIGN				
		A	S1-1	36	36	FYG		9.00							1											REQUIRES VEGETATION CLEARING	X		
		A	W16-9P	30	18	FYG		3.75																			X		
NB	3.612	A	D1-1	72	20		<--- WOODBURY ELEM SCHOOL																						
		A	VD1-2	72	20			10.00							2													5	
SIGN SUMMARY SHEET							SHEET TOTALS	47.08	0.00	1	1	1	7	0	0	7	105.0	0	0.0	0.0	0.0	0.0	0.0	0.0	0.0	PROJECT NAME: CALAIS - GREENSBORO PROJECT NUMBER: STPG SIGN (50)			
VERMONT AGENCY OF TRANSPORTATION							TOWN DIRECTIONAL TOTALS	286.5	0.0	15	23	22	78	0	0	56	840.0	0		0.0					FILE NAME: 03 WOODBURY VT-14 NB TSS. PLOT DATE: 5/19/2015 PROJECT MANAGER: D. BRYANT DRAWN BY: J. BLANCHARD DESIGNED BY: J. BLANCHARD CHECKED BY: K. KERN WOODBURY NB SHEET 6 SHEET 29 OF 66				

7/27/16

7/29/16