


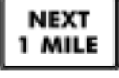



DIRECTION	MILEPOINT	LOCATION CODE (SHEET 2)	SIGN CODE	WIDTH (IN)	HEIGHT (IN)	SHEETING REMARKS	SIGN LEGEND	NEW SIGNS		EXISTING SIGNS			EXIST POST		NUMBER OF NEW POSTS	SQUARE STEEL (IN)			TUBULAR STEEL Ø (IN)				SIGN FRAME REQUIRED	REMARKS	SIGN DETAIL LOCATION				
								"A"	"B"	RETAIN	SALVAGE FROM	SALVAGE TO	REMOVE	RETAIN		REMOVE	1.75	2.00	2.50	FOUNDATION	3.00	3.50			4.00	5.00	SHSM	PROJECT SHEET #	STANDARD SHEET #
																	(LB / FT)				(LB / FT)								
WOODBURY VT-14 SB							FY-FLUORESCENT YELLOW FYG-FLUORESCENT YELLOW GREEN															"SHSM"-STANDARD HIGHWAY SIGNS AND MARKINGS							
SB	1.238	F	VW-054L	30	30		HIDDEN DRIVE LEFT																						
SB	1.168	F	VW-054L	30	30			6.25																		7			
SB	1.159	E/F	D3-1	UNK.	UNK.		HERRICKS COVE RD PVT																						
		E/F	D3-1	72	12			6.00																		8			
SB	1.133	F	W3-5	36	36		SPEED REDUCTION SPEED LIMIT 40			1																			
SB	1.067	F	W11-2	30	30	FYG		6.25																			X		
		F	W7-3aP	24	18	FYG		3.00																			X		
SB	1.045	F	VD-062AS	72	16		BUSINESS SIGN			1																			
SB	1.030	F	R2-1	30	36		SPEED LIMIT 40			1																			
SB	0.864	F	W11-2	30	30		PEDESTRIAN SYMBOL																						
		F	W7-3aP	24	18		NEXT 1 MILE																						
SB	0.634	F	W1-4R	30	30		RIGHT REVERSE CURVE			1																			
SB	0.497	E/F	D3-1	60	12			5.00 5.50																		8			
SB	0.489	E/F	D3-1	UNK.	UNK.		CASS COVE RD PVT																						
SB	0.478	F	R2-1	24	30		SPEED LIMIT 40			1																			
SIGN SUMMARY SHEET							SHEET TOTALS	27.00	0.00	5	0	0	5	0	0	6	90.0	0	0.0	0.0	0.0	0.0	PROJECT NAME: CALAIS - GREENSBORO PROJECT NUMBER: STPG SIGN (50)						
VERMONT AGENCY OF TRANSPORTATION							TOWN DIRECTIONAL TOTALS	291.8	0.0	13	13	13	69	0	0	62	930.0	0		0.0	FILE NAME: 04 WOODBURY VT-14 SB TSS. PLOT DATE: 5/19/2015 PROJECT MANAGER: D. BRYANT DRAWN BY: J. BLANCHARD DESIGNED BY: J. BLANCHARD CHECKED BY: K. KERN WOODBURY SB SHEET 8 SHEET 41 OF 66								

7/25/16

7/25/16