


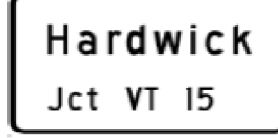



DIRECTION	MILEPOINT	LOCATION CODE (SHEET 2)	SIGN CODE	WIDTH (IN)	HEIGHT (IN)	SHEETING REMARKS	SIGN LEGEND	NEW SIGNS		EXISTING SIGNS			EXIST POST		NUMBER OF NEW POSTS	SQUARE STEEL (IN)			TUBULAR STEEL Ø (IN)				SIGN FRAME REQUIRED	REMARKS	SIGN DETAIL LOCATION				
								"A"	"B"	RETAIN	SALVAGE FROM	SALVAGE TO	REMOVE	RETAIN		REMOVE	1.75	2.00	2.50	FOUNDATION	3.00	3.50			4.00	5.00	SHSM	PROJECT SHEET #	STANDARD SHEET #
																	(LB / FT)				(LB / FT)								
HARDWICK VT-14 NB							FY-FLUORESCENT YELLOW FYG-FLUORESCENT YELLOW GREEN															"SHSM"-STANDARD HIGHWAY SIGNS AND MARKINGS							
		D	R1-1	30	30			6.25															CAREY RD (TH-48); INSTALL 10 FT CLOSER TO VT-14	X					
	NB	0.688	A/B	D3-1	UNK.	UNK.	CAREY RD						1																
	NB	0.772	A/B	D3-1	UNK.	UNK.	HARDWICK ELECTRIC DR 239			1																			
	NB	0.773	A	R2-1	24	30	SPEED LIMIT 40						1																
			A	VD-700	6	8	MILEMARKER			1	1	1											SALVAGE AND MOUNT ON NEW POST BELOW SPEED LIMIT SIGN						
			A	R2-1	24	30		5.00						1	12'-0"	X								X					
	NB	0.869	A	W3-5	36	36	SPEED REDUCTION SPEED LIMIT 30						+																
	NB	0.896	A	W3-5	36	36	 DISTRICT REPLACED NO NEED FOR SIGNAGE OR POST	9.00						2	X								INSTALL 143 FT NORTH OF EXISTING	X					
	NB	0.932	A	VD-018	30	18		3.75						1	12'-3"	X							INSTALL 190 FT NORTH OF NEW SPEED REDUCTION WARNING		5				
	NB	0.984	C/D	D3-1	UNK.	UNK.	BENWAY DR PVT						1																
	NB	0.991	A/B	D3-1	50	12		4.17 4.67						2	11'-0"	X 11'-0"							BENWAY DR (PVT); INSTALL AT CORNER OF FENCE		9				
	NB	0.994	A	VR-038	24	18	STATE HIGHWAY ENDS						+																
			A	R2-1	24	30	SPEED LIMIT 30						+																
			A	VD-700	6	8	MILE MARKER			+	+	+											SALVAGE AND MOUNT ON NEW POST BELOW SPEED LIMIT						
SIGN SUMMARY SHEET							SHEET TOTALS	28.67	0.00	1	2	2	8	0	0	6	90.0	0	0.0	0.0	0.0	0.0	PROJECT NAME: CALAIS - GREENSBORO PROJECT NUMBER: STPG SING (50)						
VERMONT AGENCY OF TRANSPORTATION							TOWN DIRECTIONAL TOTALS	174.0	0.0	16	10	7	51	0	0	37	555.0	0		0.0			FILE NAME: 05 HARDWICK VT-14 NB TSS.; PLOT DATE: 5/19/2015 PROJECT MANAGER: D. BRYANT; DRAWN BY: J. BLANCHARD DESIGNED BY: J. BLANCHARD; CHECKED: K. KERN HARDWICK NB SHEET 2; SHEET 44 OF 66						