



STATE OF VERMONT AGENCY OF TRANSPORTATION

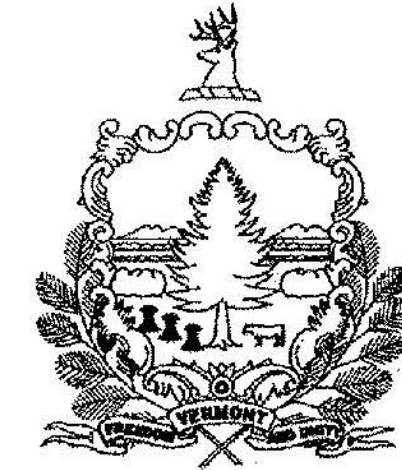

PROPOSED IMPROVEMENT TOWN OF WOODSTOCK COUNTY OF WINDSOR VT ROUTE 12 (MAJOR COLLECTOR)

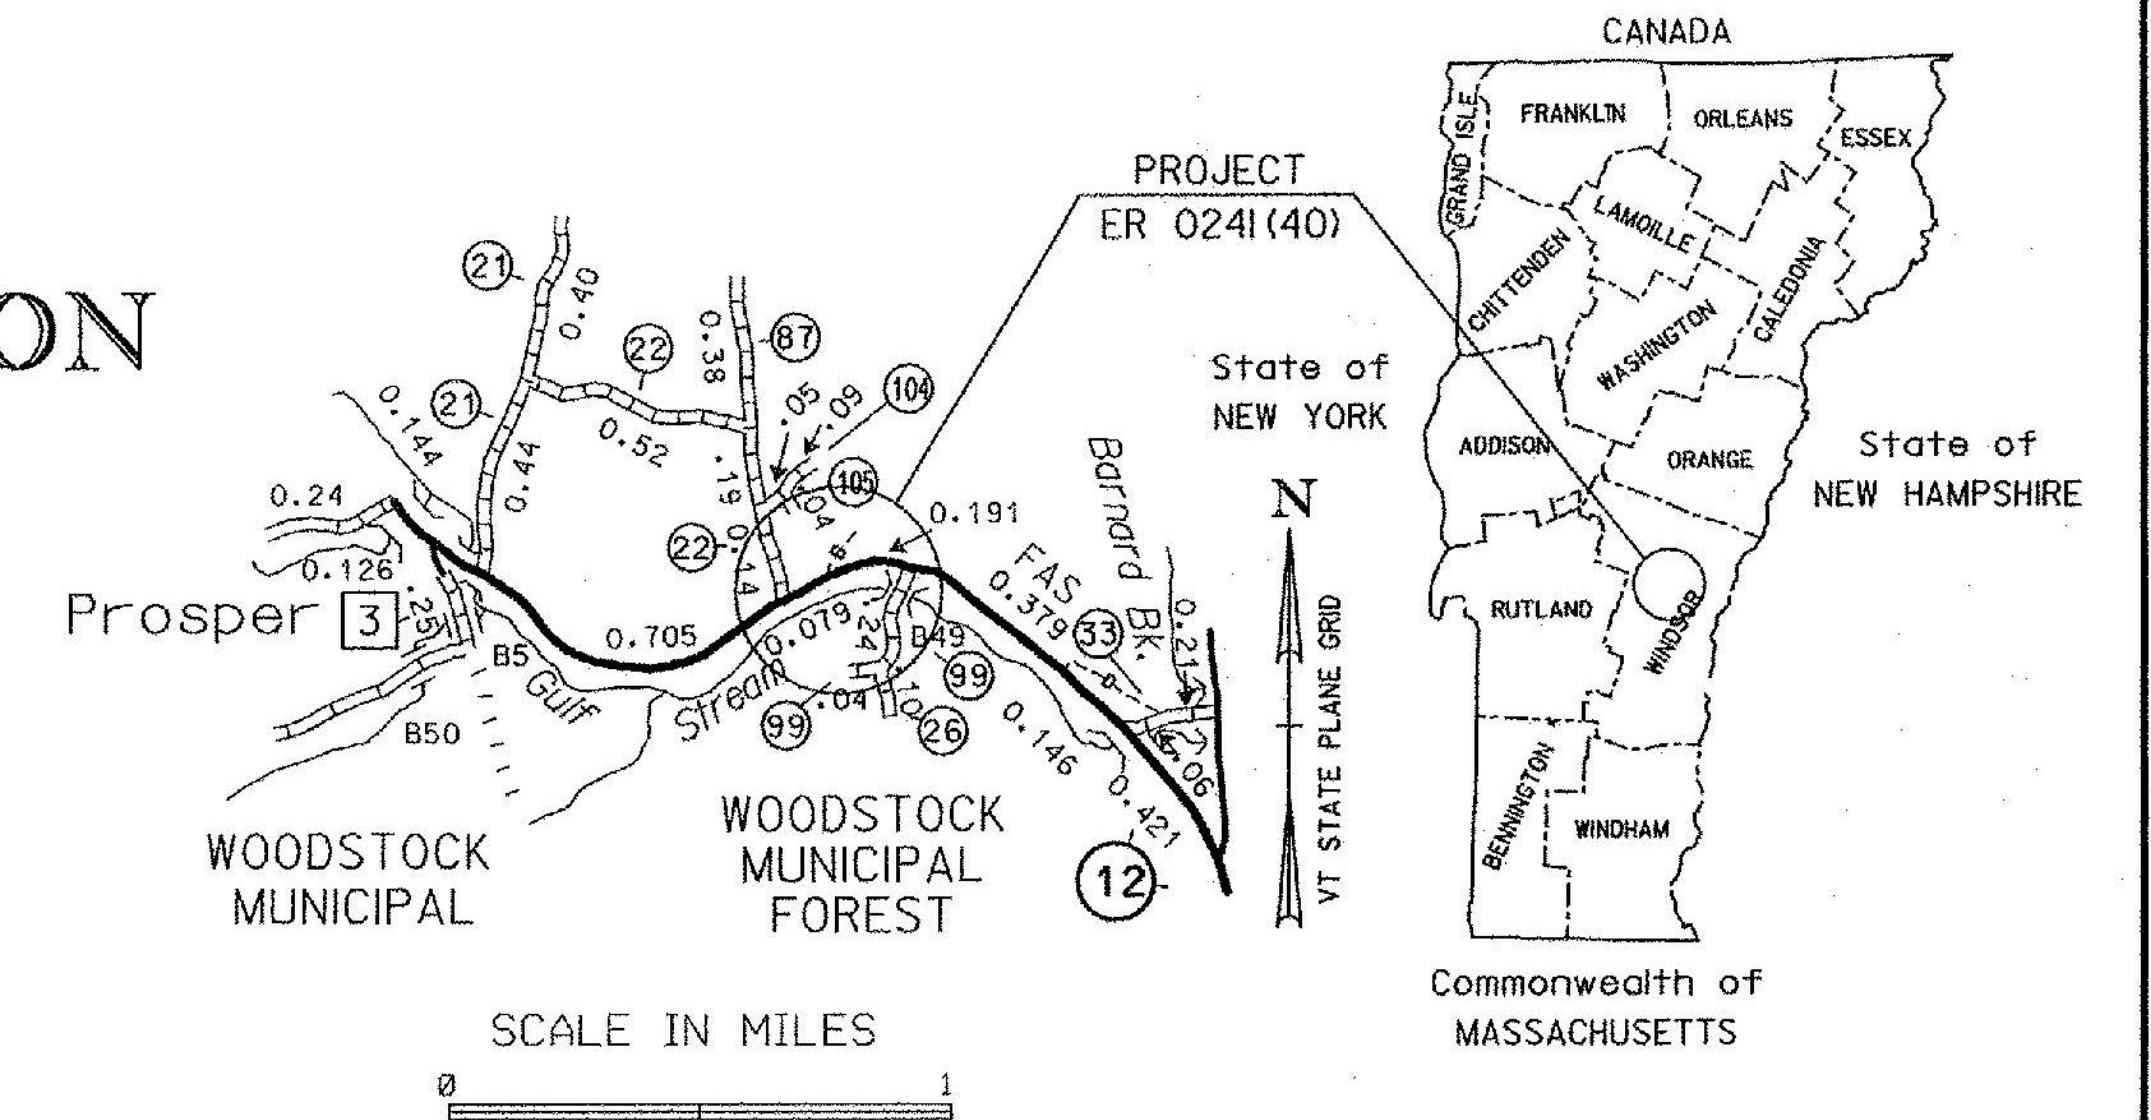


RECORD PLANS	
CONTRACTOR:	BAZIN BROTHERS, INC - WESTMINSTER, VT
RESIDENT ENGINEER:	DARYL BASSETT
CONSTRUCTION BEGAN:	AUGUST 24, 2015
CONSTRUCTION COMPLETE:	OCTOBER 23, 2015
RECORD PLANS BY:	DARYL BASSETT & KEVIN KING
I HEREBY CERTIFY THAT ALL THE CONSTRUCTION REQUIRED BY THIS SET OF DRAWINGS HAS BEEN ACCOMPLISHED AS INDICATED HEREIN.	
BY:	<i>[Signature]</i> RESIDENT ENGINEER
DATE:	March 20, 2017
NOTE: Any further information concerning final quantities, amounts or other details relative to this project may be found at Central Files in the electronic archives.	

PROJECT LOCATION: BEGINNING IN THE TOWN OF WOODSTOCK ON VT ROUTE 12 APPROXIMATELY 0.09 MILE NORTHEAST OF THE VT ROUTE 12/GULLY ROAD INTERSECTION AT STATION 113+75.00 (MM 2.154) AND EXTENDING NORTHERLY ALONG VT ROUTE 12 350.00 FEET (0.066 MILES) TO STATION 117+25.00 (MM 2.220).

LENGTH OF PROJECT: 350.00 FEET = 0.066 MILES



PROJECT DESCRIPTION: WORK TO BE PERFORMED UNDER THIS PROJECT CONSISTS OF RECONSTRUCTING THE SOUTHERLY SIDESLOPE AND RIVERBED, REMOVING AND REPLACING GUARDRAIL, COLD PLANING, PAVING, AND OTHER HIGHWAY RELATED ITEMS.

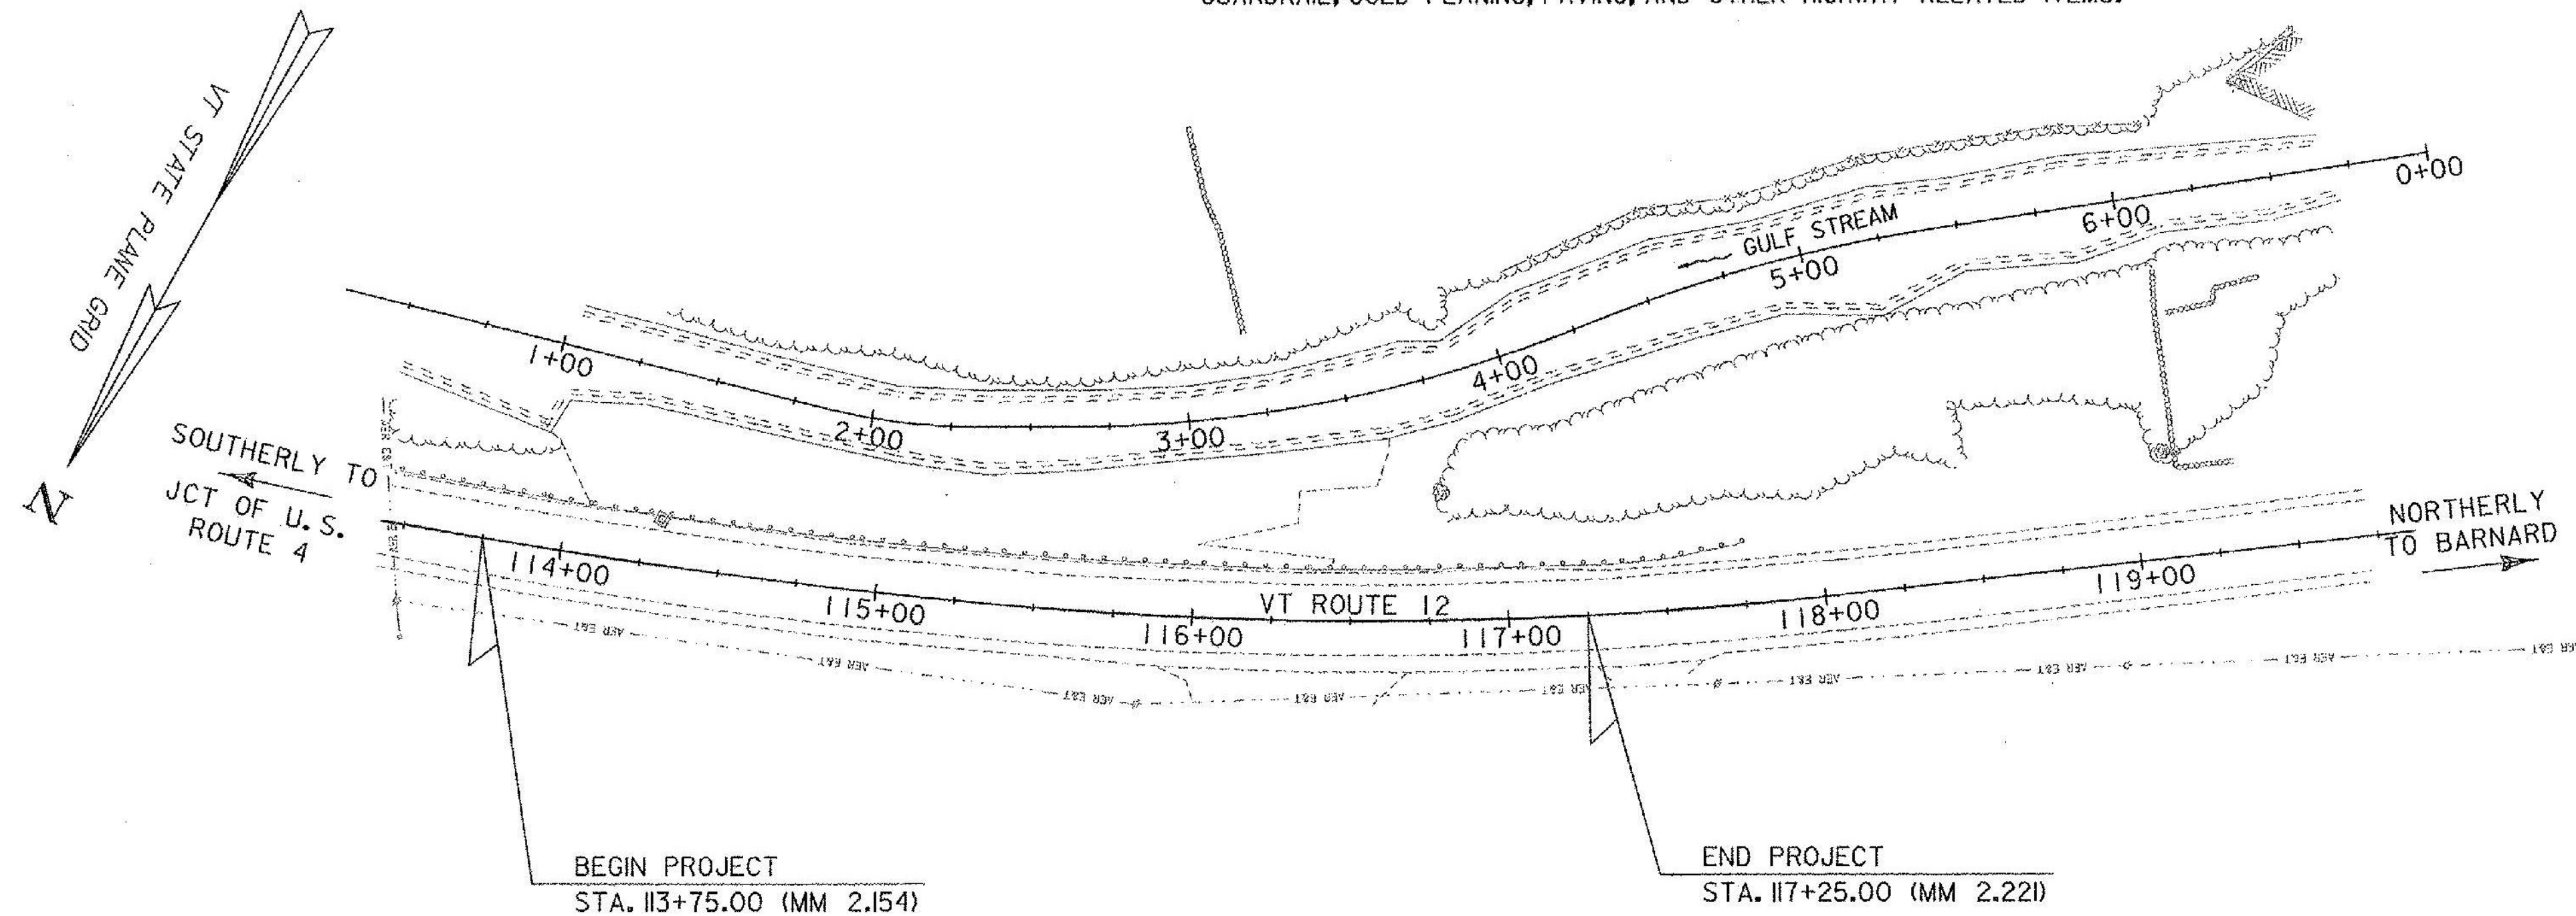

TRAFFIC DATA	
2015 AADT	2000
2025 AADT	2100
2025 DHV	250
%D	61
%T	5.0
DESIGN SPEED	50 MPH
2015~2025 ESAL	242,000
2015~2035 ESAL	545,000
POSTED SPEED	50MPH

CONSTRUCTION IS TO BE CARRIED ON IN ACCORDANCE WITH THESE PLANS AND THE STANDARD SPECIFICATIONS FOR CONSTRUCTION DATED 2011, AS APPROVED BY THE FEDERAL HIGHWAY ADMINISTRATION ON JULY 20, 2011 FOR USE ON THIS PROJECT, INCLUDING ALL SUBSEQUENT REVISIONS AND SUCH REVISED SPECIFICATIONS AND SPECIAL PROVISIONS AS ARE INCORPORATED IN THESE PLANS.

QUALITY ASSURANCE PROGRAM : LEVEL 2	
SURVEYED BY :	VERMONT SURVEY AND ENGINEERING, INC.
SURVEYED DATE :	6/2013
DATUM	
VERTICAL	NAVD 88 (GEOID12A) FT
HORIZONTAL	NAD 83 (2011) sFT

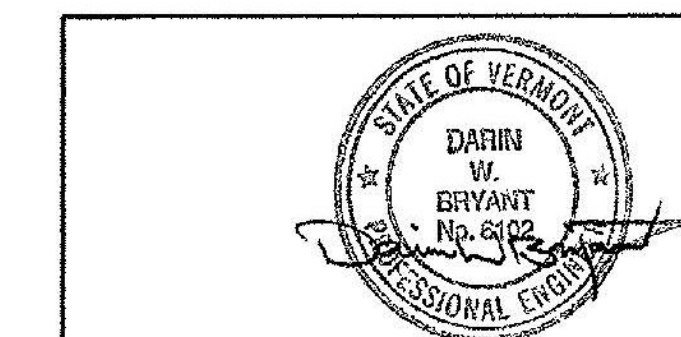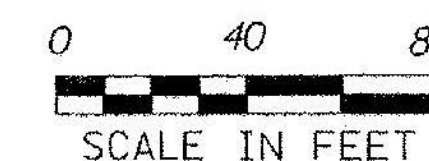

TYLIN INTERNATIONAL

DIRECTOR OF PROJECT DELIVERY	
APPROVED:	<i>[Signature]</i> DATE 2/11/2015
PROJECT MANAGER : PAUL LIBBY	
PROJECT NAME : WOODSTOCK	
PROJECT NUMBER : ER 0241(40)	
SHEET 1 OF 27 SHEETS	